


37204

8030

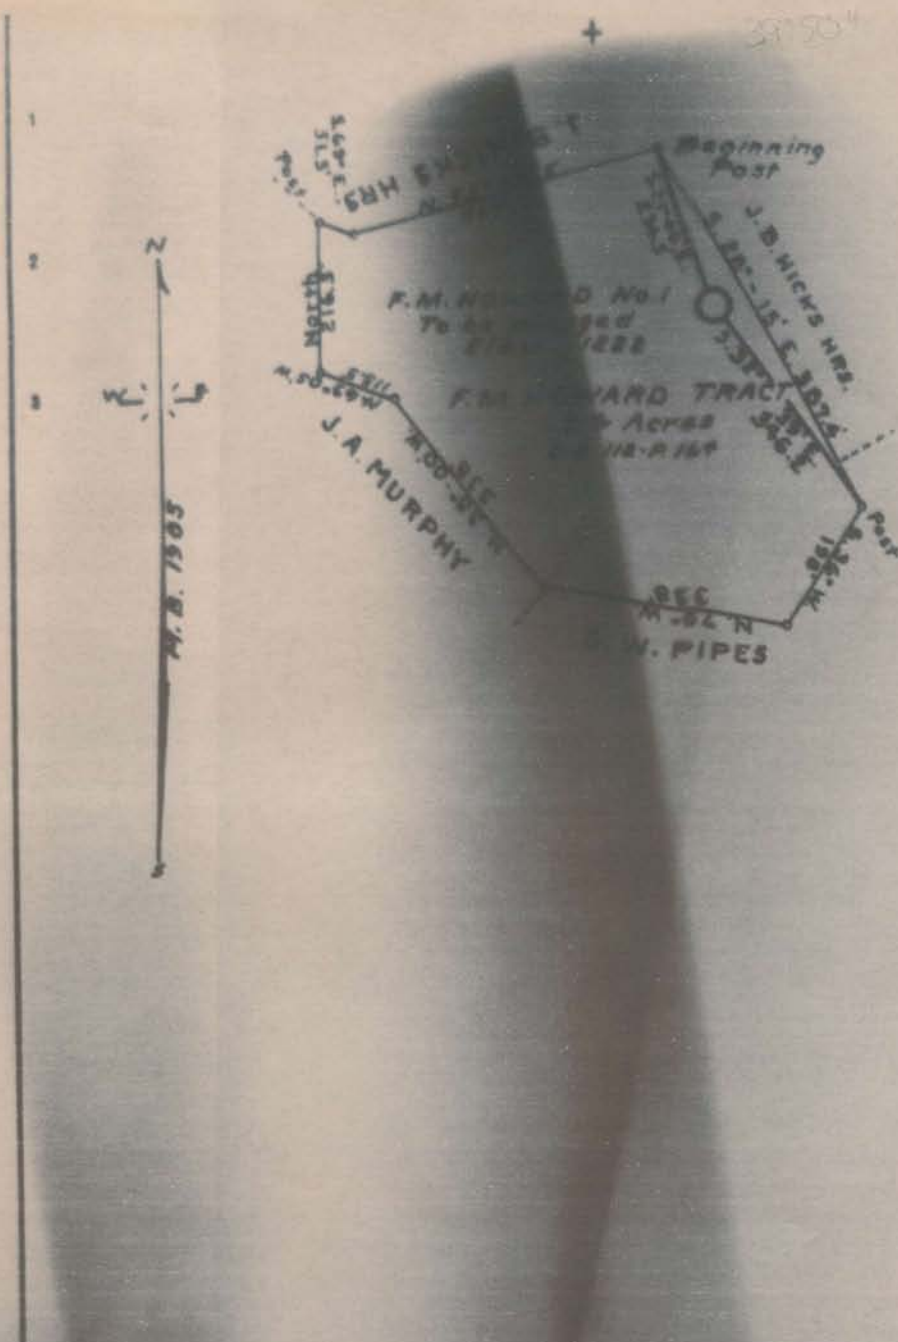

Company SHY & A. G. PATTERSON
 Address CAMERON, W. VA.
 Farm F. M. HOWARD
 Tract 2.4 Acres 2.4 Lease No. _____
 Well No. 1 Serial No. _____
 District CAMERON

STATE OF WEST VIRGINIA
 DEPARTMENT OF MINES
 OIL AND GAS DIVISION
 CHARLESTON

WELL LOCATION MAP
 FILE NO. MARS-67 A

30067

WEST VIRGINIA DEPARTMENT OF MINES
OIL AND GAS DIVISION

F. M. Howard
COAL OPERATOR OR OWNER
New Smyrna, Florida.
ADDRESS

Guy B. & A. G. Patterson
COAL OPERATOR OR OWNER
Cameron, West Va.
COMPLETE ADDRESS

COAL OPERATOR OR OWNER

March 6, 19 37,
WELL AND LOCATION

ADDRESS

Cameron Corporation (Cameron) District

LEASE OR PROPERTY OWNER

Marshall County

ADDRESS

Well No. 1

F. M. Howard Farm

AFFIDAVIT TO BE MADE IN TRIPLICATE, ONE COPY TO BE MAILED BY REGISTERED MAIL TO THE DEPARTMENT, ONE COPY TO BE RETAINED BY THE WELL OPERATOR AND THE THIRD COPY (WHICH EXTRA COPIES IF REQUIRED) TO BE MAILED TO EACH COAL OPERATOR ABOVE NAMED AT THEIR RESPECTIVE ADDRESSES

AFFIDAVIT

STATE OF WEST VIRGINIA,

COUNTY OF Marshall

DO:

D. A. Bonar and Richard Marling

being first duly sworn according to law depose and say that they are experienced in the work of plugging

and filling oil and gas wells and were employed by Guy B. & A. G. Patterson, well operator, and participated in the work of plugging and filling the above well, that said work was commenced on the

29th day of December, 19 36, and that the well was plugged and filled in the following manner:

Manner in which sand was plugged:
Red mud 3039 to 2822; Wood plug 2822-2819; Cement 2819-2809, sealing 50 foot, Gordon Stray, 4th and 5th sands; Red mud 2809-2050; Wood plug 2050-2047; Red mud 2047-1650; Cement 1650-1640, sealing gas sand and salt sand; red mud 1640-1320; Wood plug 1320-1317; Red mud 1317-1255; Cement 1255-1245; Red mud 1245-925.

Manner in which coal was plugged:

Cement 925-885; Red mud 885-820; Cement 820-765; Red mud 765-623; Cement 623-570; Red mud 570 to surface.

Description of monument:

Permanent marker as described in Rule 18, 1931 Regulations.

(THE ABOVE DESCRIPTION MUST BE IN DETAIL AND IN ACCORDANCE WITH THE PROVISIONS OF SECTION 10, ARTICLE 4, CHAPTER 22 OF THE CODE)

and that the work of plugging and filling said well was completed on the 7 day of February

19 37.

And further deponents saith not.

D. A. Bonar

Richard Marling

sworn to and subscribed before me this 6th day of March 19 37.

