

Company I H BEREN
 Address MARIETTA OHIO
 Farm J J KLUG
 Tract ONE Acres 119 Lease No. _____
 Well (Farm) No. 3 Serial No. 143
 Elevation (Spirit Level) 1120'
 Quadrangle LITTLETON NW
 County MARSHALL District MEADE
 Engineer F.W. PARSONS
 Engineer's Registration No. 203
 File No. _____ Drawing No. _____
 Date 5/10/39 Scale 1" = 30 Feet

STATE OF WEST VIRGINIA
 DEPARTMENT OF MINES
 OIL AND GAS DIVISION
 CHARLESTON

WELL LOCATION MAP
 FILE NO. MARS-105A

+ Denotes location of well on United States Topographic Maps, scale 1 to 62,500, latitude and longitude lines being represented by border lines as shown.

- Denotes one inch spaces on border line of original tracing.

STATE OF WEST VIRGINIA
DEPARTMENT OF MINES
OIL AND GAS DIVISION

164

WELL RECORD

Permit No. MAR 5-105-A


Oil or Gas Well Oil
(Kind)

Company I. H. Beren
Address Marietta, Ohio
Farm Jos. Klug Acres 120
Location (waters) _____
Well No. 143 Elev. _____
District Meade County Marshall
The surface of tract is owned in fee by Jos. Klug
Address St. Joseph, W. Va.
Mineral rights are owned by Same
Address _____
Drilling commenced _____
Drilling completed _____
Date shot _____ Depth of shot _____
Open Flow /10ths Water in _____ Inch
/10ths Merc. in _____ Inch
Volume _____ Cu. Ft.
Rock Pressure _____ lbs. _____ hrs.
Oil _____ bbls., 1st 24 hrs.
Fresh water _____ feet _____ feet
Salt water _____ feet _____ feet

Casing and Tubing	Used in Drilling	Left in Well	Packers
Size			Kind of Packer
16			<u>Disk Wall</u>
13			Size of
10	<u>1275</u>	<u>---</u>	<u>5-3/16"</u>
8 1/4	<u>1335</u>	<u>---</u>	Depth set <u>1998'</u>
6 5/8	<u>1945</u>	<u>1945</u>	
5 3/16		<u>1998</u>	
3			Perf. top
2		<u>2898</u>	Perf. bottom
Liners Used			Perf. top
			Perf. bottom

CASING CEMENTED _____ SIZE _____ No. FT. _____ Date _____
COAL WAS ENCOUNTERED AT 765 FEET 60 INCHES
868 FEET 84 INCHES FEET INCHES
FEET INCHES FEET INCHES

Formation	Color	Hard or Soft	Top	Bottom	Oil Gas or Water	Depth Found	Remarks
Mapletown Coal			765	770			
Pittsburgh Coal			868	875			
Gas Sand			1558	1620			
Salt Sand			1670	1820			
Maxon Sand			1840	1860			
Big Lime			1925	1970			
Big Injun			1985	2310			
Berea Grit			2590	2615			
Gordon Stray			2834	2841			
Gordon Sand			2862	2881			
Bottom of Well				2898			
Pay in Sand			2866				

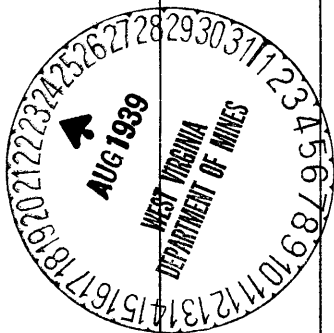

Formation	Color	Hard or Soft	Top	Bottom	Oil, Gas or Water	Depth Found	Remarks

Date Aug 22, 1934

APPROVED J. B. Beiler, Owner

By _____, (Title)

125A

Marble District, Marshall County, W. Va.

By I. H. Bowen, Marietta, Ohio.

On 120 acres.

Abandoned under permit No. 113-.....

Elevation.....

Surfaces and minerals owned by Joe. King, St. Joseph, W. Va.

10" casing, 1171'; 8", 135'; 6", 1915'; 5", 1998'; 2" tubing, 2698'; 10" & 8" Pelled.

Disk well packer, 3", set at 1998'.

Coal was encountered at 765-770 and 866-875'.

Oil well. Abandonment reported to Dept. of Mines Aug. 22, 1939.

Reamed to 1672 from Mrs. Griffith August 24, 1939.

	Top.	Bottom.
Highstown (Sensibility) Coal	765	770
Highstown Coal	866	875
One Sand	1558	1620
Split Sand	1670	1820
Heater Sand	1840	1860
Big Lane	1925	1970
Big Injun Sand	1985	2310
Bowen Grit	2330	2615
Golden Shiny Sand	2674	2684
Golden Sand (pay in sand, 2666')	2682	2688
Total depth		2698