


39° 45' 00"

Latitude

80° 42' 30"

Longitude

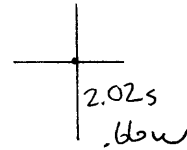

Topo Location

7.5' Loc. _____ 15' Loc. _____
 _____ (calc.) _____

Company I H Benson

Farm Joseph Hohmann # 138

15' Quad _____
(sec.)

7.5' Quad Wileyville


District Meade

Plots in Wetzel Co

WELL LOCATION PLAT

County OS Permit 30113

see plat 3011

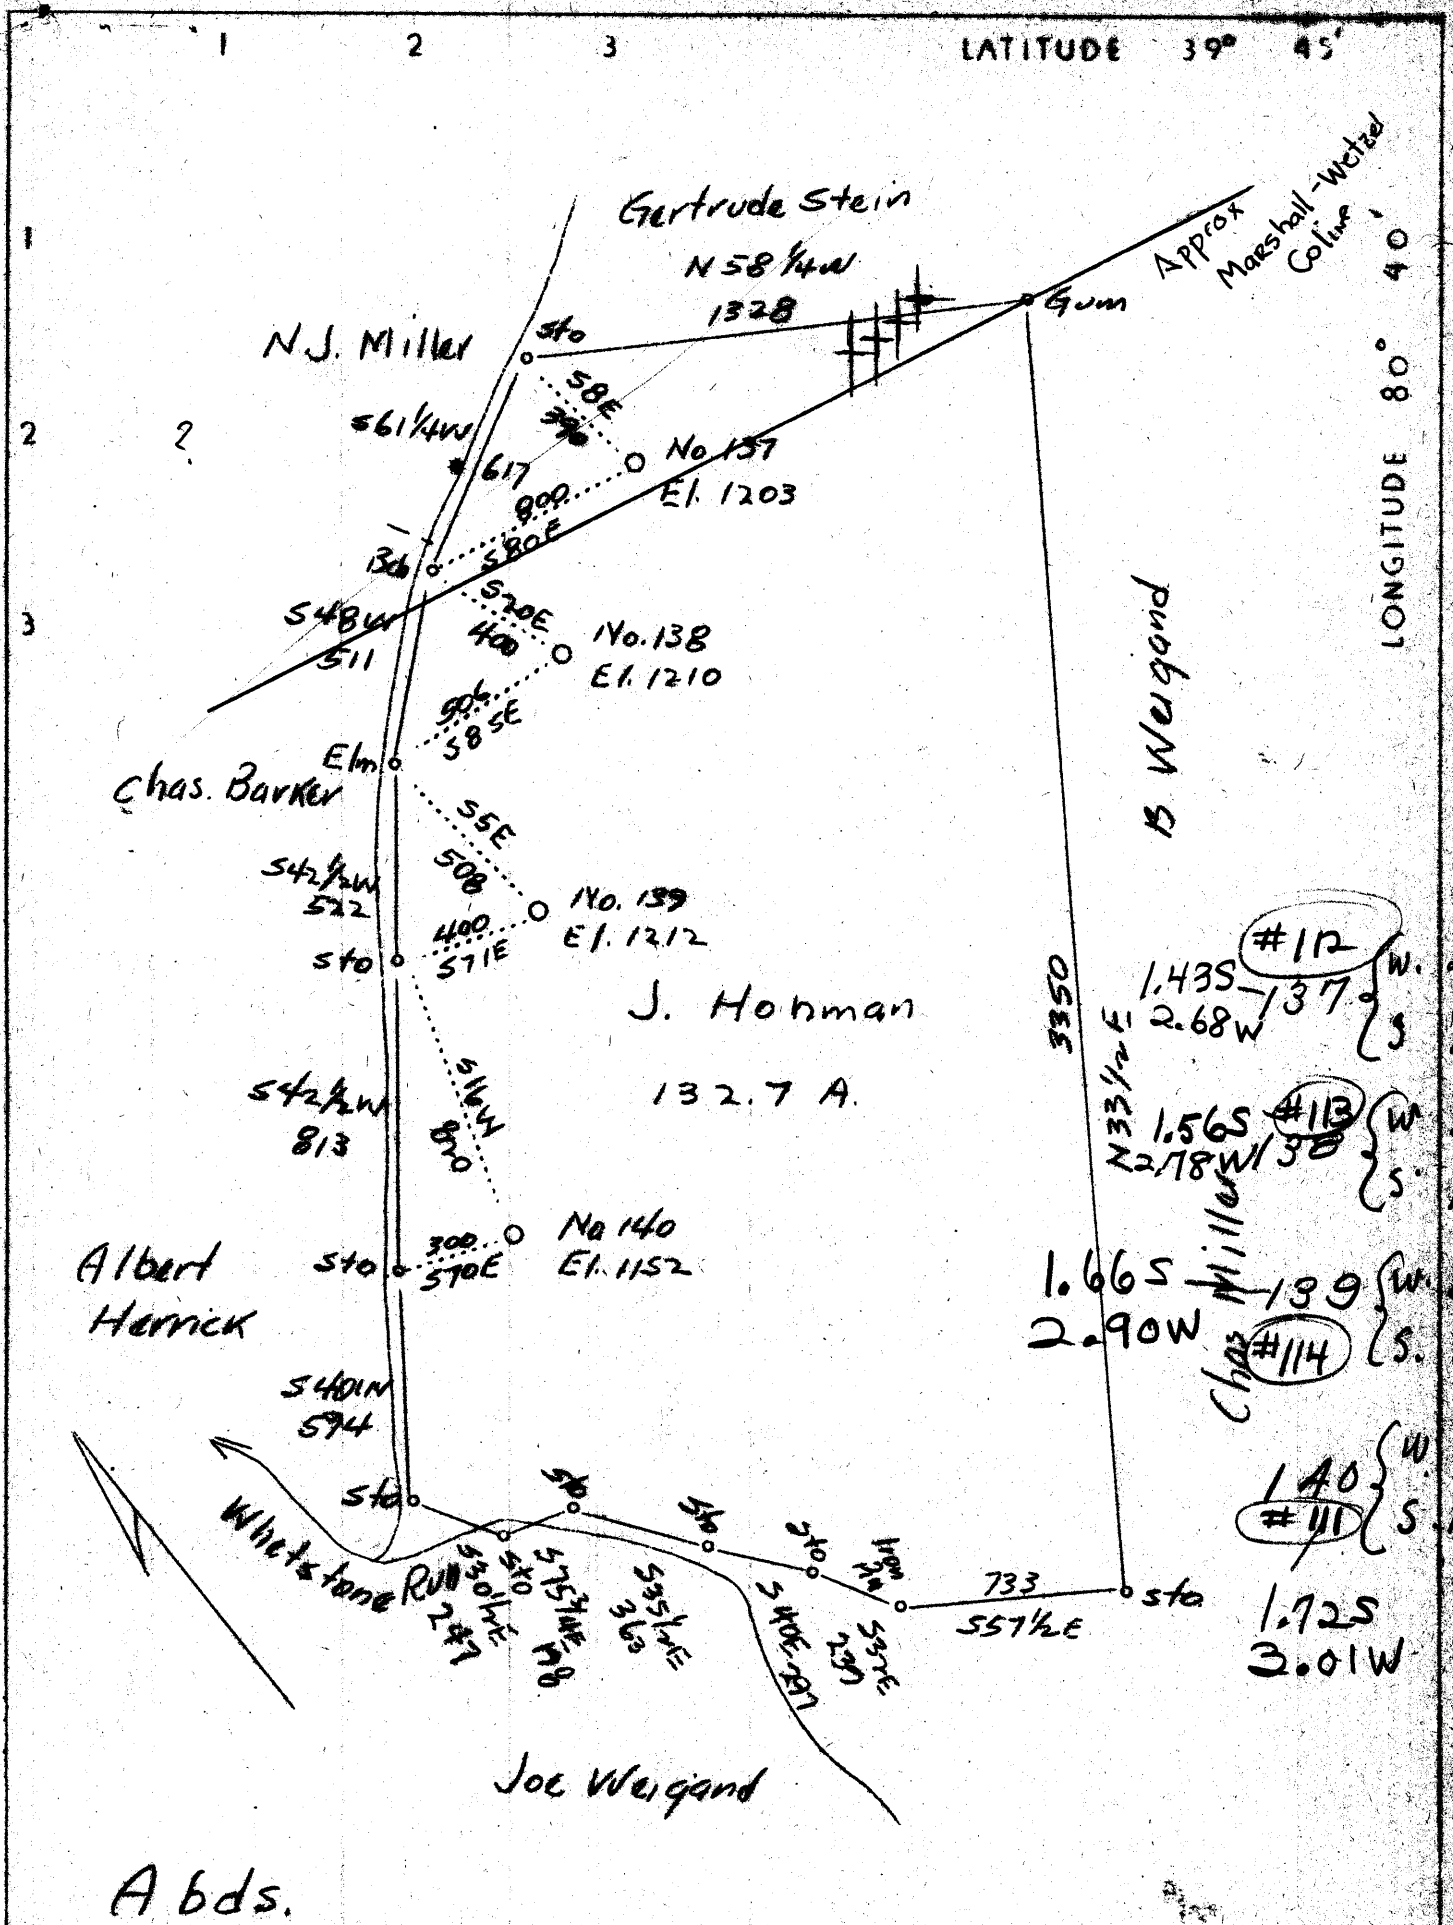

A bds.

Company	I. H. Beren
Address	Box 73, Marietta, Ohio.
Farm	Joseph Hohman
Acres	132.7
Well (Farm) No.	137, 138, 139, 140
Elevation (SL)	1203, 1210, 1212, 1152
Quadrangle	Littleton N.W.
County	Marshall
District	Meade
Engineer	G. O. Gerwig
Eng. Reg. No.	811
Date	Sept. 19, 1939
Scale	1" = 500'

STATE OF WEST VIRGINIA
Department of Mines
OIL & GAS DIVISION
Charleston

WELL LOCATION MAP

File No. MARS-111-112-113-114

x Denotes location of well on U. S. Topographic Maps, scale 1 to 62,500, latitude and longitude lines being represented by border lines as shown.

• Denotes one inch spaces on border line of original tracing.

STATE OF WEST VIRGINIA
DEPARTMENT OF MINES
OIL AND GAS DIVISION

781

WELL RECORD

Permit No. **113A**

Oil or Gas Well **Oil**
(Kind)

Company **I. H. Boren**
 Address **Marietta, Ohio**
 Farm **Gertrude Hawk** Acres **130**
 Location (waters) _____
 Well No. **138** Elev. **1210**
 District **Proctor** County **Putnam**
 The surface of tract is owned in fee by **Joseph Hohman**
 Address **St. Joseph, W. Va.**
 Mineral rights are owned by **Joseph Hohman**
 Address **St. Joseph, W. Va.**
 Drilling commenced _____
 Drilling completed _____
 Date shot _____ Depth of shot _____
 Open Flow /10ths Water in _____ Inch
 /10ths Merc. in _____ Inch

Casing and Tubing	Used in Drilling	Left in Well	Packers
Size			
16.			Kind of Packer
13.			Disk Wall
10.	1200	--	Size of 5-3/16" x
8 1/4	1409	--	6-5/8"
6 5/8	2267	2267	Depth set
5 3/16		665	
3.			Perf. top
2.		2944	Perf. bottom
Liners Used			Perf. top
			Perf. bottom

Volume _____ Cu. Ft. CASING CEMENTED _____ SIZE _____ No. FT. _____ Date _____
 Rock Pressure _____ lbs. _____ hrs.
 Oil _____ bbls., 1st 24 hrs. COAL WAS ENCOUNTERED AT **834** FEET **60** INCHES
 Fresh water _____ feet _____ feet **930** FEET **84** INCHES FEET INCHES
 Salt water _____ feet _____ feet FEET INCHES FEET INCHES

Formation	Color	Hard or Soft	Top	Bottom	Oil Gas or Water	Depth Found	Remarks
Mapletown Coal			834	839			
Pittsburgh Coal			930	937			
Marysby Sand			990	1020			
Big Dunkard Sand			1485	1500			
Salt Sand			1750	1800			
Maxon Sand			1816	1835			
Big Lime			1972	2000			
Big Injun			2000	2290			
Gantz Sand			2310	2320			
Berea Grit			2445	2454			
Gordon Stray			2685	2686			
Gordon Sand			2921	2935			
Bottom of Well				2944			

