

COAL OWNED BY
STATE OF WEST VIRGINIA

- New Location...
- Drill Deeper...
- Abandonment...

1.375
3.50W

3.57W
1.39

JAN 23 1940

Company THE MANUFACTURERS LIGHT & HEAT COMPANY
 Address 300 UNION TRUST BLDG - PITTSBURGH PA.
 Farm Y.W. & HENRIETTA MCKIMMIE
 Tract Acres 186.40 Lease No. 2855
 Well (Farm) No. 2. Serial No. 1270
 Elevation (Spirit Level) 1082'
 Quadrangle LITTLETON - N.W. 1/4.
 County MARSHALL District FRANKLIN
 Engineer *Porter J. Cook*
 Engineer's Registration No.
 File No. Drawing No. YB-586
 Date DECEMBER 27, 1939 Scale 1" = 800'

STATE OF WEST VIRGINIA
 DEPARTMENT OF MINES
 OIL AND GAS DIVISION
 CHARLESTON

WELL LOCATION MAP
 File No. *MARS-123A*

- + Denotes location of well on United States Topographic Maps, scale 1 to 62,500, latitude and longitude lines being represented by border lines as shown.
- Denotes one inch spaces on border line of original tracing.

STATE OF WEST VIRGINIA
DEPARTMENT OF MINES
OIL AND GAS DIVISION

177

Mas-123K **WELL RECORD**

Permit No. Drilled in 1905

Oil or Gas Well Gas
(Kind)

Company The Mfrs. Light & Heat Co.
 Address 800 Union Trust Bldg., Pittsburgh, Pa.
 Farm Y. W. McKimmie Acres 200
 Location (waters) _____
 Well No. 2 - 1270 Elev. 1082 ft
 District Franklin County Marshall
 The surface of tract is owned in fee by Henrietta McKimmie
RD 1, Box 77, Address Proctor, W. Va.
 Mineral rights are owned by The Mfrs. Light & Heat Co.
800 Union Trust Bldg Address Pittsburgh, Pa.
 Drilling commenced June 22, 1905
 Drilling completed Sept 21, 1905
 Date shot _____ Depth of shot _____
 Open Flow /10ths Water in _____ Inch
 /10ths Merc. in _____ Inch


Casing and Tubing	Used in Drilling	Left in Well	Packers
Size			
16			Kind of Packer
13			
10	1260	1260	Size of
8 1/4	1385		<u>3x6x16</u>
6 5/8	2335	2335	Depth set
5 3/16			<u>2706</u>
3		2989	Perf. top
2			Perf. bottom
Liners Used			Perf. top
			Perf. bottom

Volume _____ Cu. Ft.
 Rock Pressure 285 lbs _____ hrs.
 Oil _____ bbls., 1st 24 hrs.
 Fresh water _____ feet _____ feet
 Salt water _____ feet _____ feet

CASING CEMENTED _____ SIZE _____ No. FT. _____ Date _____
 COAL WAS ENCOUNTERED AT 878 FEET 72 INCHES
968 FEET 60 INCHES FEET INCHES
 FEET INCHES FEET INCHES

Formation	Color	Hard or Soft	Top	Bottom	Oil Gas or Water	Depth Found	Remarks
Mapletown Coal			878	884			
Pittsburgh Coal			968	973			
Little Dunkard			1368				
Big Dunkard			1443				
Big Lime			2047	2093			
Big Injun			2093	2335			
Berea Grit			2702	2714			
Gordon Sand			2973	2989	Gas		
Total depth				3045			

Dry well

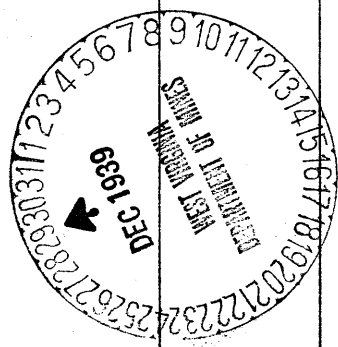

Formation	Color	Hard or Soft	Top	Bottom	Oil, Gas or Water	Depth Found	Remarks

Date December 28th, 1929

APPROVED THE MANUFACTURERS LIGHT & HEAT CO, Owner

By Samy H. Fowler
Land Dept. (Title) Office Manager