

Wm. Porter Heirs

N 45 E - 2090

Stone

R.A. & J.S. Marple - formerly Alex Reynolds Heirs - present
100 Acres
Coal 1st - 4th

Well No. 100
El. 1316

Ridge Road

S 45 E - 2090

Albert Clark

Ed Clark

Well No. 99
El. 1135

N 54 E - 1810

Stone

S 45 W - 2090

Albert Clark

#99 1.26 W
3.10

1.47

3.44 S

3.5 A 1.43 W

#100

DEC - 9 1940

New Location
Drill Deeper
Abandonment

Company The Interstate Pipe & Supply Co.
 Address Box 611, Marietta Ohio
 Farm R.A. & J.S. Marple
 Tract _____ Acres 100 Lease No. _____
 Well (Farm) No. 99 & 100 Serial No. _____
 Elevation (Spirit Level) 1135.0 & 1316.0
 Quadrang' Cameron
 County MARSHALL District LIBERTY
 Engineer C.O. Newing
 Engineer's Registration No. 811
 File No. _____ Drawing No. _____
 Date Nov 23 1940 Scale 1" = 500'

STATE OF WEST VIRGINIA
 DEPARTMENT OF MINES
 OIL AND GAS DIVISION
 CHARLESTON

WELL LOCATION MAP
 FILE NO. MARS-146A
 WELL 100

+ Denotes location of well on United States Topographic Maps, scale 1 to 62,500, latitude and longitude lines being represented by border lines as shown.
 - Denotes one inch spaces on border line of original tracing.

WEST VIRGINIA DEPARTMENT OF MINES
OIL AND GAS DIVISION

196

WELL RECORD

AP 146-A
Permit No. _____


Oil or Gas Well Oil
(Kind)

Company The Interstate Pipe & Supply Company
Address Marietta, Ohio
Farm R. A. and J. S. Marple Acres 110
Location (waters) _____
Well No. 100 Elev. 1316
District Liberty County Marshall
The surface of tract is owned in fee by R. A. & J. S. Marple
Address Cameron, W. Va.
Mineral rights are owned by _____
Address _____
Drilling commenced March 30, 1927
Drilling completed June 3, 1927
Date shot _____ Depth of shot _____
Open Flow _____ /10ths Water in _____ Inch
_____ /10ths Merc. in _____ Inch
Volume _____ Cu. Ft.
Rock Pressure _____ lbs. _____ hrs.
Oil _____ bbls., 1st 24 hrs.
Fresh water _____ feet _____ feet
Salt water _____ feet _____ feet

Casing and Tubing	Used in Drilling	Left in Well	Packers
Size			
Conductor	16	16	Kind of Packer _____
13			
10	184	184	Size of _____
8 1/4	1541	1541	
6 5/8	2055	2055	Depth set _____
5 3/16			
3			Perf. top _____
2			Perf. bottom _____
Liners Used _____			Perf. top _____
			Perf. bottom _____

CASING CEMENTED _____ SIZE _____ No. FT. _____ Date _____
COAL WAS ENCOUNTERED AT 765 FEET 72 INCHES
765 FEET 48 INCHES 965 FEET 48 INCHES
1060 FEET 84 INCHES _____ FEET _____ INCHES

Formation	Color	Hard or Soft	Top	Bottom	Oil Gas or Water	Depth Found	Remarks
Bluff Sand			725	765			
Waynesburg Coal			765	769			
Mapletown Coal			965	971			
Pittsburgh Coal			1060	1067			
Murphy Sand			1250	1280	Hole full water	1275	
Salt Sand			1960	2020	Hole full water	1965	
Maxon Sand			2105	2135			
Big Lime			2152	2205			
Big Injun Sand			2205	2465			
Sand			2605	2620			
Sand			2805	2825			
Pink Rock			2905	2945			
Gordon Sand			3060	3085	Oil at	3062	
Total Depth				3085			
June 6, 1927 shot with 30 qts. in Gordon Sand 3061-3070							

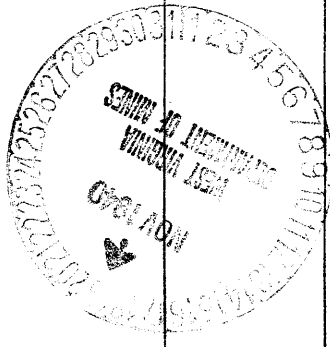

Formation	Color	Hard or Soft	Top	Bottom	Oil, Gas or Water	Depth Found	Remarks

Date Nov. 18, 1940

APPROVED The Interstate Pipe Supply Co. Owner

By W. A. Beren (Title) Manager