

New Location
 Drill Deeper
 Abandonment

OCT 26 1941

Company The Interstate Pipe & Supply Co.
 Address P.O. Box - 611 Marietta Ohio
 Farm J. B. & S. M. Winters
 Tract _____ Acres 50 Lease No. _____
 Co. Nos 119 120 121
 Well (Farm) No. one, two, three Serial No. _____
 Elevation (Spirit Level) 1335.0 - 1225.0 - 1219.0
 Quadrangle Littleton
 County Marshall District Liberty
 Engineer C. O. Herwig
 Engineer's Registration No. 811
 File No. _____ Drawing No. _____
 Date Jan. 4 1941 Scale 1" = 300'

STATE OF WEST VIRGINIA
 DEPARTMENT OF MINES
 OIL AND GAS DIVISION
 CHARLESTON

WELL LOCATION MAP
 FILE NO. MARS-168A
 119

+ Denotes location of well on United States Topographic Maps, scale 1 to 62,500, latitude and longitude lines being represented by border lines as shown.

- Denotes one inch spaces on border line of original tracing.

J. B. & S. M. WINTERS No. 1 (119) - INTERSTATE PIPE & SUPPLY CO. - MARS-168-A

STATE OF WEST VIRGINIA
DEPARTMENT OF MINES
OIL AND GAS DIVISION

WELL RECORD

224

Ab 168-A
Permit No. 168-A


Oil or Gas Well 941
(KIND)

Company The Interstate Pipe & Supply Company
Address Marietta, Ohio
Farm J. B. & S. M. Winters Acres 50
Location (waters) (1)
Well No. 119 Elev. 1335.10
District Liberty County Marshall
The surface of tract is owned in fee by Pearl M. Kukie
Address _____
Mineral rights are owned by Pearl M. Kukie
Address _____
Drilling commenced September 3, 1918
Drilling completed October 10, 1918
Date shot _____ Depth of shot _____
Open Flow _____ /10ths Water in _____ Inch
_____ /10ths Merc. in _____ Inch
Volume _____ Cu. Ft.
Rock Pressure _____ lbs. _____ hrs.
Oil _____ bbls., 1st 24 hrs.
Fresh water _____ feet _____ feet
Salt water _____ feet _____ feet

Casing and Tubing	Used in Drilling	Left in Well	Packers
Size			
Conductor	15	15	Kind of Packer
13			
10	424	---	Size of
8 1/4	1607	1607	
6 5/8	2311	2311	Depth set
5 3/16			
3			Perf. top
2			Perf. bottom
Liners Used			Perf. top
			Perf. bottom

CASING CEMENTED _____ SIZE _____ No. Ft. _____ Date _____
COAL WAS ENCOUNTERED AT 1026 FEET 4 INCHES
1120 FEET 84 INCHES FEET INCHES
FEET INCHES FEET INCHES

Formation	Color	Hard or Soft	Top	Bottom	Oil, Gas or Water	Depth Found	Remarks
Completown Coal			1026	1030			
Pittsburgh Coal			1120	1127			
Murphy Sand			1330	1355			
Little Dunkard		none					
Big Dunkard			1610	1650			
West Salt Sand			2005	2050			
East Salt Sand			2070	2114			
Saxon Sand			2212	2262			
Red Rock			2285	2290			
Blue Monday			2290	2296			
Big Line			2296	2364			
Big Injun Sand			2364				
Total Depth				2383			
<p>All 10" casing pulled October 24, 1918, shot with 5 qt. - top of shell, 2373; bottom, 2378 October 31, shot with 8 qt. - top of shell, 2373; bottom, 2379 January 22, 1921, shot with 10 qt. - top of shell, 2373; bottom, 2380</p>							

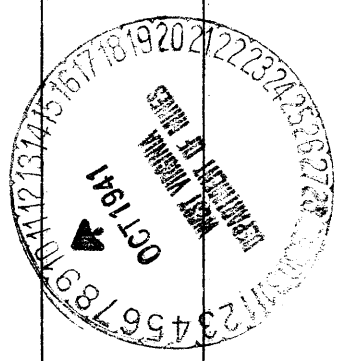

Formation	Color	Hard or Soft	Top	Bottom	Oil, Gas or Water	Depth Found	Remarks

Date.....October 9....., 1941.

APPROVED The Interstate Pipe & Supply Co. Owner

By H. H. Berena
(Title) a.

