

Company The Interstate Pipe & Supply Co.
 Address P.O. Box 611 Marietta Ohio
 Farm A.P. Pendergast
 Tract _____ Acres 49A-136P Lease No. _____
 Co. No. 104
 Well (Farm) No. one Serial No. _____
 Elevation (Spirit Level) 1312.0
 Quadrangle Cameron
 County Marshall District Liberty
 Engineer C.O. Newwig
 Engineer's Registration No. 811
 File No. _____ Drawing No. _____
 Date Dec. 20 1940 Scale 1" = 300'

STATE OF WEST VIRGINIA
 DEPARTMENT OF MINES
 OIL AND GAS DIVISION
 CHARLESTON

WELL LOCATION MAP
 FILE NO. MARS-175A

+ Denotes location of well on United States Topographic Maps, scale 1 to 62,500, latitude and longitude lines being represented by border lines as shown.
 - Denotes one inch spaces on border line of original tracing.

175A

Liberty District, Marshall County, W. Va.

By The Interstate Pipe & Supply Co., Marietta, Ohio.

Abandoned under permit Mars-----A7

On 49 acres.

Elevation,.....' L.

Surface owned by A. F. Pendergast, and minerals by T. L. Rogerson,
Moundsville, W. Va.

Drilling commenced Feb. 7, 1903; completed, July 2, 1903.

Shot June 5, 1913, at 2983-2998'.

10" casing, 1343'; 8" , 1524'; 6" , 2250'; 4" tubing, 2340'.

449 ft. of 10" casing left in well; was dropped 205 ft.

Sept. 15, 1914, tubed with 113 joints of 4" tubing.

1 - 6" x 5" Disk Wall packer; 1 - 5" x 4" swedge nipple;

1 - 6" x 4" swedge nipple; 1 set 4" tubing clamps.

Oil well. Abandonment reported to Dept. of Mines Nov. 29, 1941.

Record to RCT from Mrs. Griffith Dec. 9, 1941. Old File No. 223.

	Top.	Bottom.
Mapletown (Sevickley) Coal	884	- 890
Pittsburgh Coal	984	- 992
Murphy Sand	1000	- 1125
Little Dunkard Sand	1330	- 1350
Big Dunkard Sand	1480	- 1530
Gas Sand	1635	- 1690
Big Line	2070	- 2100
Big Injun Sand	2110	- 2380
Gordon Stray Sand	2940	- 2948
Gordon Sand, hard (oil, 2982')	2980	- 2995
Total depth		3010

STATE OF WEST VIRGINIA
DEPARTMENT OF MINES
OIL AND GAS DIVISION

273

WELL RECORD

Permit No. MARS-175-A

Oil or Gas Well Oil
(KIND)


Company The Interstate Pipe & Supply Company
Address Marietta, Ohio
Farm A. P. Pendergast Acres 49
Location (waters).....
Well No. 104 Elev.....
District Liberty County Marshall
The surface of tract is owned in fee by A. P. Pendergast
Address.....
Mineral rights are owned by T. L. Rogerson
Address Moundsville, W. Va.
Drilling commenced February 7, 1903
Drilling completed July 2, 1903
Date shot June 5, 1913 Depth of shot 2983-2998
Open Flow /10ths Water in..... Inch
/10ths Merc. in..... Inch
Volume..... Cu. Ft.
Rock Pressure..... lbs..... hrs.
Oil..... bbls., 1st 24 hrs.
Fresh water..... feet..... feet
Salt water..... feet..... feet

Casing and Tubing	Used in Drilling	Left in Well	Packers
Size			Kind of Packer.....
16.....			<u>Disk Wall</u>
13.....			Size of.....
10.....	<u>1343</u>		<u>6-5/8" x 5-3/16"</u>
8 1/4.....	<u>1524</u>	<u>---</u>	Depth set.....
6.....	<u>2250</u>		Perf. top.....
5 3/16.....			Perf. bottom.....
<u>4" Tubing</u>		<u>2340</u>	Perf. top.....
2.....			Perf. bottom.....
Liners Used.....			

CASING CEMENTED..... SIZE..... No. Ft..... Date.....
COAL WAS ENCOUNTERED AT 884 FEET 72 INCHES
984 FEET 96 INCHES FEET INCHES
FEET INCHES FEET INCHES

Formation	Color	Hard or Soft	Top	Bottom	Oil, Gas or Water	Depth Found	Remarks
Mapletown Coal			884	890			
Pittsburgh Coal			984	992			
Murphy Sand			1000	1125			
Little Dunkard			1330	1350			
Big Dunkard			1480	1530			
Gas Sand			1635	1690			
Big Lime			2070	2100			
Big Injun Sand			2110	2380			
Gordon Strata			2940	2948			
Gordon Sand Hard			2980	2995	Oil	2982	
Total Depth				3010			

449 ft. of 10" casing left in well was dropped 205 ft.
Sept. 15, 1914, tubed with 113 joints of 4" tubing
1 6-5/8" x 5-3/16" Disk Wall packer, 1 5-3/16" x 4"
swedge nipple, 1 6-5/8" x 4" swedge nipple, 1 set
4" Tubing Clamps.

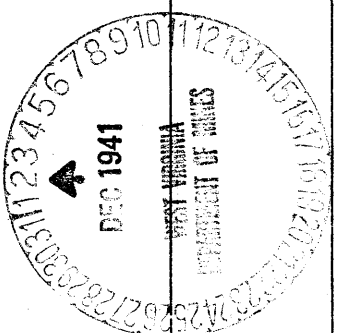

Formation	Color	Hard or Soft	Top	Bottom	Oil, Gas or Water	Depth Found	Remarks

Date..... November 29....., 194 1.

APPROVED The Interstate Pipe & Supply Co., Owner

By H. H. Beren
(Title) g.

06-10