


39°47'30"

Latitude

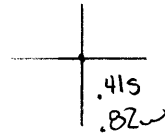

80°35'00"

Longitude

**Topo Location**

7.5' Loc. \_\_\_\_\_ 15' Loc. \_\_\_\_\_  
 \_\_\_\_\_ (calc.) \_\_\_\_\_

**Company** Interstate Pipe + Supply Co

**Farm** Robert Byppard #1

**15' Quad** \_\_\_\_\_  
(sec.)

**7.5' Quad** Cameron

**District** Liberty

**WELL LOCATION PLAT**

**County** OSI **Permit** 30176



STATE OF WEST VIRGINIA  
DEPARTMENT OF MINES  
OIL AND GAS DIVISION

217


WELL RECORD

Permit No. MARS-176A

Oil or Gas Well Oil  
(KIND)

Company <u>The Interstate Pipe &amp; Supply Company</u>	Casing and Tubing	Used in Drilling	Left in Well	Packers
Address <u>Marietta, Ohio</u>				
Farm <u>Robert &amp; N. Buzzard</u> Acres <u>43</u>	Size			
Location (waters).....	<u>Conductor</u>	<u>13</u>	<u>13</u>	Kind of Packer.....
Well No. <u>63</u> Elev.....	13.....			
District <u>Liberty</u> County <u>Marshall</u>	10.....	<u>182</u>	<u>182</u>	Size of.....
The surface of tract is owned in fee by <u>Robert &amp; Nettie Buzzard</u>	8 1/4.....	<u>1167</u>	<u>1167</u>	Depth set.....
Mineral rights are owned by <u>T. L. Rogerson</u>	6%.....	<u>2063</u>	<u>2063</u>	
Address <u>Moundsville, W. Va.</u>	5 3/16.....			Perf. top.....
Drilling commenced <u>December 17, 1918</u>	3.....			Perf. bottom.....
Drilling completed <u>February 18, 1919</u>	2.....		<u>144</u>	Perf. top.....
Date shot <u>Feb. 21, 1919</u> Depth of shot <u>2935-2944</u>	Liners Used.....			Perf. bottom.....
Open Flow /10ths Water in..... Inch				
/10ths Merc. in..... Inch				
Volume..... Cu. Ft.	<input checked="" type="checkbox"/> CASING CEMENTED.....	SIZE.....	No. Ft.....	Date.....
Rock Pressure..... lbs..... hrs.				
Oil..... bbls., 1st 24 hrs.				
Fresh water..... feet..... feet				
Salt water..... feet..... feet				
				COAL WAS ENCOUNTERED AT <u>490</u> FEET <u>36</u> INCHES
				<u>840</u> FEET <u>84</u> INCHES <u>927</u> FEET <u>72</u> INCHES
				FEET INCHES FEET INCHES

Formation	Color	Hard or Soft	Top	Bottom	Oil, Gas or Water	Depth Found	Remarks
Native Coal			490	493			
Bluff Sand			578	638			
Coal			640	645			
Mapletown Coal			840	847			
Pitts Coal			927	933			
Murphy Sand			1020	1050			
2nd Murphy Sand			1139	1170			
Little Dunkard			1335	1355			
Big Dunkard			1400	1505			Show of Oil 1425
Gas Sand			1650	1685			
Mazon Sand			2010	2035			
Big Injun Sand			2050	2362			Gas 2168 to 2180
Thirty foot			2700	2760			
Fifty foot Sand			2874	2897			Gas 2875 to 2880
Garden Sand			2933	2967			Gas 2935
Total Depth				2967			Oil at 2930

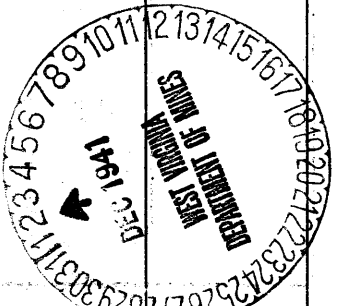

Formation	Color	Hard or Soft	Top	Bottom	Oil, Gas or Water	Depth Found	Remarks

Date November 29, 1941.

APPROVED THE INTERSTATE PIPE & SUPPLY COMPANY Owner

By H. H. Beren  
(Title) 9,