

Coal: J.W. Gorby
Bethany, W. Va.
Surface: A.H. Dobbs
Cameron, W. Va.
R.F.D. #5

1.95S
1.46W
#1
#4
2.09S
1.30W
1.49W
1.99W
1.31W
2.11W

JUN 16 1942

N25E2 Map N98

New Location
Drill Deeper
Abandonment

Company	South Penn Natural Gas Co.
Address	Parkersburg, W. Va.
Farm	V. P. Gorby
Tract	Acres 112 Lease No. 32339
Well (Farm) No.	1 & 4 Serial No.
Elevation (Spirit Level)	1 = 1314.23 4 = 1387.46
Quadrangle	Cameron
County	Marshall District Liberty
Engineer	Emmon Haines
Engineer's Registration No.	
File No.	Drawing No.
Date	Mar. 2, 1942 Scale 1" = 800'

STATE OF WEST VIRGINIA
DEPARTMENT OF MINES
OIL AND GAS DIVISION
CHARLESTON

WELL LOCATION MAP

FILE NO. MARS-183-A WELL # 1
MARS-184-A - " # 5

+ Denotes location of well on United States Topographic Maps, scale 1 to 62,500, latitude and longitude lines being represented by border lines as shown.

- Denotes one inch spaces on border line of original tracing.

Liberty District, Marshall County, W. Va.
 By South Penn Oil Co.
 Located $\frac{1}{2}$ mi. N. of John Bruhn No. 7 or M-70.
 Elevation, 1320' B.
 First production, 30 bbls. per day.

183A

	Top.	Bottom.
Coal, Waynesburg "A"	688	- 692
Coal, Mapletown (Sewickley)	930	- 934
Coal, Pittsburgh (SIM)	1027	- 1033
Little Dunkard Sand (First Cow Run)	1380	- 1410
Big Dunkard Sand	1520	- 1600
Salt Sand	1910	- 2050
Maxton Sand	2115	- 2150
Big Lime	2150	- 2165
Big Injun Sand	2165	- 2410
Gordon Sand (SIM) (first oil pay, 3037'; second oil pay, 3052')	3035	- 3056
Unrecorded to bottom	3056	- 3067

"In this well the Big Lime is reported only 15 feet thick, with the Maxton Sand lying in immediate contact with the same. The Pittsburgh Coal-Big Injun Sand interval is 1138 feet, and the same for the Gordon Sand is 2008 feet."

STATE OF WEST VIRGINIA
DEPARTMENT OF MINES
OIL AND GAS DIVISION

229

WELL RECORD

Permit No. 183-A

Oil or Gas Well OIL
(KIND)

Company South Penn Natural Gas Company
 Address Union Trust Bldg. Parkersburg, W. Va.
 Farm V. P. Gorby Acres 112
 Location (waters) Magg/oty Run
 Well No. 1 Elev. 1314.23
 District Liberty County Marshall
 The surface of tract is owned in fee by A. H. Dobbs
R. D. No. 5 Address Cameron, W. Va.
 Mineral rights are owned by J. W. Gorby et al.
c/o Harvey Hicks, Agt. Address Cameron, W. Va.
 Drilling commenced May 13, 1901
 Drilling completed Aug. 16, 1901
 Date Shot See below From --- To ---
 With -----

Casing and Tubing	Used in Drilling	Left in Well	Packers
Size			
16			Kind of Packer <u>-</u>
13			<u>-</u>
10	<u>1468' 10"</u>		Size of <u>-</u>
8 1/4	<u>1964' 11" (Pulled)</u>		<u>-</u>
6 5/8	<u>2046' 7"</u>		Depth set <u>-</u>
5 3/16	<u>2357'</u>		<u>-</u>
3			Perf. top <u>-</u>
2			Perf. bottom <u>-</u>
Liners Used			Perf. top <u>-</u>
			Perf. bottom <u>-</u>

Open Flow /10ths Water in ---- Inch
 /10ths Merc. in ---- Inch
 Volume ----- Cu. Ft.
 Rock Pressure -- lbs. --- hrs.
 Oil 60 bbls., 1st 24 hrs.
 Fresh water --- feet --- feet
 Salt water --- feet --- feet


CASING CEMENTED - SIZE - No. Ft. - Date -

COAL WAS ENCOUNTERED AT 688 FEET 48 INCHES
930 FEET 48 INCHES 1027 FEET 72 INCHES
- FEET - INCHES - FEET - INCHES

Formation	Color	Hard or Soft	Top	Bottom	Oil, Gas or Water	Depth Found	Remarks
Native Coal			688	692			
Mapletown Coal			930	934			
Pittsburgh Coal			1027	1033			
Little Dunkard			1380	1410			
Big Dunkard			1520	1600			
Salt Sand			1920	2050			
Maxon Sand			2115	2150			
Big Lime			2150	2165			
Big Injun			2165	2410			
Gordon Sand			3035	3056			
					1st Pay	3037 top	
					2nd Pay	3052 top	
Total Depth				3067			

SHOT RECORD:

8-20-01 60 qts.
 10-14-04 60 "
 2-5-08 80 "
 3-2-17 80 "

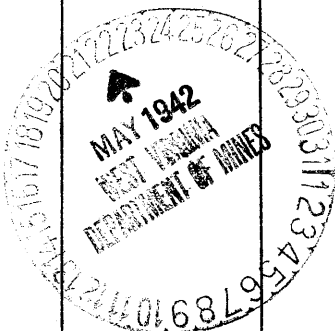

Formation	Color	Hard or Soft	Top	Bottom	Oil, Gas or Water	Depth Found	Remarks

Date May 21, 1942., 194

APPROVED SOUTH PENN NATURAL GAS COMPANY, Owner

By Olton Elbein Land Agent
(Title)