

242 #3	2.43	3.00
241 #2	2.45	3.00
241 #1	2.53	3.04

#2	3.04 W	3.0 W
	2.5	2.475
#3	3.11 W	3.05 W
	2.48	2.44
#4	3.11 W	3.04 W
	2.58	2.55

Company GEO. P. WASMUTH
 Address Salem, W. Va.
 Farm Catherine V. Hazlett
 Tract _____ Acres 196 Lease No. _____
 Well (Farm) No. 2-3-4 Serial No. _____
 Elevation (Spirit Level) 1163-1087 1076
 Quadrangle Cameron
 County Marshall District Union
 Engineer A. R. Westfall
 Engineer's Registration No. _____
 File No. _____ Drawing No. _____
 Date July 21, 1945 Scale 1" = 30 Poles

STATE OF WEST VIRGINIA
 DEPARTMENT OF MINES
 OIL AND GAS DIVISION
 CHARLESTON

WELL LOCATION MAP
 FILE NO. MARS-245-A; No. 2
MARS-242-A; No. 3
MARS-246-A; No. 4

+ Denotes location of well on United States Topographic Maps, scale 1 to 62,500, latitude and longitude lines being represented by border lines as shown.

- Denotes one inch spaces on border line of original tracing

6-6 (021) 242A
 MARS-245-A
 MARS-242-A

FILED FOR NHAZ LETT AS 2-2-A - GEO. P. WASMUTH - MARS-245-A - 242-A

Union District, Marshall County, W. Va.

By Geo. P. Hearnth, Glen Dale, W. Va.

Abandoned under permit Mars-242-A.

On 196 acres, on Little Grave Creek.

Elevation, 1087' L.

Surface and minerals owned by Catharine V. Hazlett, R.D. 4, Wheeling, W. Va.

Drilling commenced and completed in 1925.

8 1/2" casing, 520' (pulled); 6 3/4", 1130'; 5 1/2", 1569'; 2" tubing, 1620'.

Coal was encountered at 516'.

Oil well. Abandonment reported to Dept. of Mines May 7, 1946.

Record to ECT from Mrs. Griffith July 16, 1946. Old File No. 291.

	Top.	Bottom.
Big Injun Sand, white, hard (oil, 1620')	1569	- 1628



291

STATE OF WEST VIRGINIA
DEPARTMENT OF MINES
OIL AND GAS DIVISION

WELL RECORD

Ab 42-A
Permit No. _____

Oil or Gas Well oil
(KIND)


Company Geo P. Thasmuth
Address Glen Dale, West Va
Farm Catherine Hazlett Acres 196
Location (waters) Little Grave Creek
Well No. 3 Elev. 1087
District Union County Marshall
The surface of tract is owned in fee by Catherine Hazlett
Address Wheeling W Va RD 4
Mineral rights are owned by Same
Address Same

Casing and Tubing	Used in Drilling	Left in Well	Packers
Size			
16			Kind of Packer
13			
10			Size of
8 3/4	<u>520</u>	<u>Pulled</u>	
6%	<u>1130</u>	<u>1130</u>	Depth set
5 3/16	<u>1569</u>	<u>1569</u>	
3			Perf. top
2	<u>1620</u>	<u>1620</u>	Perf. bottom
Liners Used			Perf. top
			Perf. bottom

Drilling commenced 1925
Drilling completed 1925
Date Shot _____ From _____ To _____
With _____
Open Flow _____ /10ths Water in _____ Inch
_____ /10ths Merc. in _____ Inch
Volume _____ Cu. Ft.
Rock Pressure _____ lbs. _____ hrs.
Oil _____ bbls., 1st 24 hrs.
Fresh water _____ feet _____ feet
Salt water _____ feet _____ feet

CASING CEMENTED _____ SIZE _____ No. Ft. _____ Date _____
COAL WAS ENCOUNTERED AT 516 FEET _____ INCHES
_____ FEET _____ INCHES FEET _____ INCHES
_____ FEET _____ INCHES FEET _____ INCHES

Formation	Color	Hard or Soft	Top	Bottom	Oil, Gas or Water	Depth Found	Remarks
<u>Big Injion</u>	<u>White</u>	<u>Hard</u>	<u>1569</u>	<u>1628</u>	<u>Oil</u>	<u>1620</u>	

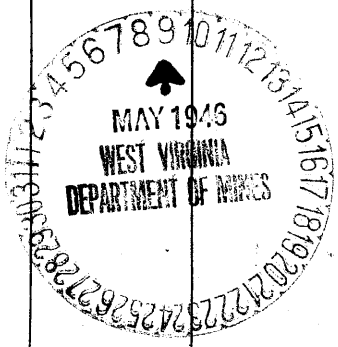

Formation	Color	Hard or Soft	Top	Bottom	Oil, Gas or Water	Depth Found	Remarks

Date May 7, 1946

APPROVED Geo P. Hamuth, Owner

By _____ (Title)

