


3
2.18S
2.69 W
2.10 W
2.63 S

#3
2.16S
2.70 W

Longitude 80 40'

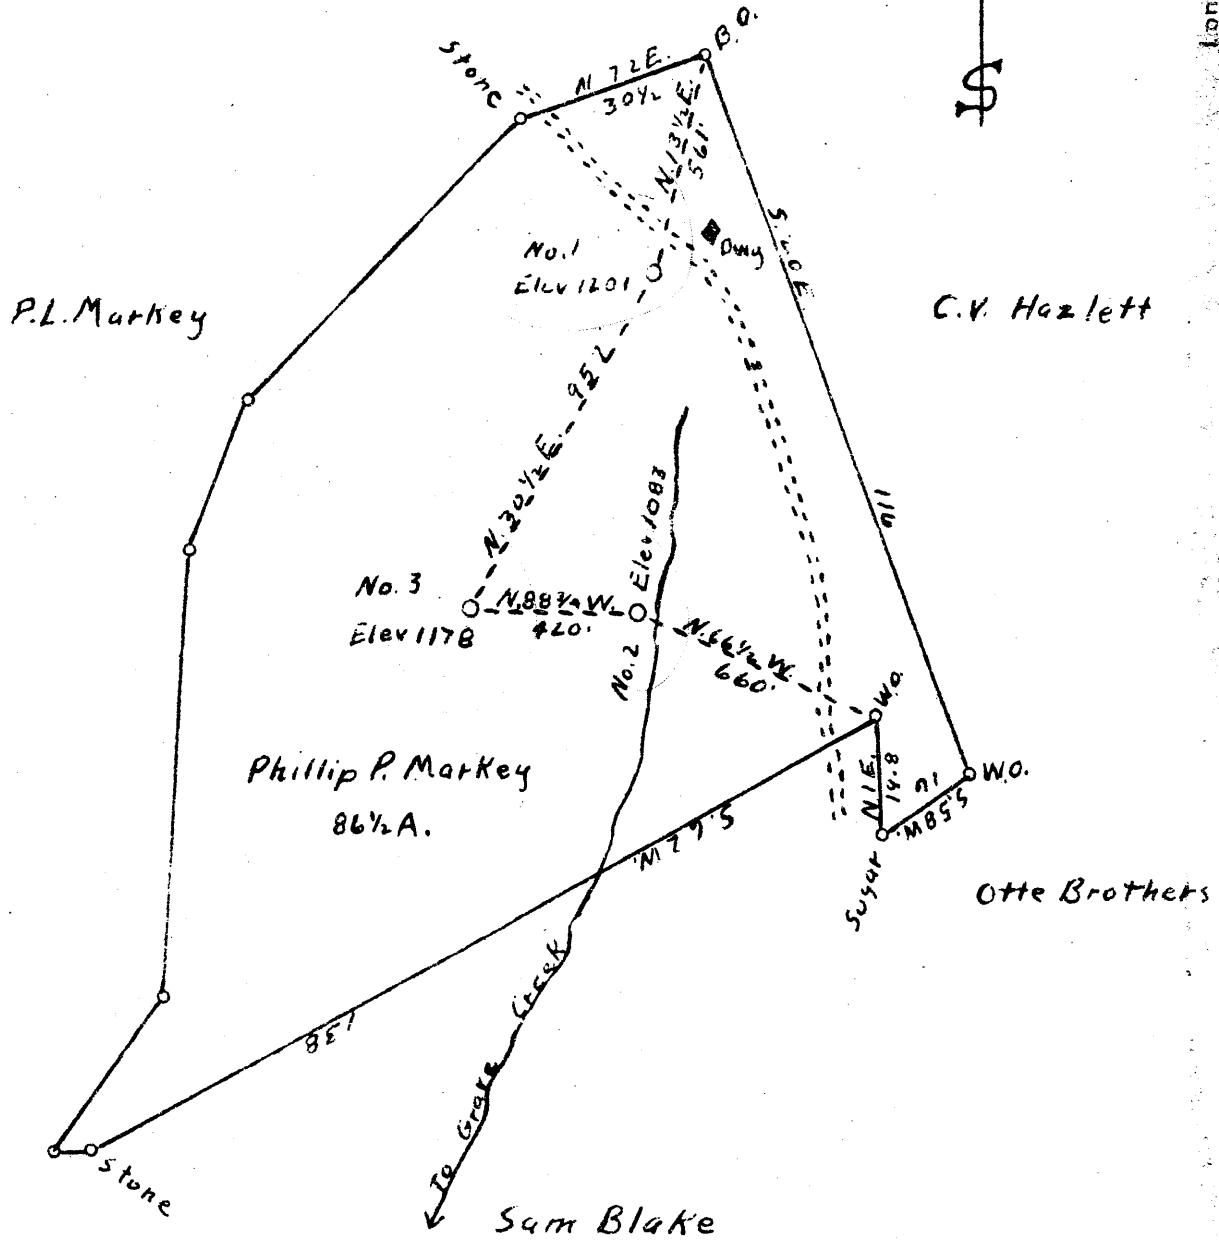

New Location
Drill Deeper
Abandonment X

Company W.M. Moses
Address Salem W.Va.
Farm Phillip P. Markey
Tract _____ Acres 86 1/2 Lease No. _____
Well (Farm) No. 1-2-3 Serial No. _____
Elevation (Spirit Level) 1201-1083-1178
Quadrangle Cameron
County Marshall District Union
Engineer A.H. Westfall
Engineer's Registration No. _____
File No. _____ Drawing No. _____
Date July 19, 1945 Scale 1" = 30 Poles

STATE OF WEST VIRGINIA
DEPARTMENT OF MINES
OIL AND GAS DIVISION
CHARLESTON

WELL LOCATION MAP

FILE NO. ~~MARS 241-A-#2~~
MARS - 249-A - #3
~~MARS - 251-A - #1~~

+ Denotes location of well on United States Topographic Maps, scale 1 to 62,500, latitude and longitude lines being represented by border lines as shown.
- Denotes one inch spaces on border line of original tracing.



297

STATE OF WEST VIRGINIA
DEPARTMENT OF MINES
OIL AND GAS DIVISION

WELL RECORD

Permit No. **MARS-249-A**

Oil or Gas Well **OIL**
(KIND)

Company **George P. Wasmuth**
Address **Glen Dale, W. Va.**
Farm **P. O. Markey** Acres **86 1/2**
Location (waters) **Little Grave Creek**
Well No. **3** Elev. **1178**
District **Union** County **Marshall**
The surface of tract is owned in fee by **P. P. Markey**
Address **Wheeling, W. Va.**
Mineral rights are owned by _____
Address _____
Drilling commenced **1925**
Drilling completed **1925**
Date Shot _____ From _____ To _____
With _____
Open Flow _____ /10ths Water in _____ Inch
_____ /10ths Merc. in _____ Inch
Volume _____ Cu. Ft.
Rock Pressure _____ lbs. _____ hrs.
Oil _____ bbls., 1st 24 hrs.
Fresh water _____ feet _____ feet
Salt water _____ feet _____ feet

Casing and Tubing	Used in Drilling	Left in Well	Packers
Size			Kind of Packer
16			
18	20	20	
10	350	Pulled	Size of
8 1/4	1160	850	
6	1661	1661	Depth set
5 3/16			
3			Perf. top
2	1740	1740	Perf. bottom
Liners Used			Perf. top
			Perf. bottom

CASING CEMENTED _____ SIZE _____ No. Ft. _____ Date _____
COAL WAS ENCOUNTERED AT **640** FEET _____ INCHES
_____ FEET _____ INCHES _____ FEET _____ INCHES
_____ FEET _____ INCHES _____ FEET _____ INCHES

Formation	Color	Hard or Soft	Top	Bottom	Oil, Gas or Water	Depth Found	Remarks
Big Injun	White	Hard	1661	1740	Oil	1730	