

New Location
 Drill Deeper
 Abandonment

Company Guy B & A G. Patterson
 Address Cameron, W. Va.
 Farm William Davis
 Tract 2 Acres 47 1/2 Lease No. _____
 Well (Farm) No. 9 Serial No. _____
 Elevation 1183
 Quadrangle Cameron CC
 County Marshall District Liberty
 Engineer Walter H. Stegmann
 Engineer's Registration No. 394
 File No. _____ Drawing No. _____
 Date Aug. 1, 1942 Scale 1 inch = 500 feet.

STATE OF WEST VIRGINIA
 DEPARTMENT OF MINES
 OIL AND GAS DIVISION
 CHARLESTON

WELL LOCATION MAP
 FILE NO. MARS-275-A-#5

+ Denotes location of well on United States Topographic Maps, scale 1 to 62,500, latitude and longitude lines being represented by border lines as shown.
 - Denotes one inch spaces on border line of original tracing.

W. DAVIS NO. 3 WELL.

Liberty District, Marshall County, W. Va.

By Guy B. and A. G. Patterson, Cameron, W. Va.

Abandoned under permit Wers-.....-A?

On 89 acres, on Cedar Run.

Elevation,' L.

Surface owned by Geo. Fish, E. D., Cameron, W. Va., and minerals by
Belton Fuel Co., Uniontown, Pa.

Drilling commenced Nov. 1923; completed Dec. 22, 1923.

Well was not shot.

Open flow, 12/10ths W. in 3".

Volume, 1,500,000 cu. ft.

Rock pressure, 525 lbs.

10" casing, 250'; 8 1/2", 1080'; 6", 1697'; all left in.

Casing not cemented.

Coal was encountered at 556-563'.

No packer.

Gas well. Record to Dept. of Mines stamped March 29, 1948.

Record to ROT from Mrs. Griffith March 17, 1949. Old File No. 331.

	Top.	Bottom.
Pittsburgh Coal	556	- 563
Little Bankard Sand	960	- 975
Big Bankard Sand	1028	- 1148
Salt Sand	1320	- 1585
Maxton Sand (gas, 1625-1635')	1585	- 1691
Total depth		1691

STATE OF WEST VIRGINIA
DEPARTMENT OF MINES
OIL AND GAS DIVISION

331

WELL RECORD

Permit No. Ab 275-A


Oil or Gas Well Gas
(KIND)

Company Guy B. & A. G. Patterson
 Address Cameron, W. Va.
 Farm Wm. Davis Acres 39
 Location (waters) Cedar Run
 Well No. 5 Elev. Sea level 16
 District Liberty County Marshall
 The surface of tract is owned in fee by Geo. Fish
R.D. Address Cameron, W. Va.
 Mineral rights are owned by Belton Fuel Co.
 Address Uniontown, Pa.
 Drilling commenced November 1923
 Drilling completed December 22, 1923
 Date shot No Depth of shot _____
 Open Flow 12 /10ths Water in 3 Inch
 _____ /10ths Merc. in _____ Inch
 Volume 1,500,000 Cu. Ft.
 Rock Pressure 525 lbs. _____ hrs.
 Oil None bbls., 1st 24 hrs.
 Fresh water _____ feet _____ feet
 Salt water _____ feet _____ feet

Casing and Tubing	Used in Drilling	Left in Well	Packers
Size			Kind of Packer
16			<u>none</u>
13			Size of
10	<u>250'</u>	<u>250'</u>	Depth set
8 1/4	<u>1080'</u>	<u>1080'</u>	Perf. top
6 5/8	<u>1697'</u>	<u>1697'</u>	Perf. bottom
5 3/16			Perf. top
3			Perf. bottom
2			Perf. top
Liners Used			Perf. bottom

CASING CEMENTED none SIZE _____ No. Ft. _____ Date _____
 COAL WAS ENCOUNTERED AT 556' - 563' FEET INCHES
 _____ FEET INCHES FEET INCHES
 _____ FEET INCHES FEET INCHES

Formation	Color	Hard or Soft	Top	Bottom	Oil, Gas or Water	Depth Found	Remarks
Pittsburgh Coal			556'	- 563'			
Little Dunkard			960'	- 975'			
Big Dunkard			1023'	- 1148'			
Salt Sand			1320'	- 1585'			
Maxon			1585'	- 1691'			
Gas			1625'	- 1635'			
Total			1691'				

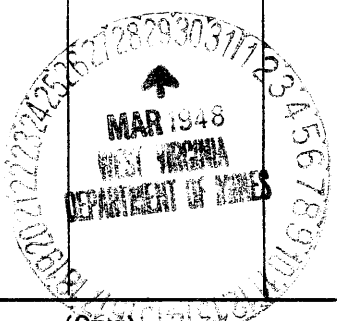

(Over) MAR 17 1949

Formation	Color	Hard or Soft	Top	Bottom	Oil, Gas or Water	Depth Found	Remarks

Date....., 194.....

APPROVED....., Owner

By.....
(Title)