

Company CAMERON LIGHT & HEAT Co.
 Address CAMERON, W. VA.
 Farm LINDSEY STRICKLIN
 Tract 1 Acres 55± Lease No. _____
 Well (Farm) No. 1 Serial No. _____
 Elevation (Spirit Level) 1185
 Quadrangle CAMERON
 County MARSHALL District LIBERTY
 Engineer Godall Sammons
 Engineer's Registration No. 509
 File No. _____ Drawing No. _____
 Date Aug. 27, 1937 Scale Scale 1 inch = 300 ft.

STATE OF WEST VIRGINIA
 DEPARTMENT OF MINES
 OIL AND GAS DIVISION
 CHARLESTON

WELL LOCATION MAP

FILE NO. _____

Marsh. 315-A #1

† Denotes location of well on United States Topographic Maps, scale 1 to 62,500, latitude and longitude lines being represented by border lines as shown.

— Denotes one inch spaces on border line of original tracing.

STRICKLIN NO. 1 WELL.

Liberty
District, Marshall County, W. Va.
 By Cameron Heat & Light Co.
 MW-6.

Com. in November, 1908; completed, April, 1909.

Elevation, 1185'. *1195 1200*

Top of shot, 2838'; bottom of shot, 2852'; action, 18'.

Packer set at 2770', in 50-Ft. Sand-Anchor.

Casing in well: 10" casing, 185' (pulled out); 8", 1290' (in well);
 6", 1942' (in well); tubing in well, 3", 3016'. 16 3/4' derrick
 and 18 strings = 2943'.

2943-16 3/4 = 2780 + 105 = 2885'; bridged to 2855'.

Shot, top, 2841-51, 40 qts. used. 7-1-29.

Record from Mr. Straub 9-11-39.

Note by Mr. Straub on records of wells plugged: Stricklin No. 1,
 59# Rock; open flow, 27,564 cu. ft.

	Top.	Bottom.
Conductor	0	16
Surface coal	465	470
Native coal	540	543
Mapleton (Sawickley) Coal	715	721
Pittsburgh Coal	817	822
Little Dunkard Sand	1190	1200
Big Dunkard Sand	1290	1340
Gas Sand	1430	1550
Coal	1565	1568
Salt Sand	1580	1890
Little Lime	1918	1926
Big Lime	1928	1975
Big Injun Sand	1975	2225
Lime	2530	2550
Lime	2570	2660
Fifty-foot Sand (gas at 2775')	2770	2805
Gordon Sand (gas at 2842')	2830	2864
Total depth		2870
4th Sand	
5th Sand	
Total depth		3016

NOTE on back of record of Wilson No. 1
 Stricklin No. 1. Virgin & Richard. 6-17-29, started.
 Top shot, 2841; bottom shot, 2851'.
 40 qts. nitroglycerine used.
 Shot by Hap Clelland, July 1, 1929.
 Total depth, steel line, 3016 ft.
 Adding rim in well July 9, 1929.
 Volume 2/10ths water through 2" - 16,848 cu. ft.
 36 lbs. in 2 hrs., 1928.
 40 lbs. in 1 1/2 hrs. 7-10-29.
 Volume, 9/10ths water through 1", 36,760 cu. ft.
 Finished well, tubing, etc., 7-10-29.
 150 qts. tubing, 3017'. Total depth, 3016 ft. (Steel line).-N.H. Davis.



STATE OF WEST VIRGINIA
DEPARTMENT OF MINES
OIL AND GAS DIVISION

305

Permit No. MMS-315-02

WELL RECORD

Oil or Gas Well GAS
(KIND)

Company CAMERON GAS CO.
Address BOX 541, CAMERON, W. VA.
Farm LINDSEY STRICKLIN Acres 55
Location (waters) BIG RUN
Well No. ONE (1) Elev. 1185
District LIBERTY County MARSHALL
The surface of tract is owned in fee by ALLEN GUMP
Address CAMERON W, VA.
Mineral rights are owned by CAMERON GAS CO.
Address CAMERON W. VA.
Drilling commenced NOVEMBER 1909
Drilling completed APRIL 1909
Date Shot SEE BELOW From _____ To _____
With _____

Casing and Tubing	Used in Drilling	Left in Well	Packers
Size			Kind of Packer
16			
13			
10	<u>185'</u>		Size of
8 1/4	<u>1290'</u>	<u>1290'</u>	Depth set
6 5/8	<u>1942'</u>	<u>1942'</u>	
5 3/16			Perf. top
3	<u>3016'</u>	<u>3016'</u>	Perf. bottom
2			Perf. top
Liners Used			Perf. bottom


Open Flow /10ths Water in _____ Inch
/10ths Merc. in _____ Inch
Volume _____ Cu. Ft.
Rock Pressure _____ lbs. _____ hrs.
Oil _____ bbls., 1st 24 hrs.
Fresh water _____ feet _____ feet
Salt water _____ feet _____ feet

CASING CEMENTED _____ SIZE _____ No. Ft. _____ Date _____

COAL WAS ENCOUNTERED AT 465 FEET 60 INCHES
540 FEET 36 INCHES 715 FEET 72 INCHES
817 FEET 60 INCHES 1565 FEET 36 INCHES

Formation	Color	Hard or Soft	Top	Bottom	Oil, Gas or Water	Depth Found	Remarks
Surface Coal			465'	470'			
Native Coal			540'	545'			
Mapletown Coal			715'	721'			
Pittsburgh Coal			817'	822'			
Little Dunkard			1190'	1200'			
Big Dunkard			1290'	1340'			
Gas Sand			1430'	1460'			
Coal			1565'	1568'			
Salt Sand			1580'	1590'			
Little Lime			1918'	1926'			
Big Lime			1928'	1975'			
Big Injun			1975'	2225'			
Lime			2530'	2550'			
Lime			2570'	2660'			
Fifty Foot			2770'	2805'	Gas	2775'	
Gordon Sand			2830'	2864'	Gas	2842'	
Total Depth				3016'			

U

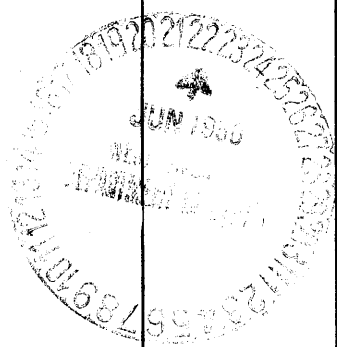

SHOT RECORD

Shot 7-1-29 Top of Shot 2841' Bottom of Shot 2851' 60 Quarts
Shot in 1909 Top of Shot 2838' Bottom of Shot 2852'

(Over)

NOV 18 1950

