

1.88S
 3.07W
 COAL = Belton Fuel Co.
 Uniontown, Pa.
 Surface = Ethel A Conoway
 Woodruff W Va

318-A	S 1.91
#1	W 3.12
319-A	S 1.81
#2	W 3.19
320-A	S 1.88
#3	W 3.02

1.78S
 3.13W
 1.84S
 2.99W

New Location
 Drill Deeper
 Abandonment

Company R.C. Snyder
 Address Cameron W. Va.
 Farm W.M. & Ellen Riter
 Tract 1 Acres 53 Lease No. 2825-2953
 Well (Farm) No. 1-2-4-3 Serial No. 3079
 Elevation (Spirit Level) #1 = 1318' #2 = 1265' #3 = 1250'
 Quadrangle Littleton
 County Marshall District Liberty
 Engineer A.L. Headley
 Engineer's Registration No. 2021
 File No. _____ Drawing No. _____
 Date 5-23-1950 Scale 1" = 500'

STATE OF WEST VIRGINIA
 DEPARTMENT OF MINES
 OIL AND GAS DIVISION
 CHARLESTON
 Marshall

WELL LOCATION MAP
 FILE NO. MAR 318-A-1
MAR 319-A-2
MAR 320-A-3


+ Denotes location of well on United States Topographic Maps, scale 1 to 62,500, latitude and longitude lines being represented by border lines as shown.
 - Denotes one inch spaces on border line of original tracing.

39°45'00"

Latitude

80°32'30"

Longitude

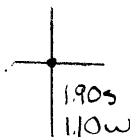

Topo Location

7.5' Loc. _____ 15' Loc. _____
(calc.) _____

Company RC Snyder

Farm WM Ruter #1

15' Quad _____
(sec.)

7.5' Quad Liberty

District Littleton

WELL LOCATION PLAT

County OSI Permit 30318



STATE OF WEST VIRGINIA
DEPARTMENT OF MINES
OIL AND GAS DIVISION

303

WELL RECORD

Permit No. Mar-318

Oil or Gas Well Oil
(KIND)


Company R. C. Snider
Address Cameron, W. Va.
Farm Wm. & Ellen Riter Acres 53
Location (waters) Fish Creek
Well No. 1 Elev. 1381
District Liberty County Marshall
The surface of tract is owned in fee by Ethel A. Conoway
Address Woodruff, W. Va.
Mineral rights are owned by R. C. Snider
Address Cameron, W. Va.
Drilling commenced April 12, 1923
Drilling completed May 4, 1923
Date Shot Aug. 11, 1926 From 3265 To 3272
With 10 qts. nitroglycerine
Open Flow /10ths Water in 0 Inch
0 /10ths Merc. in 0 Inch
Volume 0 Cu. Ft.
Rock Pressure 0 lbs. 0 hrs.
Oil 35 bbls., 1st 24 hrs.
Fresh water 0 feet 0 feet
Salt water 0 feet 0 feet

Casing and Tubing	Used in Drilling	Left in Well	Packers
Size			
16			Kind of Packer <u>0</u>
13			<u>0</u>
10	<u>241</u>	<u>None</u>	Size of <u>0</u>
8 1/4	<u>1629</u>	<u>None</u>	<u>0</u>
6 1/2	<u>2369</u>	<u>2369</u>	Depth set <u>0</u>
5 3/16	<u>3204</u>	<u>3204</u>	<u>0</u>
3			Perf. top <u>0</u>
2			Perf. bottom <u>0</u>
Liners Used			Perf. top <u>0</u>
			Perf. bottom <u>0</u>

CASING CEMENTED SIZE No. Ft. Date

COAL WAS ENCOUNTERED AT 1193 FEET INCHES
7 1/2 FEET 17 1/2 INCHES FEET INCHES
7 1/2 FEET 17 1/2 INCHES FEET INCHES

Formation	Color	Hard or Soft	Top	Bottom	Oil, Gas or Water	Depth Found	Remarks
High Coal	Black	soft	1193	1199			
Murphy Sand	Grey	hard	1393	1406			
Big Dunkard	Grey	hard	1710	1790			
Coal	Black	hard	1790	1795			
Gas Sand	Grey	hard	1804	1849			
Salt Sand	White	soft	2065	2117			
Big Injun	Grey	hard	2404	2654			
Fifty Foot	Grey	hard	3199	3210			
Gordon Sand	Grey	hard	3253	3277	Oil	3262-3270	

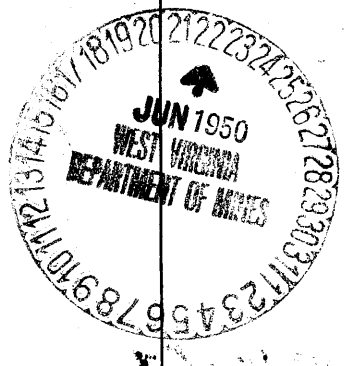

(Over)

NOV 18 1950