




Liberty dist.

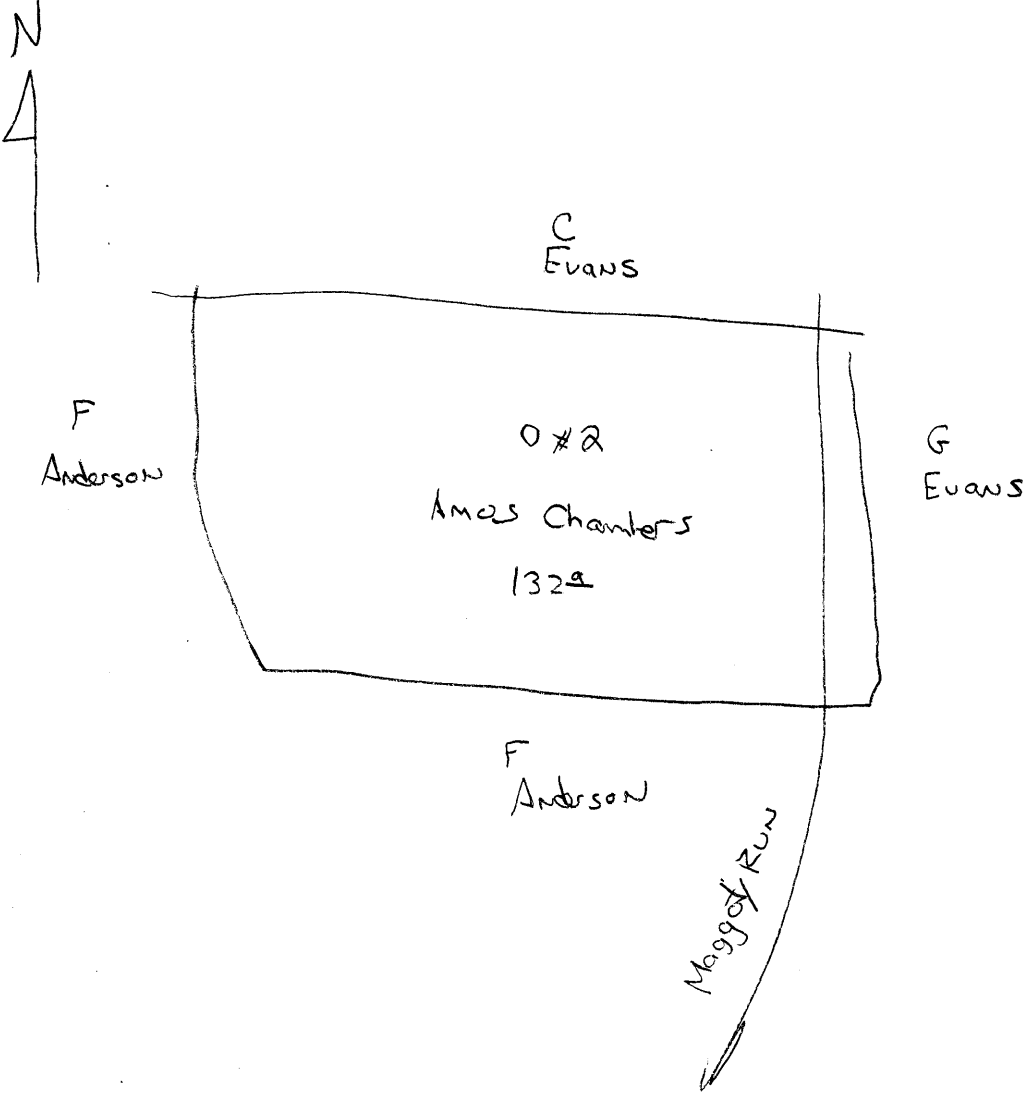

30328