

39°45'00"

### Latitude

80°30'00"

1.11s  
2.06w

Longitude

### Topo Location

7.5' Loc. \_\_\_\_\_ 15' Loc. \_\_\_\_\_  
(calc.) \_\_\_\_\_

Company Truman Smith

Farm McCuskey Hrs #2

15' Quad \_\_\_\_\_  
(sec.)


7.5' Quad Littleton

District Liberty

### WELL LOCATION PLAT

County OSI Permit 30332

Libertydust

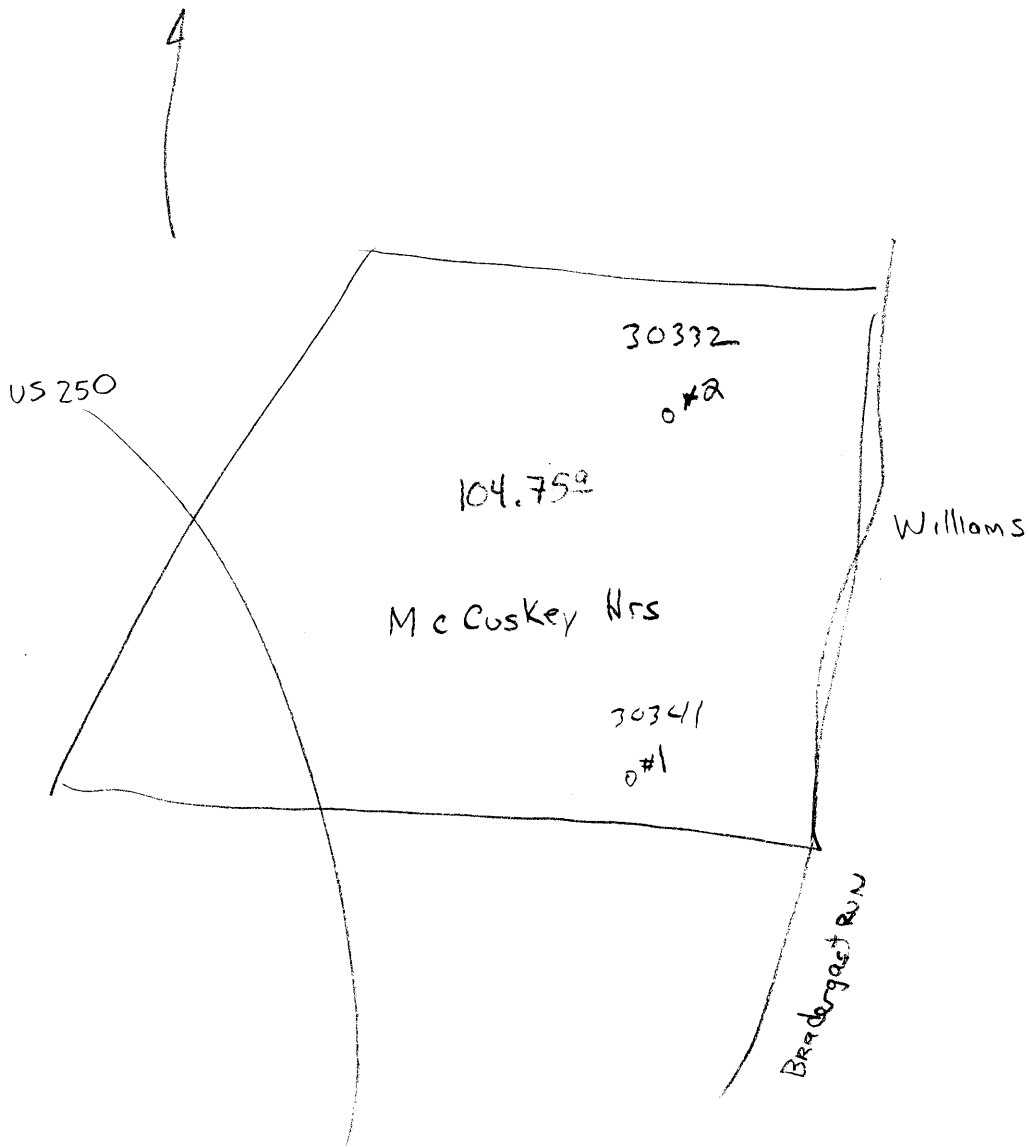

30332

30341