


LATITUDE 39 ° 45

LONGITUDE 80 ° 35'

119 S
0.23 W

1.08 S
0.23 W

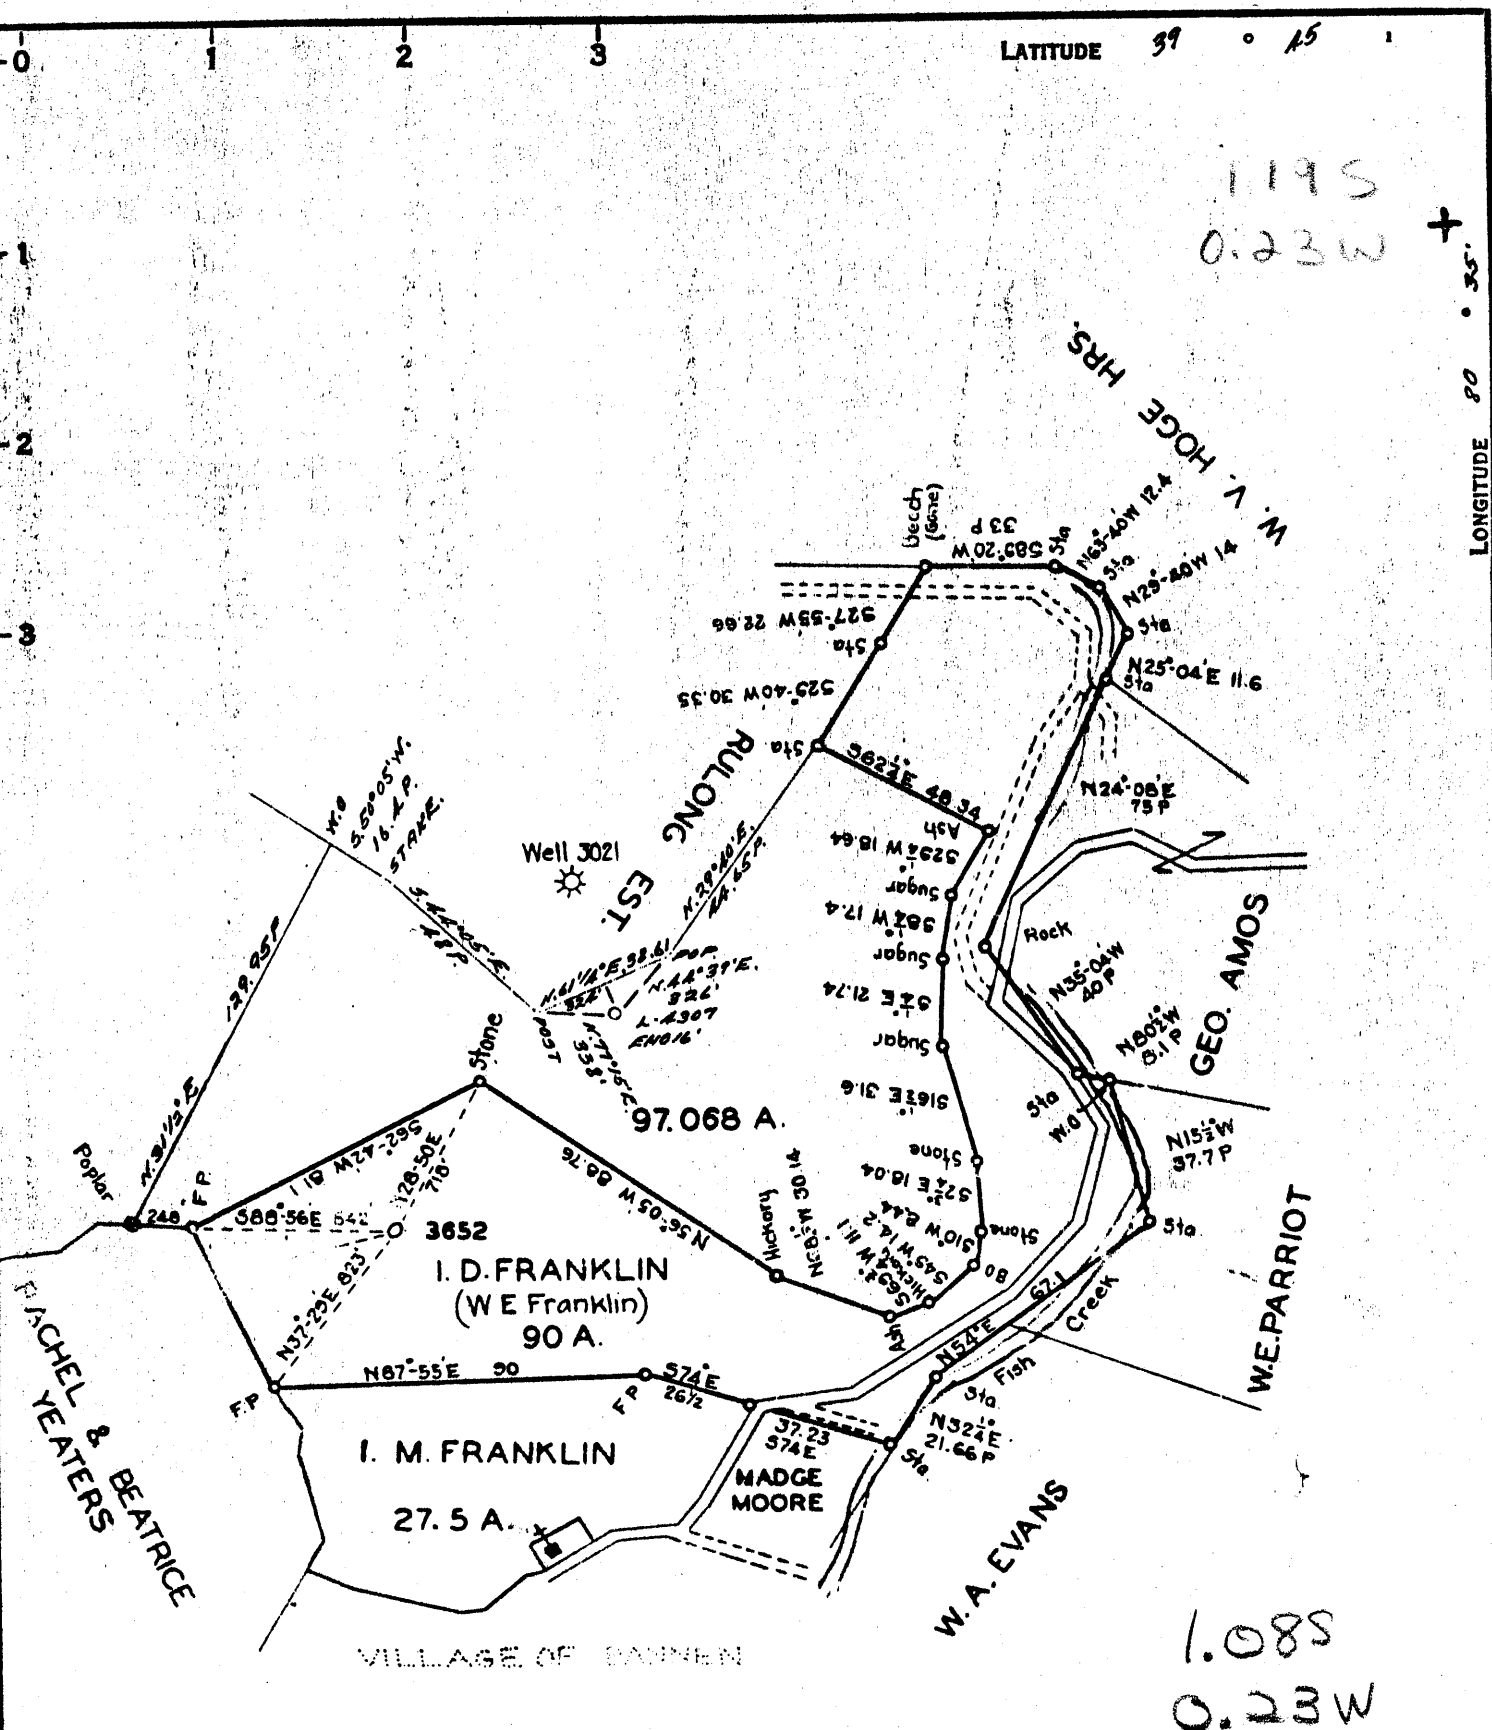

COAL OWNED BY W.V. PROD

NEW LOCATION

DRILL DEEPER

ABANDONMENT - 9-13-71

COMPANY THE MANUFACTURERS LIGHT & HEAT

ADDRESS 510 UNION TRUST BLDG. PGM. 99.

FARM W.E. FRANKLIN

TRACT _____ ACRES 100 LEASE NO. 27925

WELL (FARM) NO. 1 SERIAL NO. 4307

ELEVATION (SPIRIT LEVEL) 1016'

QUADRANGLE LITTLETON NC

COUNTY MARSHALL DISTRICT LIBERTY

ENGINEER Thomas E. Virgin

ENGINEER'S REGISTRATION NO. 1503

FILE NO. _____ DRAWING NO. Y-15-706

DATE 11 FEB. 1958 SCALE 1" = 800'

STATE OF WEST VIRGINIA
DEPARTMENT OF MINES
OIL AND GAS DIVISION
CHARLESTON

WELL LOCATION MAP

FILE NO. MARS-388-Partial (A)

+ DENOTES LOCATION OF WELL ON UNITED STATES TOPOGRAPHIC MAPS. SCALE 1 TO 62,500. LATITUDE AND LONGITUDE LINES BEING REPRESENTED BY BORDER LINES AS SHOWN.

- DENOTES ONE INCH SPACES ON BORDER LINE OF ORIGINAL TRACING.