


0 1 2 3 LATITUDE 39 ° 45 ' 1

1

2

3

LONGITUDE 80 ° 35'

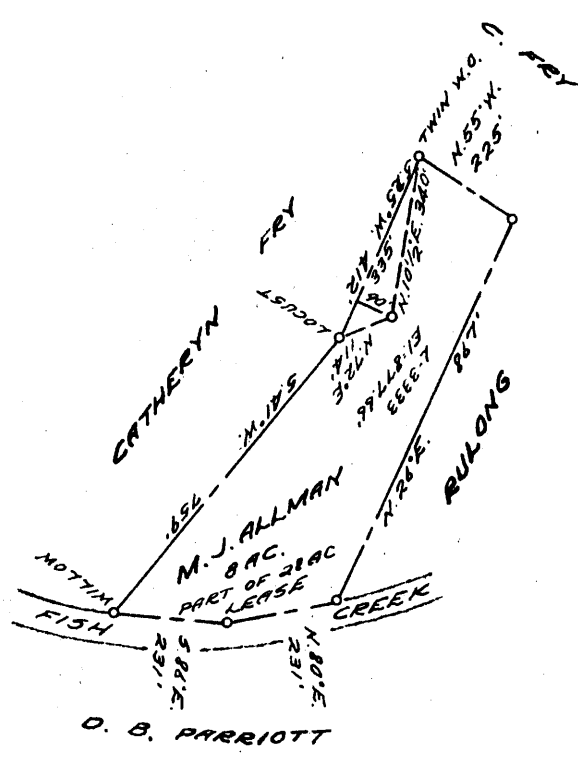

0.87S
0.57W

COAL OWNED BY _____
 RECONDITION & PART. PLUG. FOR STORAGE.

NEW LOCATION.....

DRILL DEEPER.....

ABANDONMENT.....

P-25-4

COMPANY THE MANUFACTURERS LIGHT & HEAT

ADDRESS 800 UNION TRUST BLDG. PGH. PA.

FARM M. J. ALLMAN

TRACT _____ ACRES 28 LEASE No. 2242

WELL (FARM) No. 1 SERIAL No. 3393

ELEVATION (SPIRIT LEVEL) 877.66'

QUADRANGLE LITTLETON

COUNTY MARSHALL DISTRICT LIBERTY

ENGINEER Robert M. Heill

ENGINEER'S REGISTRATION No. 361-E (G.E.A.)

FILE No. _____ DRAWING No. Y-25-167

DATE 4 MAY, 1960 SCALE 1" = 400'

STATE OF WEST VIRGINIA
 DEPARTMENT OF MINES
 OIL AND GAS DIVISION
 CHARLESTON

WELL LOCATION MAP

FILE No. MAAS-421-
PARTIAL PLUGGING

+ DENOTES LOCATION OF WELL ON UNITED STATES TOPOGRAPHIC MAPS, SCALE 1 TO 62,500. LATITUDE AND LONGITUDE LINES BEING REPRESENTED BY BORDER LINES AS SHOWN.

— DENOTES ONE INCH SPACES ON BORDER LINE OF ORIGINAL TRACING.