


3/21/67 C. N.

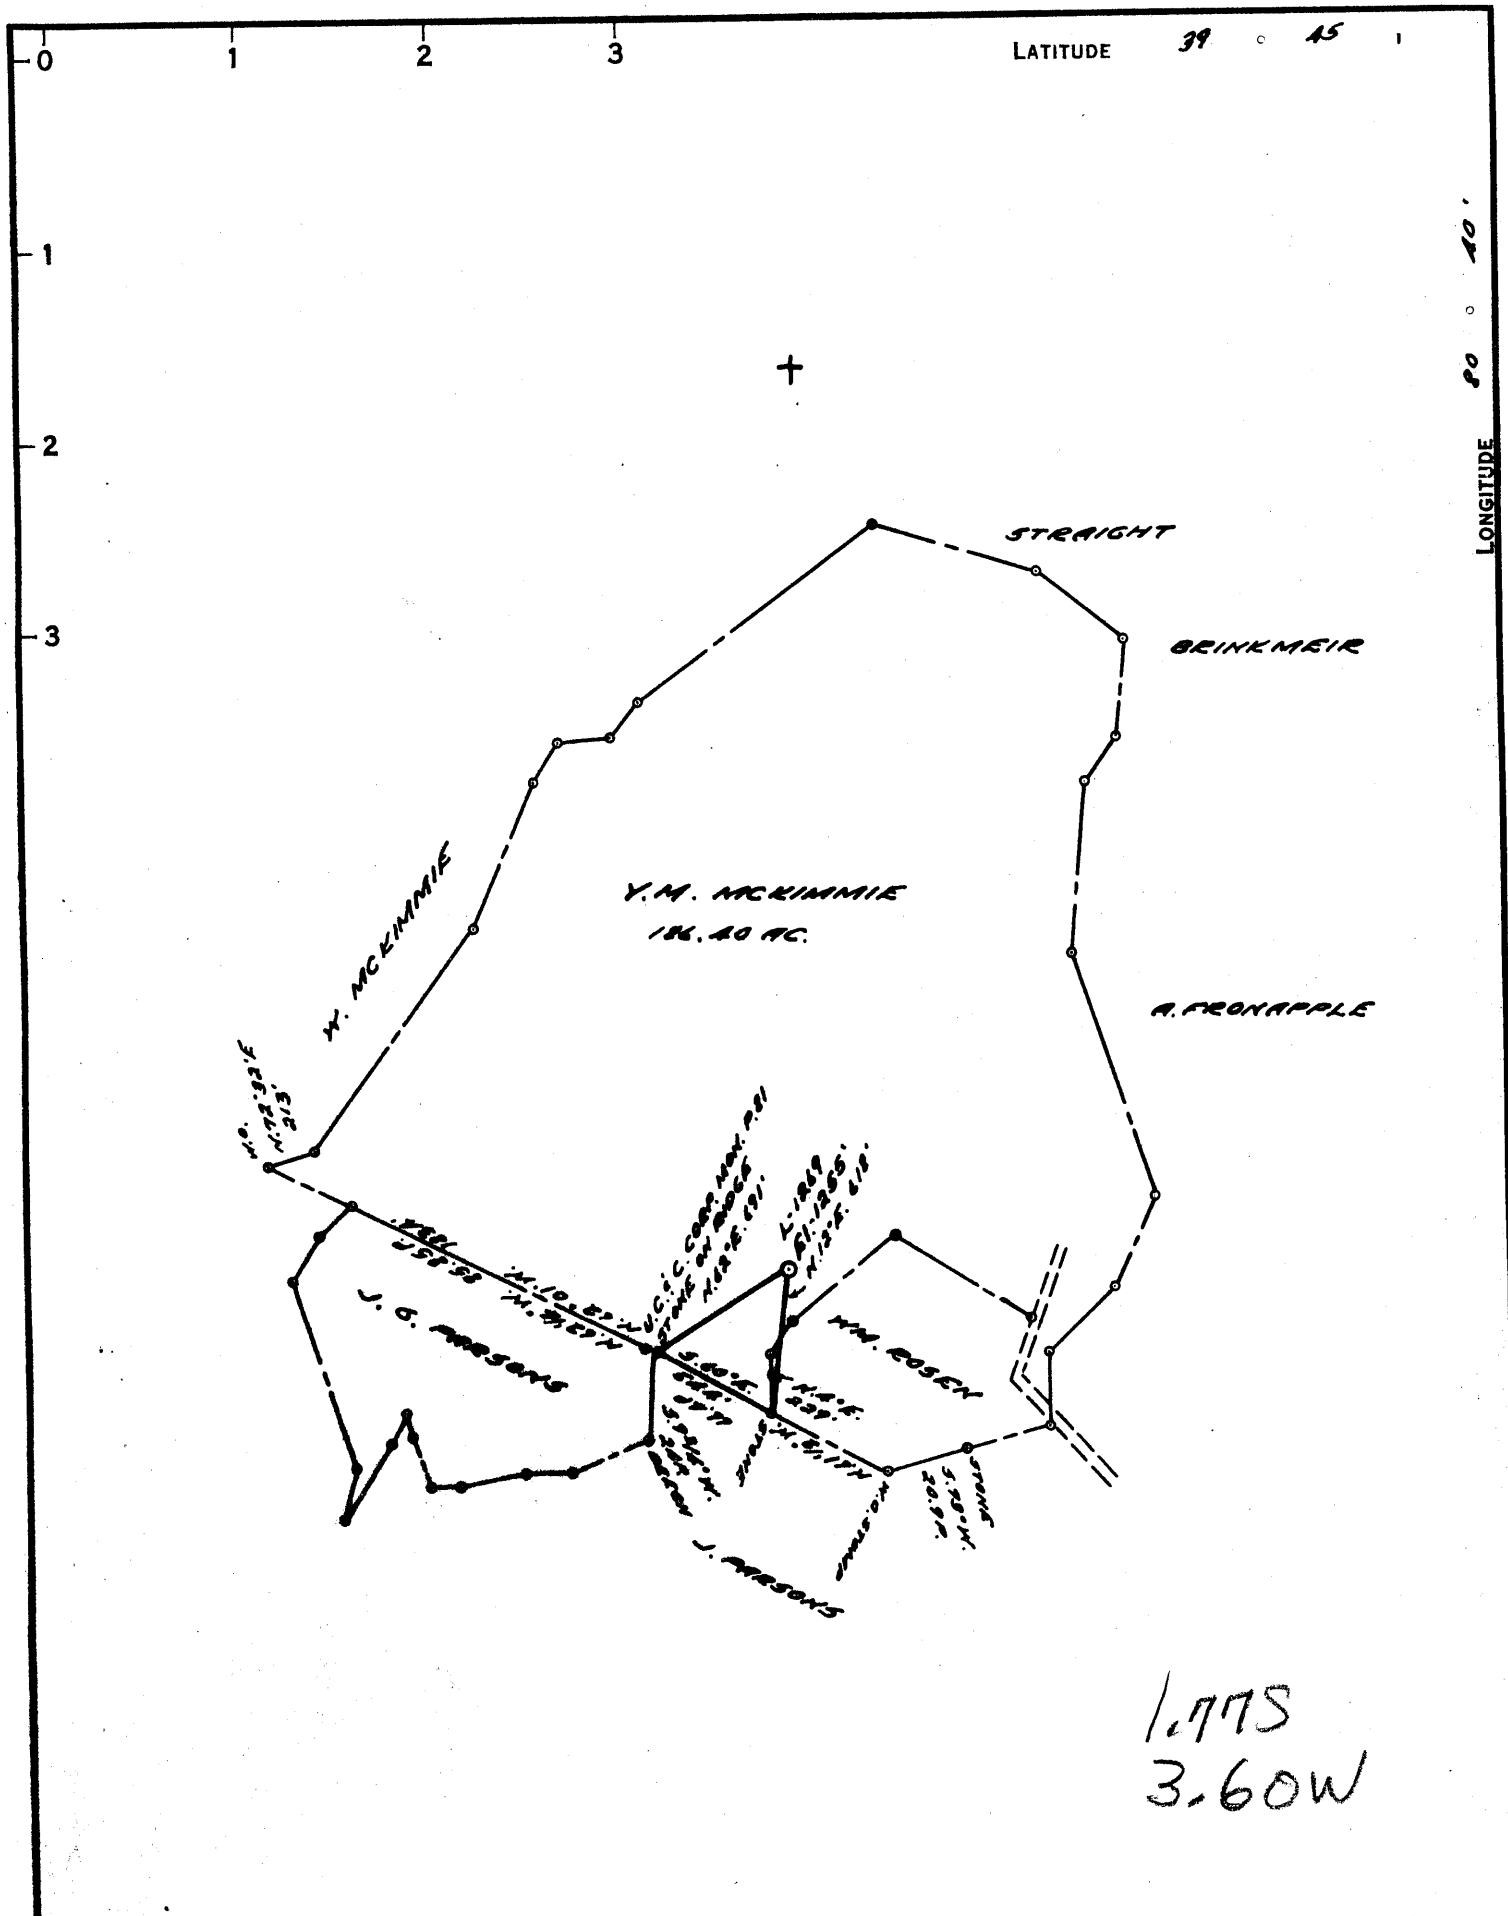

COAL OWNED BY SOUTHERN RESERVE COAL CO.

- NEW LOCATION
- RECONDITION
- DRILL DEEPER
- ABANDONMENT

"I, the undersigned, hereby certify that this map is correct to the best of my knowledge and belief and shows all the information required by paragraph 6 of the rules and regulations of the oil and gas section of the mining laws of West Virginia."  
 Minimum degree of accuracy is one part in 200

Signed Robert M. Heill (C)  
 # 381-E

COMPANY THE MANUFACTURERS LIGHT & HEAT  
 ADDRESS 800 UNION TRUST BLDG., PGH., PA.  
 FARM Y.M. MCKIMMIE  
 MAP P-25-1 ACRES 200 LEASE NO. 2155  
 WELL (FARM) NO. 1 SERIAL NO. 1269  
 ELEVATION (SPIRIT LEVEL) 1255'  
 QUADRANGLE LITTLETON NW  
 COUNTY MARSHALL DISTRICT FRANKLIN  
 POINT OF PROVEN ELEVATION B.M. 1600' S. OF WELL 1269  
EI. OF B.M. 1276'  
 FILE NO. \_\_\_\_\_ DRAWING NO. Y-28-390  
 DATE 1 FEB. 1967 SCALE 1" = 800'

STATE OF WEST VIRGINIA  
 DEPARTMENT OF MINES  
 OIL AND GAS DIVISION  
 CHARLESTON  
 WELL LOCATION MAP  
 FILE NO. 77AQS-490-A gas  
 + DENOTES LOCATION OF WELL ON UNITED STATES TOPOGRAPHIC MAPS, SCALE 1 TO 62,500. LATITUDE AND LONGITUDE LINES BEING REPRESENTED BY BORDER LINES AS SHOWN.  
 - DENOTES ONE INCH SPACES ON BORDER LINE OF ORIGINAL TRACING.