


Well# MD-49

WADESTOWN WV / RA 7.5' Quad

Scale: 1" = 500'

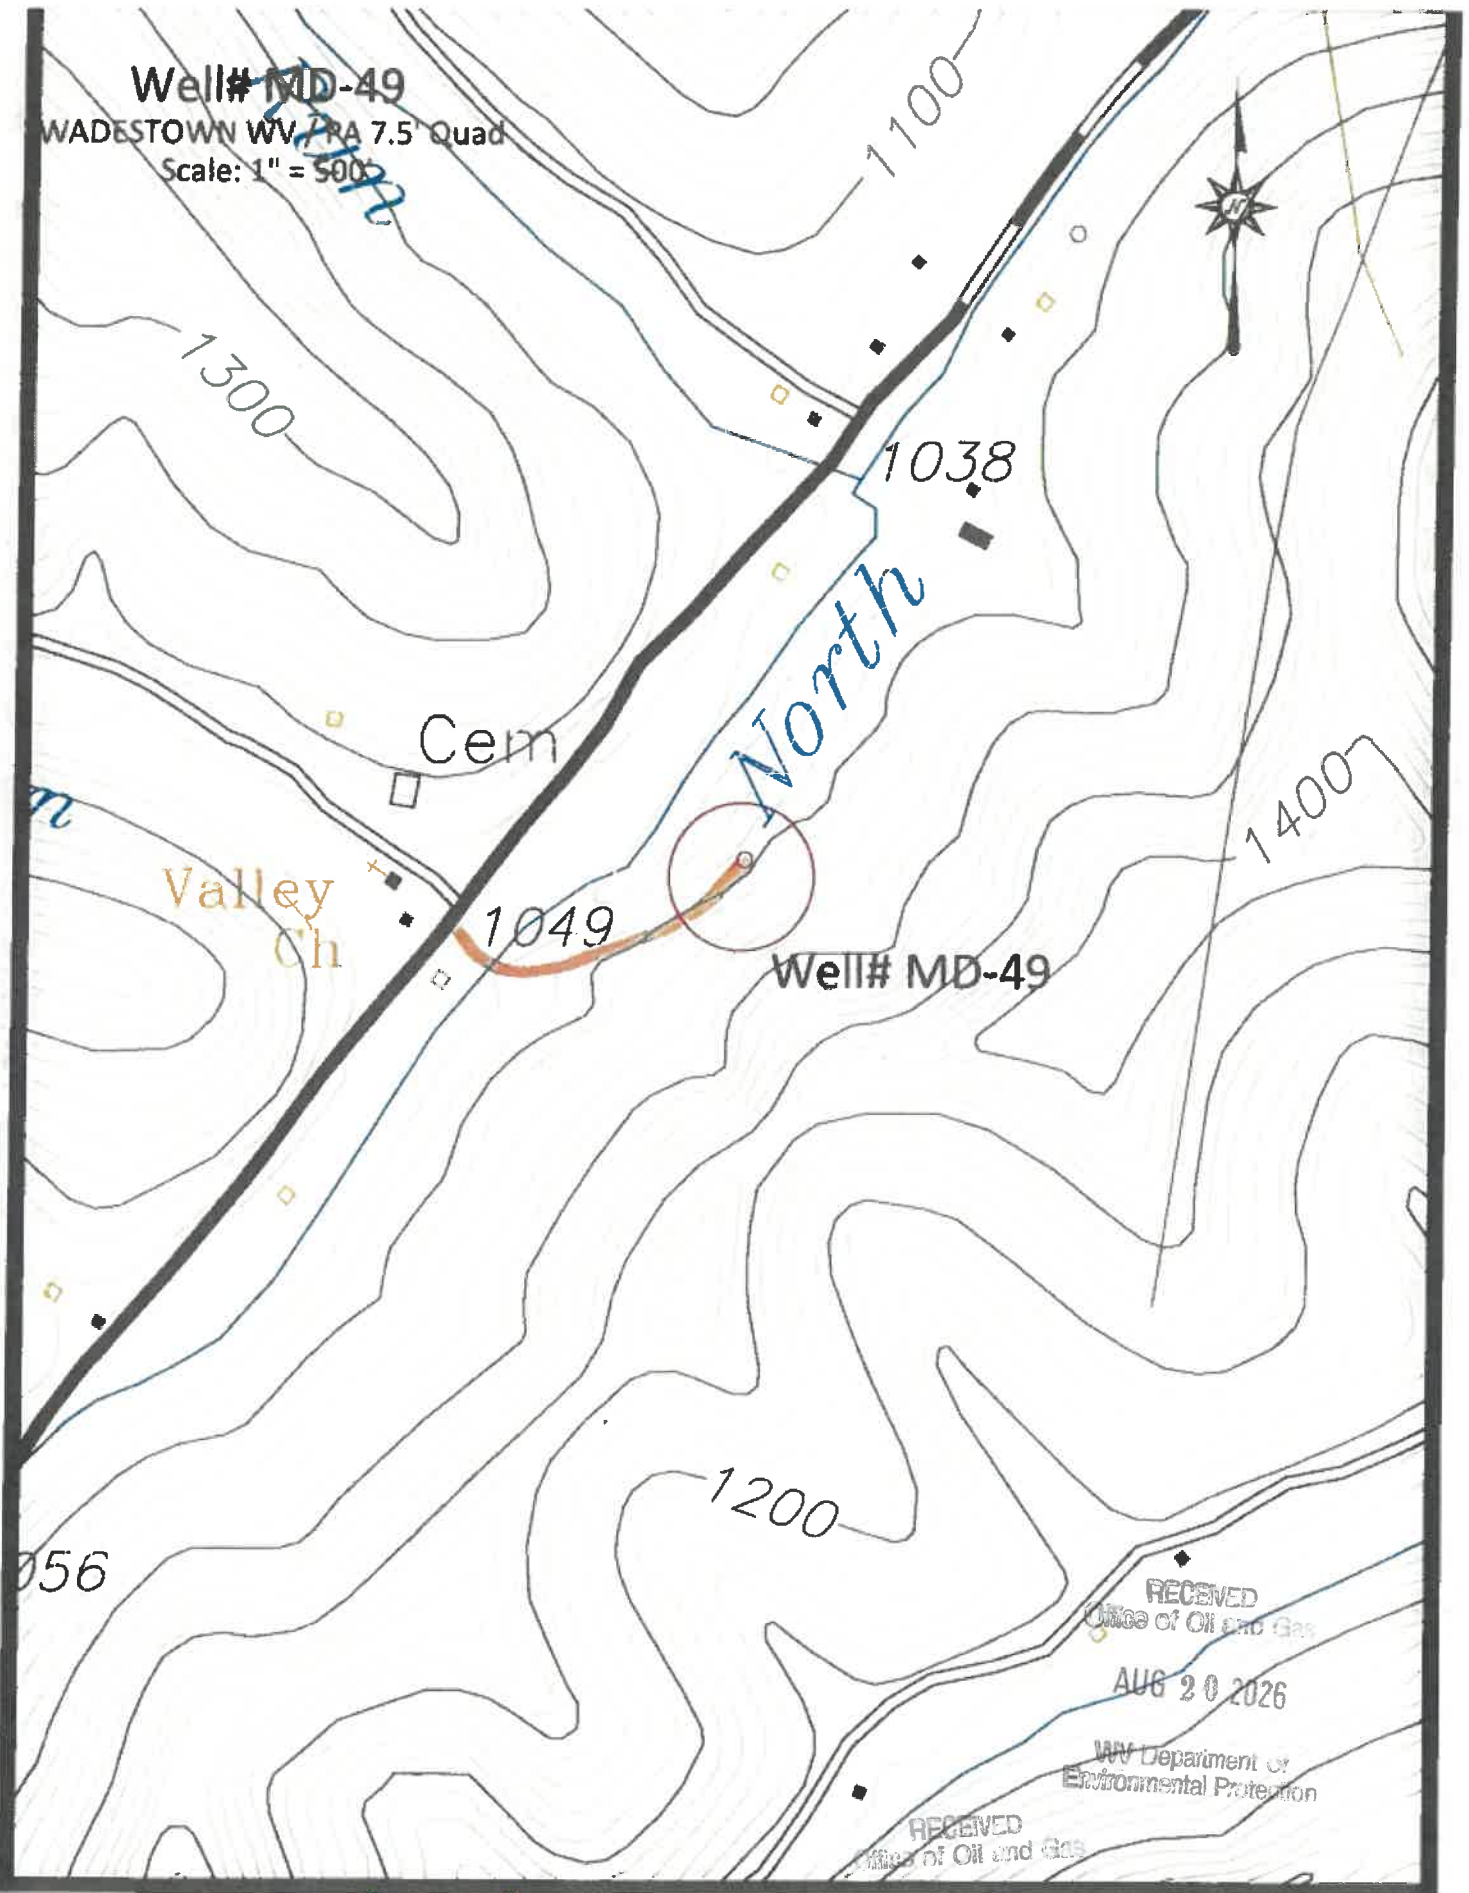

Access Road

AUG 20 2026

WV Department of
Environmental Protection

09/18/2026

42°30'

4395

4394

4393 IN NW
(HUNDRED)

4392

4391

40'

HUNDRED 6.2 MI.
OTTONTOWN 3.4 MI.

RECEIVED
Office of Oil and


AUG 20 2026

WV Department
Environmental Protection

WELL# MD-49

'Wadestown; WV, PA' Scale: 1" = 0.379MI 610M 2,000Ft, 1 Mi = 2.640", 1 cm = 240M

09/18/2026

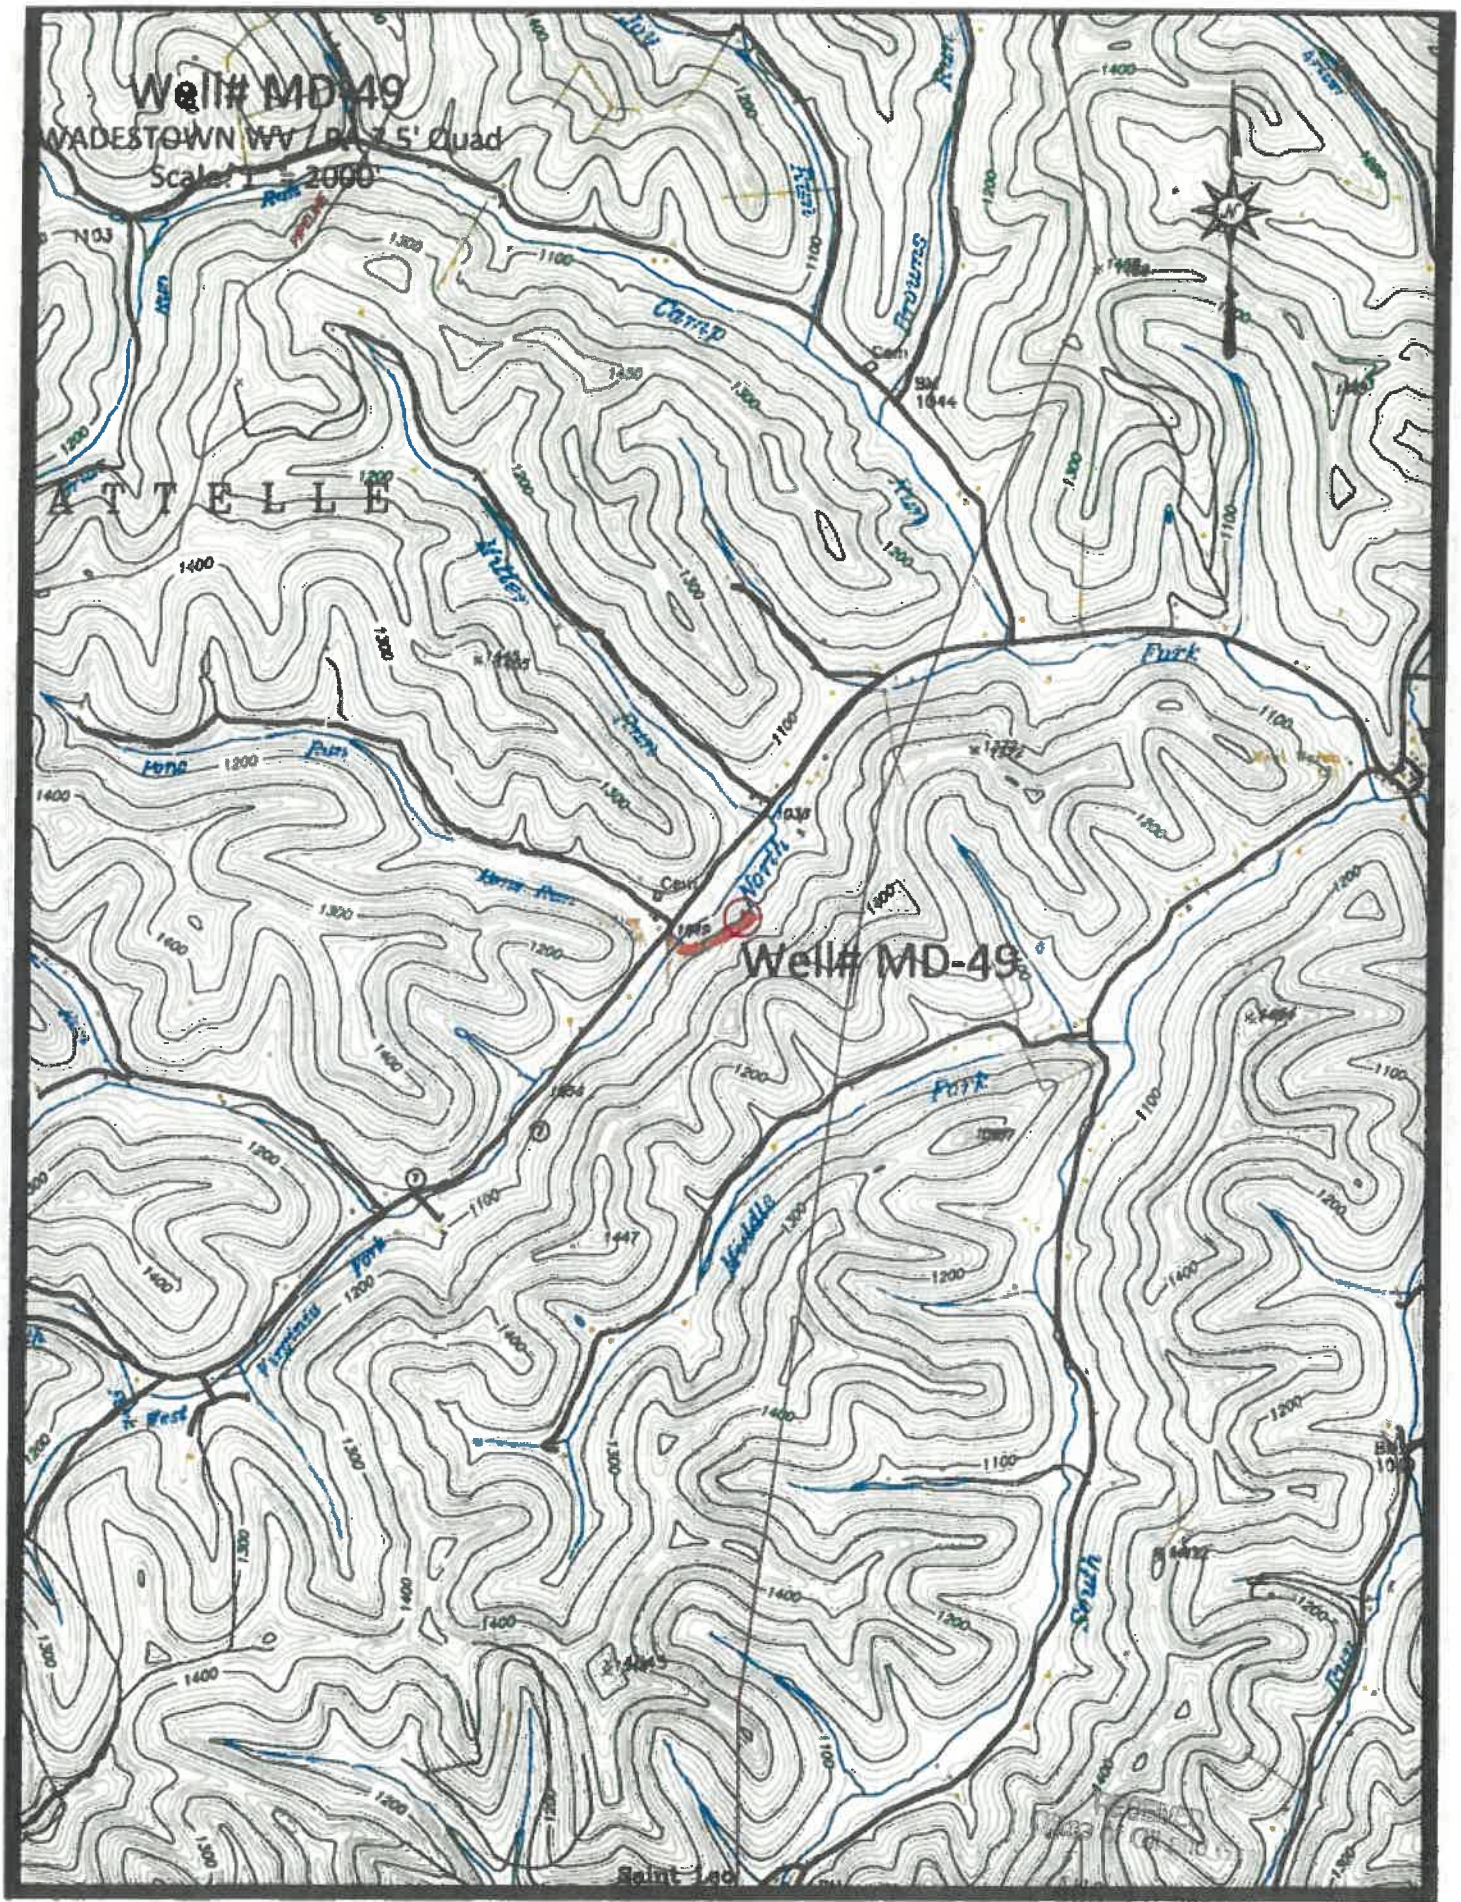

Well# MD-49

WADESTOWN WV / PA 7 S' Quad

Scale: 1" = 2000'

ATTELLE

Well# MD-49

Atlas Road

09/18/2026
WV Department of
Environmental Protection

WW-7
8-30-06



West Virginia Department of Environmental Protection
Office of Oil and Gas

WELL LOCATION FORM: GPS

API: 47-061-00155 WELL NO.: MD-49
FARM NAME: ELIZABETH J. TENNANT
RESPONSIBLE PARTY NAME: WEST VIRGINIA LAND RESOURCES INC.
COUNTY: MONONGALIA DISTRICT: BATTELLE
QUADRANGLE: WADESTOWN W.VA, PA
SURFACE OWNER: RDFS LLC
ROYALTY OWNER: _____
UTM GPS NORTHING: 4,391,437 m
UTM GPS EASTING: 554,581 m GPS ELEVATION: 338 m

The Responsible Party named above has chosen to submit GPS coordinates in lieu of preparing a new well location plat for a plugging permit or assigned API number on the above well. The Office of Oil and Gas will not accept GPS coordinates that do not meet the following requirements:

1. Datum: NAD 1983, Zone: 17 North, Coordinate Units: meters, Altitude: height above mean sea level (MSL) - meters.
2. Accuracy to Datum - 3.05 meters
3. Data Collection Method:

Survey grade GPS ☒ : Post Processed Differential _____
Real-Time Differential ☒

Mapping Grade GPS _____ : Post Processed Differential _____
Real-Time Differential _____

4. Letter size copy of the topography map showing the well location.

I the undersigned, hereby certify this data is correct to the best of my knowledge and belief and shows all the information required by law and the regulations issued and prescribed by the Office of Oil and Gas.

Signature

Title

AUGUST 11, 2026

Date

RECEIVED
Office of Oil and Gas

AUG 20 2026

WV Department of
Environmental Protection

09/18/2026