


Latitude 39° 40'

Longitude 79° 55'

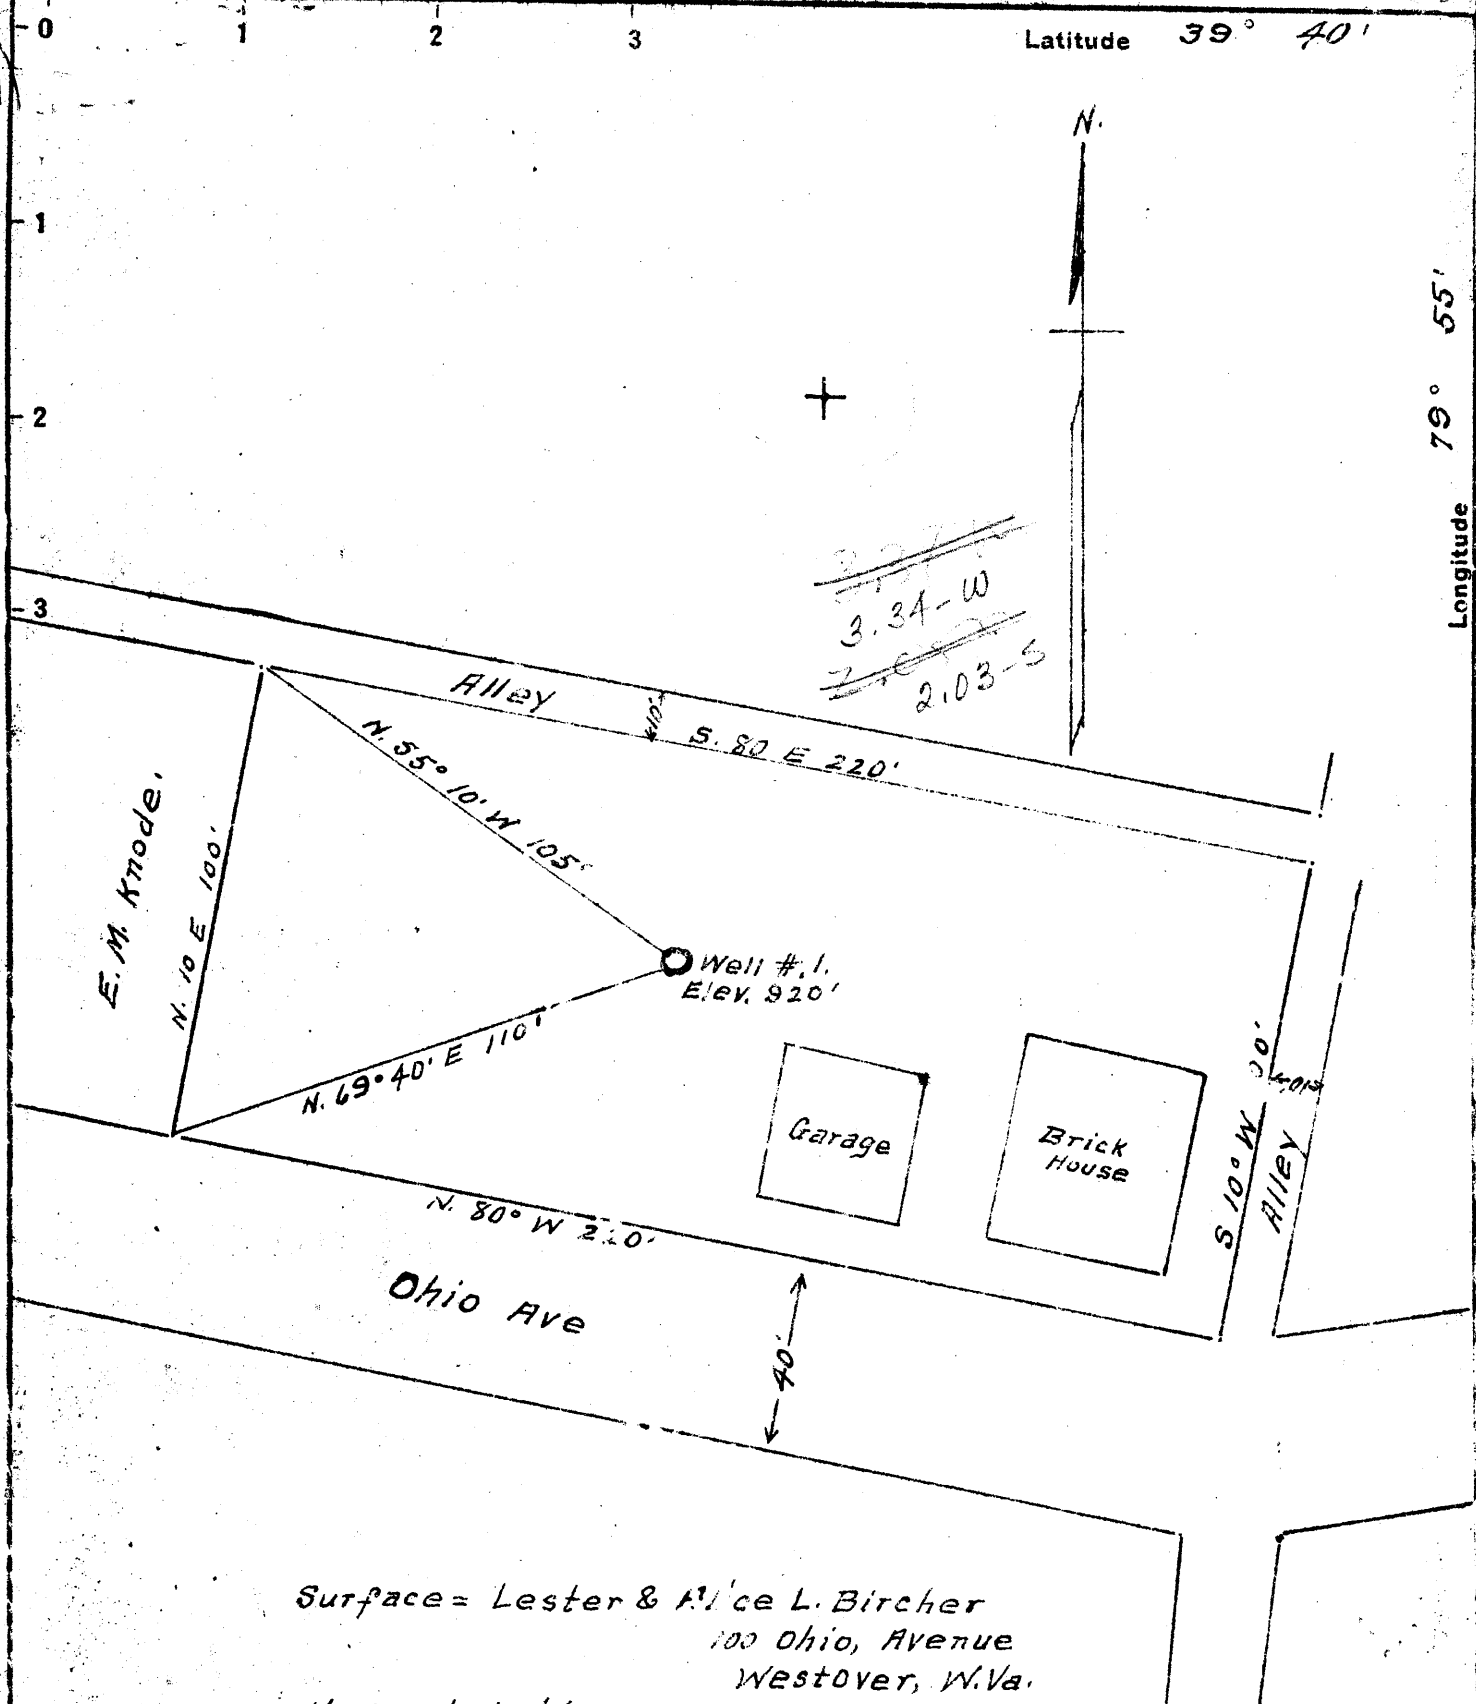

~~3.34-W~~
~~2.03-S~~

Surface = Lester & Alice L. Bircher
 100 Ohio, Avenue
 Westover, W. Va.
 No marketable Conf.

D-17

New Location
 Drill Deeper
 Abandonment

Company John Conklin
 Address Waynesburg Pa.
 Farm Lester & Alice L. Bircher
 Tract 1 Acres Lot Lease No. _____
 Well (Farm) No. one Serial No. _____
 Elevation (Spirit Level) 920'
 Quadrangle Morgantown
 County Monongalia District River Side Grant
 Engineer A. L. Headley
 Engineer's Registration No. 2021
 File No. _____ Drawing No. _____
 Date 5-26-1950 Scale 1" = 40'

STATE OF WEST VIRGINIA
 DEPARTMENT OF MINES
 OIL AND GAS DIVISION
 CHARLESTON

WELL LOCATION MAP
 FILE NO. MON-196

+ Denotes location of well on United States Topographic Maps, scale 1 to 62,500, latitude and longitude lines being represented by border lines as shown.

- Denotes one inch spaces on border line of original tracing.

WEST VIRGINIA DEPARTMENT OF MINES
OIL & GAS DIVISION
W E L L R E C O R D

Permit No. Mon 196

Dry Hole
CASING & TUBING

Morgantown Quad.

Company

John R. Conklin

Address

Waynesburg, Pa.

13 14

Farm

G.L. Bircherand Acres Lot

8 317

Location

Monongahela River

5 3/16 1015

Well No.

1 Elev. 920

District

Grant Monongalia

Coal at 260' 48"

Surface

G.L. Bircherand,

445' 36"

Morgantown, W. Va.

Mineral

Same

Commenced

July 10, 1950

Completed

Aug. 3, 1950

Not shot

Fresh Water

300'; 350'

No Salt Water

Slate & Lime

260

Coal

260

262 *Brush Creek*

~~Little~~ Dunkard ?

262

290 *Dunkard*

Slate

290

316

~~Big~~ Dunkard ?

316

356

Slate & Lime

356

377

Gas Sand

377

445

~~Freeport~~ Coal

445

448

Slate & Lime

448

526

1st Salt Sand

526

557

Slate

557

573

2nd Salt Sand

573

735

Lime & Slate

735

778

3rd Salt Sand

778

824

Slate

824

827

Maxon Sand

827

900

Red Rock

900

905

Slate & Lime

905

961

Big Lime

961

1061

Red Rock *368*

1061

1063

Big Injun *371*

1063

1176

Slate & Shells

1176

1210

T.D.

1210

1063
920

143