

DM WILLIS "99"

47-061-00200

Legend

DM WILLIS "99" 47-061-00200

CDM WILLIS "99" 47-061-00200

RECEIVED
Office Of Oil and Gas

MAR 13 2025


U.S. Department of
Environmental Protection

Google Earth

Image © 2025 Maxar Technologies
Image © 2025 Airbus

04/04/2025

4706100200P

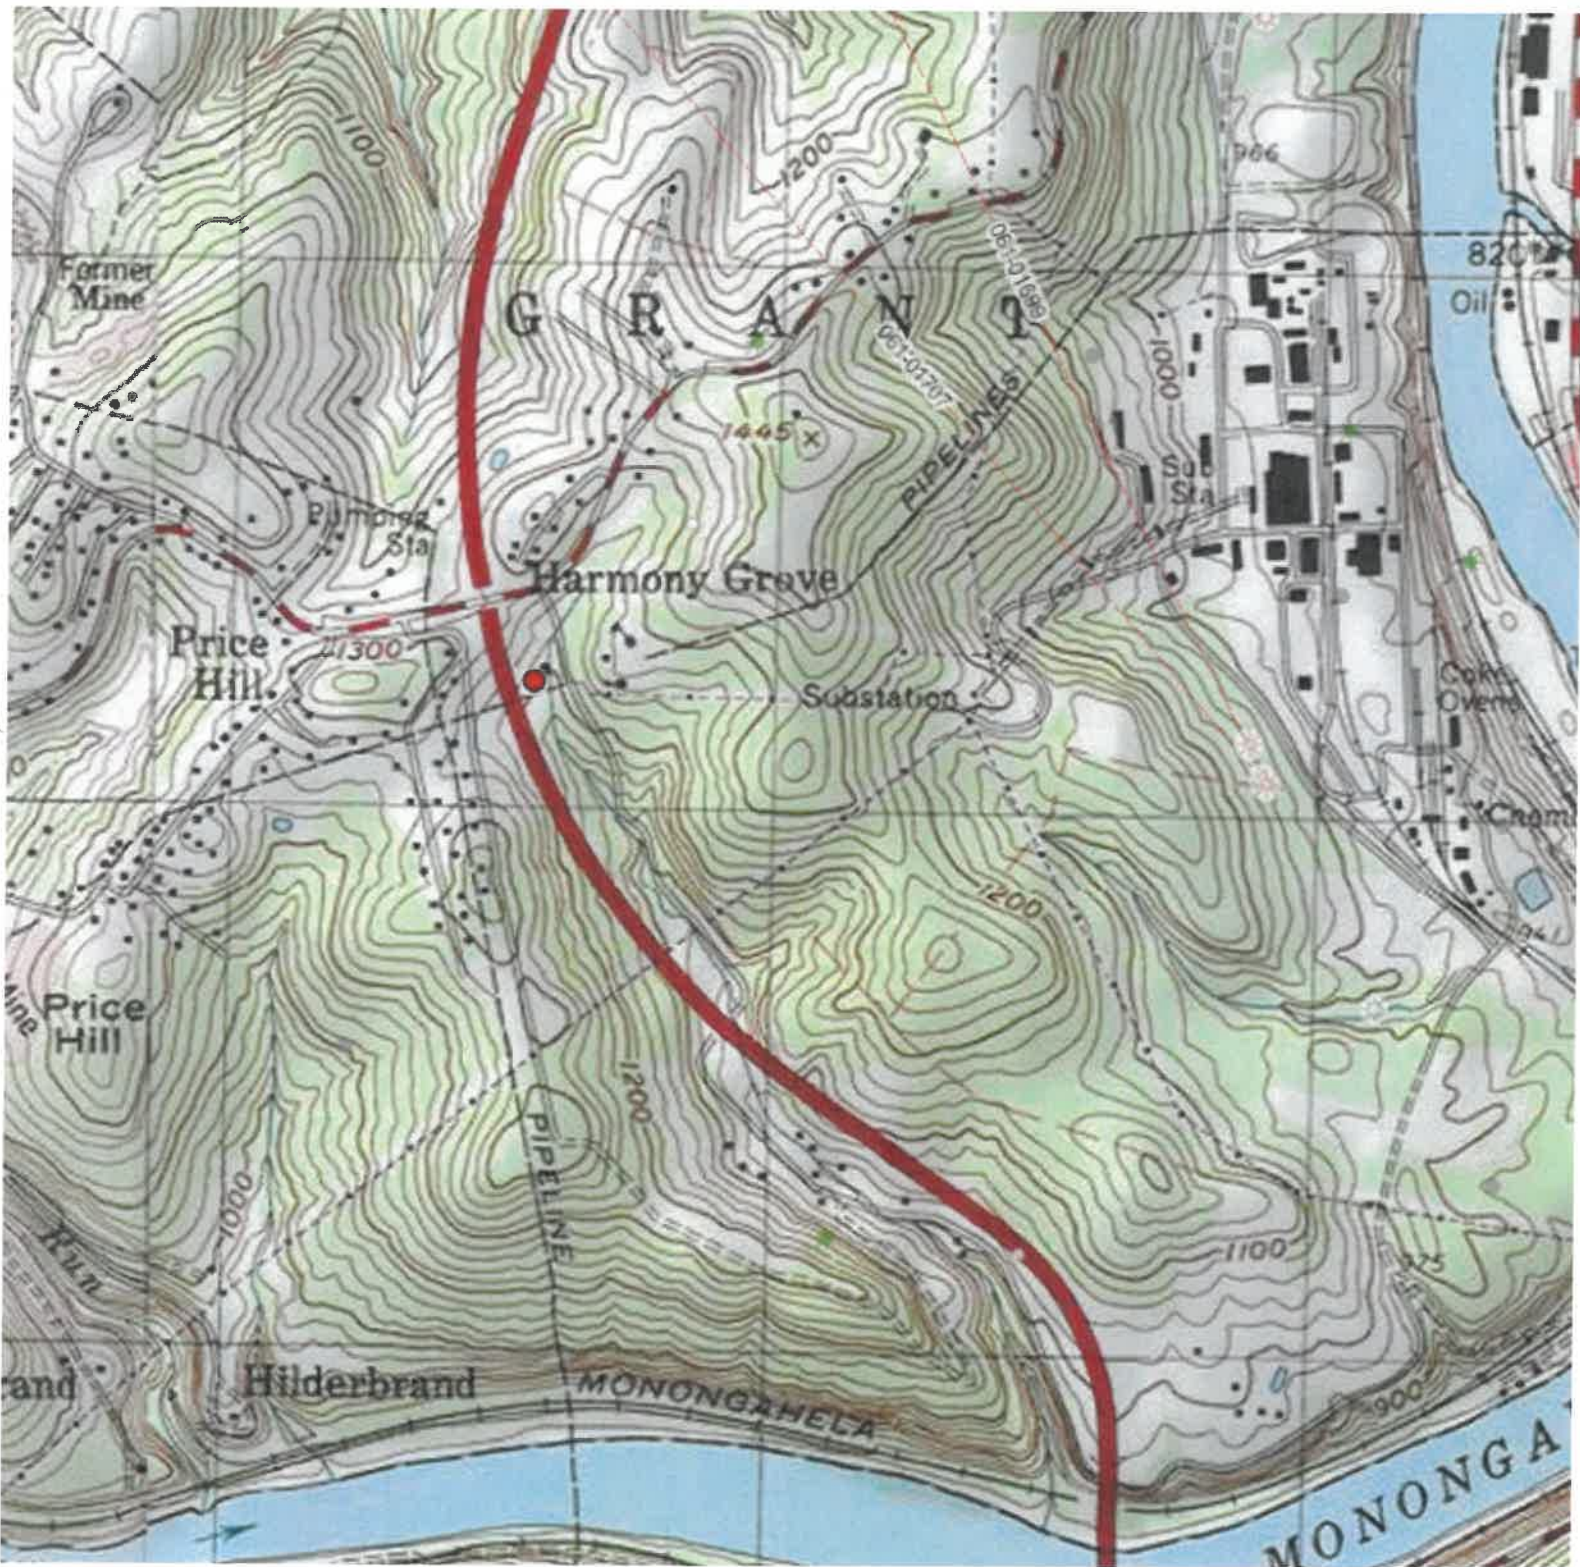

04/04/2025

4706100200P

WW-7
8-30-06



West Virginia Department of Environmental Protection
Office of Oil and Gas
WELL LOCATION FORM: GPS

API: 47-061-00200 WELL NO.: "99"

FARM NAME: DM Willis

RESPONSIBLE PARTY NAME: Noumenon Corporation

COUNTY: Monongalia DISTRICT: Grant

QUADRANGLE: Morgantown South 7.5"

SURFACE OWNER: JJDL, LLC WVDOT/DOH Right of Way

ROYALTY OWNER: Davis Lynch Glass Company

UTM GPS NORTHING: 4384233.9

UTM GPS EASTING: 586550.9 GPS ELEVATION: 373.0752 M ^{1224'}

The Responsible Party named above has chosen to submit GPS coordinates in lieu of preparing a new well location plat for a plugging permit or assigned API number on the above well. The Office of Oil and Gas will not accept GPS coordinates that do not meet the following requirements:

1. Datum: NAD 1983, Zone: 17 North, Coordinate Units: meters, Altitude: height above mean sea level (MSL) – meters.
2. Accuracy to Datum – 3.05 meters
3. Data Collection Method:

Survey grade GPS X: Post Processed Differential _____

Real-Time Differential X

Mapping Grade GPS _____: Post Processed Differential _____

Real-Time Differential _____

4. Letter size copy of the topography map showing the well location.

I the undersigned, hereby certify this data is correct to the best of my knowledge and belief and shows all the information required by law and the regulations issued and prescribed by the Office of Oil and Gas.

Philip B. [Signature] President Title 3/5/25 Date

RECEIVED
Office Of Oil and Gas
MAR 13 2025
WV Department of
Environmental Protection

04/04/2025