

New Location    
 Drill Deeper    
 Abandonment

Company HARRY J. SIGWART.  
 Address 732 Beechurst Ave., Morgantown W. Va.  
 Farm Seneca Glass Co.  
 Tract \_\_\_\_\_ Acres 2.65 Lease No. 1  
 Well (Farm) No. 1 Serial No. \_\_\_\_\_  
 Elevation (Spirit Level) 842.30  
 Quadrangle Morgantown n. W. Va. W.C.  
 County Monongalia District Morgan  
 Engineer Ralph E. Baker  
 Engineer's Registration No. 441  
 File No. 2-19D-228 Drawing No. 9168  
 Date Sept 14 1961 Scale: 1" = 100.0

STATE OF WEST VIRGINIA  
 DEPARTMENT OF MINES  
 OIL AND GAS DIVISION  
 CHARLESTON

WELL LOCATION MAP  
 FILE NO. MON-255

+ Denotes location of well on United States Topographic Maps, scale 1 to 62,500, latitude and longitude lines being represented by border lines as shown.

- Denotes one inch spaces on border line of original tracing.



STATE OF WEST VIRGINIA  
DEPARTMENT OF MINES  
OIL AND GAS DIVISION 8

Quadrangle Morgantown  
Permit No. MON-255

WELL RECORD

Oil or Gas Well Dry Hole  
(KIND)

Company Harry J. Sigwalt  
Address Morgantown W Va  
Farm Seneca Glass Acres 1.26  
Location (waters) Morgantown River  
Well No. 1 Elev. 842.30  
District Morgan County Morgantown  
The surface of tract is owned in fee by Seneca Glass  
Bechtel Ave Address Morgantown W Va  
Mineral rights are owned by Same  
Address \_\_\_\_\_


Drilling commenced Oct. 2, 1961  
Drilling completed Nov. 13, 1961  
Date Shot none From \_\_\_\_\_ To \_\_\_\_\_  
With \_\_\_\_\_

Open Flow 10/10ths Water in 5/8" Inch  
\_\_\_\_\_ /10ths Merc. in \_\_\_\_\_ Inch  
Volume 9,684 Cu. Ft.  
Rock Pressure 9 lbs. hrs.  
Oil \_\_\_\_\_ bbls., 1st 24 hrs.  
Fresh water 90 - feet 500 feet  
Salt water none feet \_\_\_\_\_ feet

Casing and Tubing	Used in Drilling	Left in Well	Packers
Size			Kind of Packer
18			
18	13	13	
10	29	29	Size of <u>Wood</u>
8 3/4	323'-5"	323'-5"	
6 3/4	909'-4"	909'-4"	Depth set
5 8/16			
8			Perf. top
2			Perf. bottom
Liners Used			Perf. top
			Perf. bottom

CASING CEMENTED None SIZE \_\_\_\_\_ No. Ft. \_\_\_\_\_ Date \_\_\_\_\_  
COAL WAS ENCOUNTERED AT 277 FEET 12 INCHES  
FEET INCHES FEET INCHES  
FEET INCHES FEET INCHES

Formation	Color	Hard or Soft	Top	Bottom	Oil, Gas or Water	Depth Found	Remarks
Clay	yellow	soft	0	30			
Sand	Blue	med	30	135	water	90 ft	hole full
Slaty Shells	Gray	med	135	277			
Coal	Black	soft	277	278			
Slaty Shells	gray	med	278	484			
1st Salt Sand	white	hard	484	570	water	500	hole full
Slaty Shells	Gray	med	570	720			
Maple Sand	white	hard	720	744			
Slaty Shells	Gray	med	744	790			
Red Rock	Red	soft	790	815			
Slaty Shells	Gray	med	815	868			
Red Rock	Red	soft	868	875			
Same	Gray	hard	875	885			
Slaty	Gray	soft	885	890			
Big Lime	Gray	hard	890	969			
Big Lime	Gray	hard	895	974			
Slaty	Gray	soft	969	979			
Sand	Red	hard	979	986			
Red rock	Red	med	986	1073	Gas	1055-1057	
371 Inj. Sand	Green	hard	986	1079	Gas	1051-1052	
Slaty	Gray	soft	1073	1079			
Sand	Red	med	1079	1130			

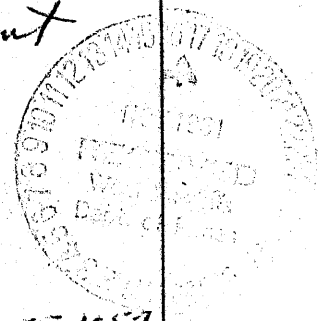

Formation	Color	Hard or Soft	Top $\delta$	Bottom	Oil, Gas or Water	Depth Found	Remarks
<del>Slaty Shells</del>	Gray	med	1130	1160			
Sand	Gray	<u>Hard</u>	1160	1215			
Slaty Shells	Gray	med	1215	1255			
Sand	White	<u>Hard</u>	1255	1268			
Slaty Shells	Gray	med	1268	1420			
Gritty limst	Black	<u>Hard</u>	1420	1430			
Brn Sand	Gray	med	1430	1438			
Slaty Shells	Gray	med	1438	1454	Gas	1430-1433	
			Total Depth <u>1454</u>				
			Total Gas test $\frac{10}{10}$ w/5/8" = 9684 Cuft. on completion of well				

Date Nov. 16, 1961  
 APPROVED Thos J. Sigurdson, Owner  
 By [Signature] Superintendent  
 (Title)