
11/13/23, 10:50 AM Capture.PNG



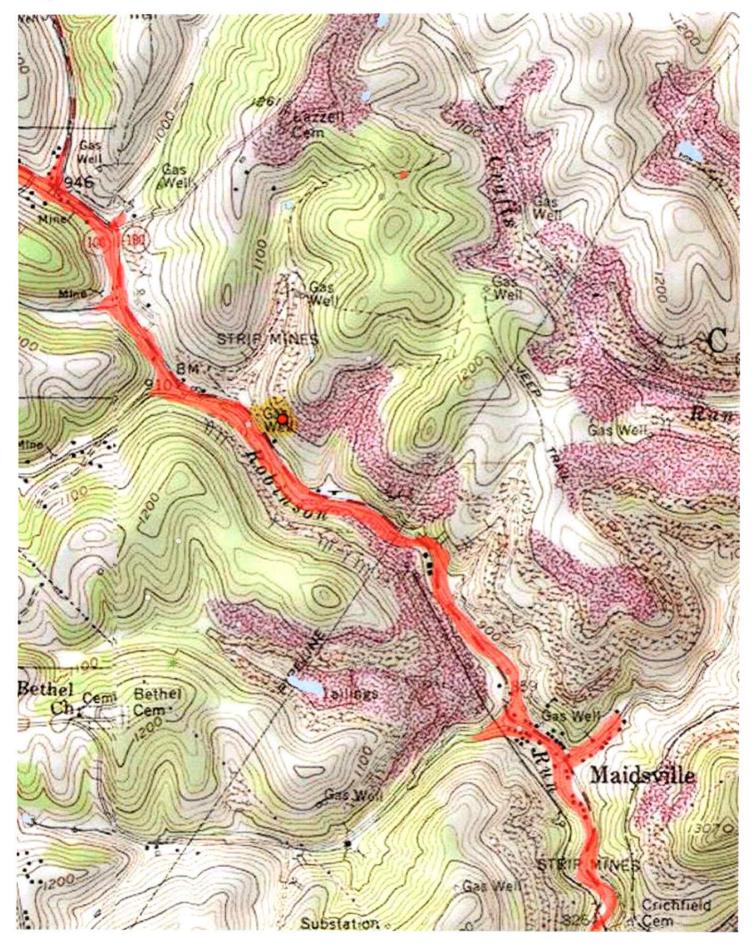

West Virginia Department of Environmental Protection Office of Oil and Gas

WELL LOCATION FORM: GPS

WELL LO	CATION FORM. GI	S
_{API:} 4706100260	WELL NO.:	Murphy 9615
FARM NAME: Murphy		
RESPONSIBLE PARTY NAME: DEP Paid Plugging Contract		
county: Monongalia	DISTRICT: C	ass
OUADRANGLE: Morgantown North		
SURFACE OWNER: Heller, Geoffrey R. Jr. & Kimberly A.		
ROYALTY OWNER: Richard A. Pultorak & Carol S.		
UTM GPS NORTHING: 5 86	363	
UTM GPS EASTING: 43 94	929 GPS ELEVA	TION: 1005'
preparing a new well location plat for above well. The Office of Oil and Gothe following requirements: 1. Datum: NAD 1983, Zone height above mean sea leterated above mean sea leterated. 2. Accuracy to Datum – 3.0 and Collection Method: Survey grade GPS: Post Prepare above well and the survey grade GPS: Post Prepare above well and the survey grade GPS: Post Prepare above well and the survey grade GPS: Post Prepare above well and the survey grade GPS: Post Prepare above well and GPS: Post Prepare above well. The office of Oil and GPS: Post Prepare above well. The Office of Oil and GPS: Post Prepare above well. The Office of Oil and GPS: Post Prepare above well. The Office of Oil and GPS: Post Prepare above well. The Office of Oil and GPS: Post Prepare above well. The Office of Oil and GPS: Post Prepare above well. The Office of Oil and GPS: Post Prepare above well. The Office of Oil and GPS: Post Prepare above well. The Office of Oil and GPS: Post Prepare above well. The Office of Oil and GPS: Post Prepare above well. The Office of Oil and GPS: Post Prepare above well. The Oil and GPS: Post Pr	as will not accept GPS coordin e: 17 North, Coordinate Units: revel (MSL) – meters. 5 meters	ates that do not meet
	ime Differential	
Mapping Grade GPS X: Post Processed Differential		
Rea	l-Time Differential	
4. Letter size copy of the t I the undersigned, hereby certify this belief and shows all the information prescribed by the Office of Oil and O	required by law and the regular	y knowledge and
Bryan Harris	Inspector Specialist	Oct 12, 2023
Signature	Title	Date