

WW-7
8-30-06



West Virginia Department of Environmental Protection
Office of Oil and Gas
WELL LOCATION FORM: GPS

API: 47-061-00372 WELL NO.: 7146

FARM NAME: Dalton

RESPONSIBLE PARTY NAME: Sarah Weigand / CONSOL GAS COMPANY

COUNTY: Monongalia DISTRICT: Clinton

QUADRANGLE: Morgantown South

SURFACE OWNER: MICHAEL E & ZACHARY M MCMILLEN

ROYALTY OWNER: WAYNE DALTON

UTM GPS NORTHING: 4,377,662.702 METERS (1963')

UTM GPS EASTING: 594,431.302 METERS GPS ELEVATION: 598.368 METERS

The Responsible Party named above has chosen to submit GPS coordinates in lieu of preparing a new well location plat for a plugging permit or assigned API number on the above well. The Office of Oil and Gas will not accept GPS coordinates that do not meet the following requirements:

1. Datum: NAD 1983, Zone: 17 North, Coordinate Units: meters, Altitude: height above mean sea level (MSL) – meters.
2. Accuracy to Datum – 3.05 meters
3. Data Collection Method:

Survey grade GPS : Post Processed Differential

Real-Time Differential

Mapping Grade GPS : Post Processed Differential

Real-Time Differential

4. **Letter size copy of the topography map showing the well location.**

I the undersigned, hereby certify this data is correct to the best of my knowledge and belief and shows all the information required by law and the regulations issued and prescribed by the Office of Oil and Gas.

RECEIVED
Office of Oil and Gas


OCT 12 2017

WV Department of
Environmental Protection

Sarah Weigand Permitting Manager
Signature Title

9/28/17
Date

12/08/2017

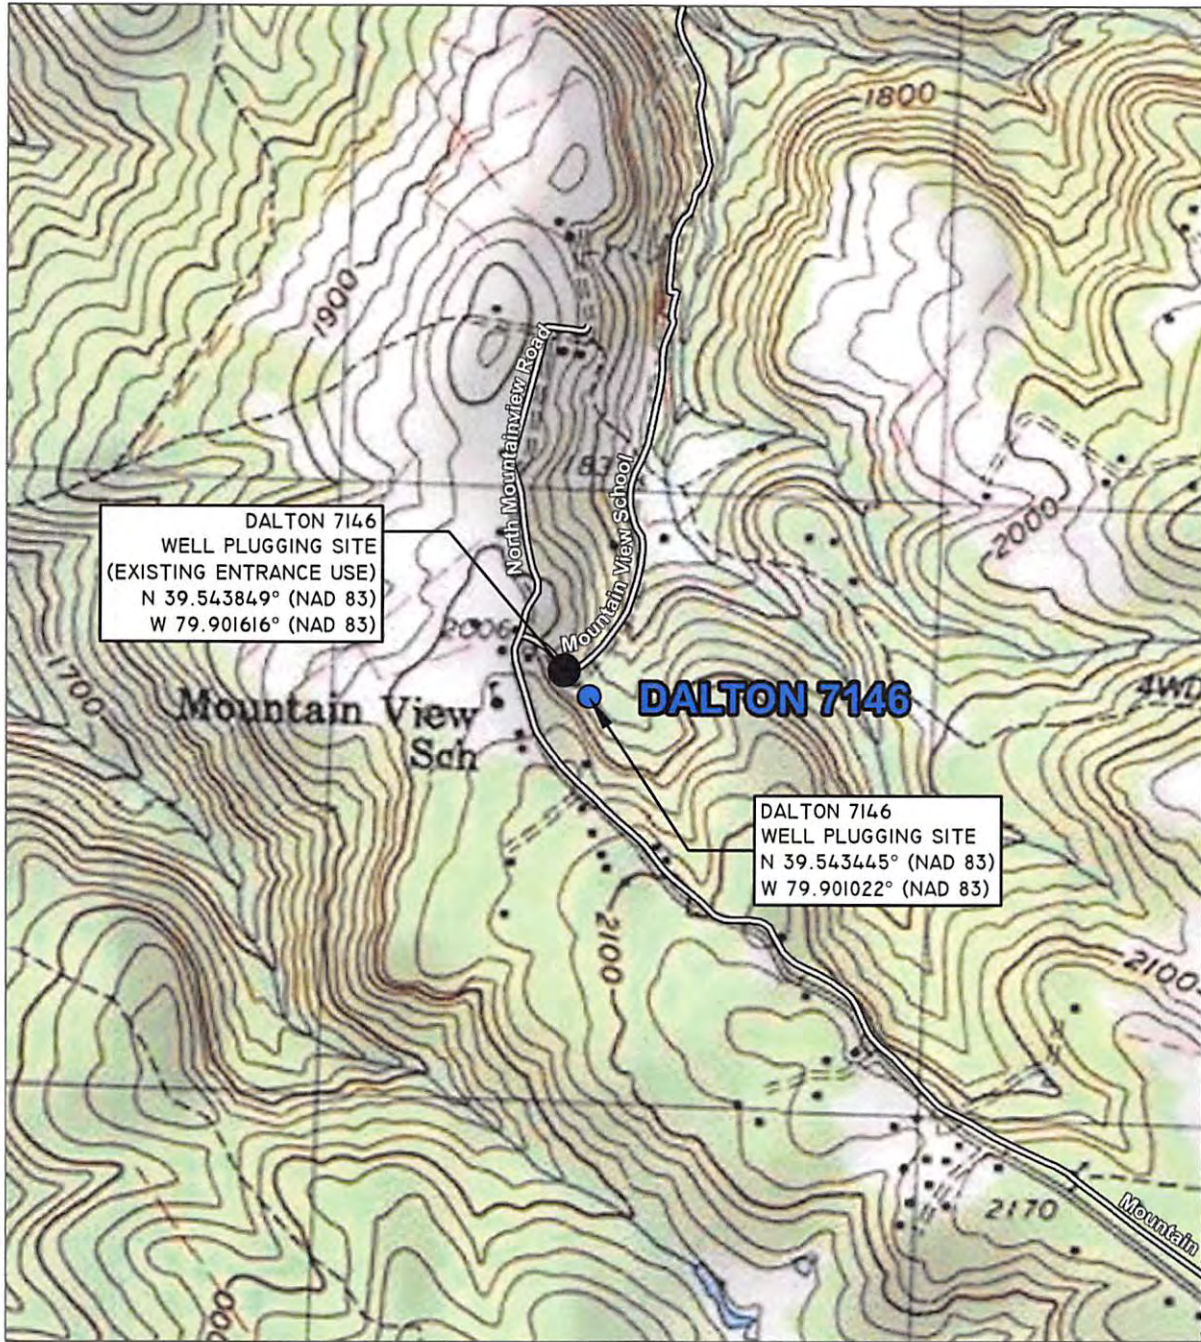

RECEIVED
Office of Oil and Gas
OCT 12 2017
WV Department of
Environmental Protection

LOCATION MAP
MORGANTOWN SOUTH, WV 7.5M USGS QUADRANGLE
SCALE: 1"=1000'



Engineers and Land Surveyors
Woman Owned Small Business

11023 Mason Dixon Hwy.
Burton, WV 26562-9656
(304) 662-6486

LOCATION MAP
GAS WELL PLUGGING
DALTON 7146 GAS WELL
CLINTON DISTRICT
MONONGALIA COUNTY, WV

CONSOL GAS COMPANY
200 HALLAM ROAD
WASHINGTON, PA 15301

DRAWN BY: LLF
CHECKED BY: WPF
DATE: 07/19/2017
SCALE: 1"=1000'
WATERSHED:
COBUN CREEK-MONONGAHELA RIVER

PAGE 1 OF 2