






Diversified Gas & Oil
Corporation
100 Diversified Way
Pikeville KY, 41051

47-061-00384

Well Plugging Map

Legend

- Well
- Access Road
- Pits
- Pad
- Public Roads

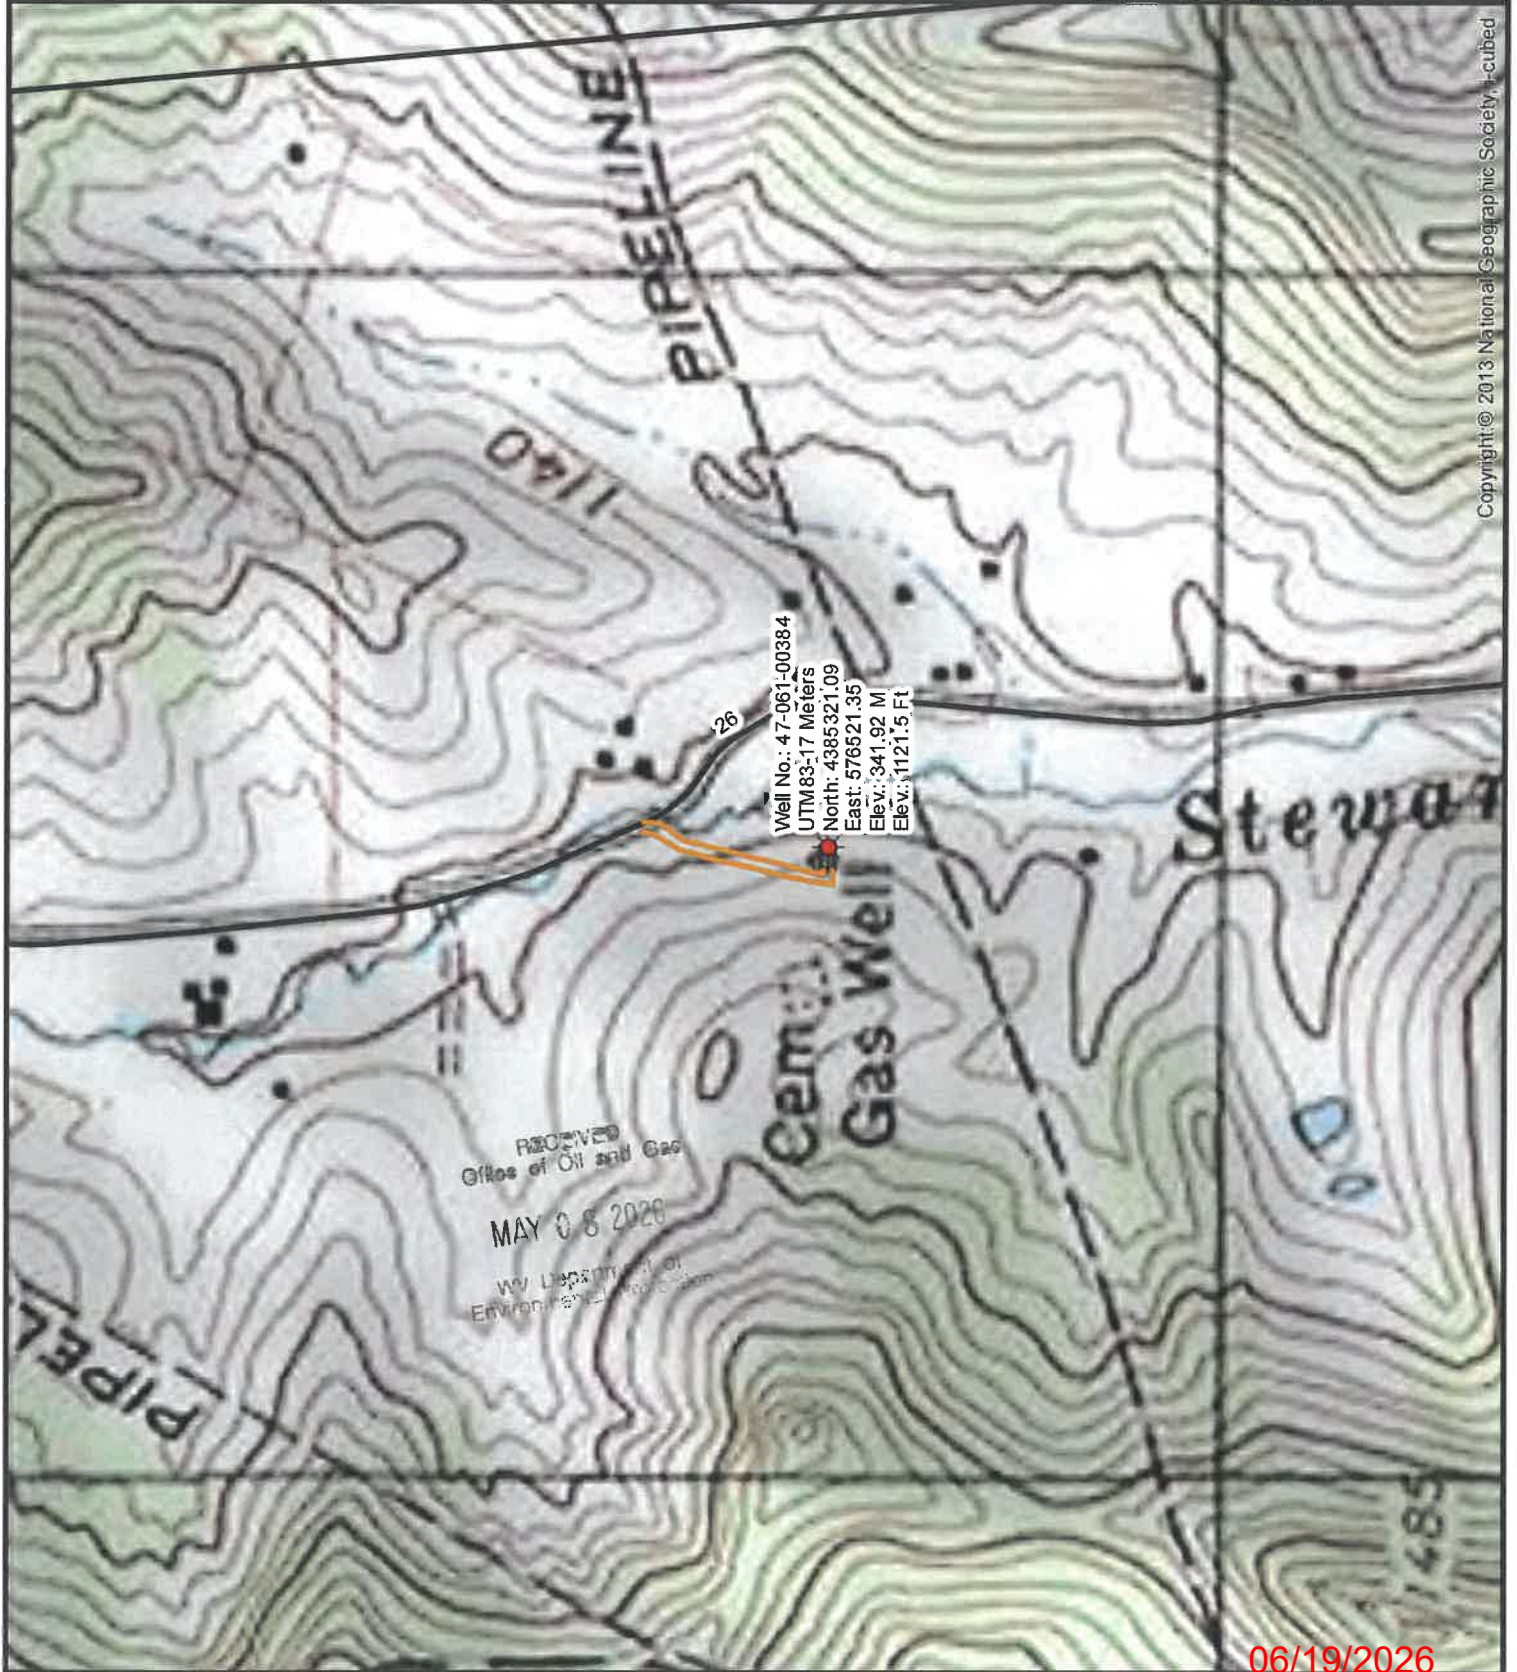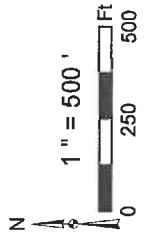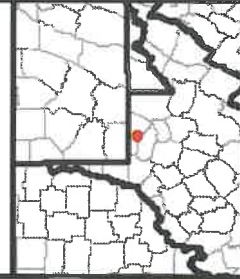



Diversified Gas & Oil
Corporation
100 Diversified Way
Pikeville KY, 41051


06/19/2026

47-061-00384

Well Plugging Map

Legend

-  Well
-  Access Road
-  Pits
-  Pad
-  Public Roads

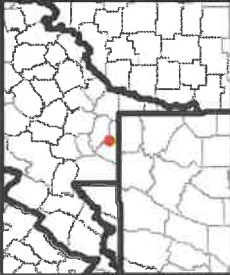

Source: Esri, Imagery, Earthstar, Geography, and the GIS User Community



West Virginia Department of Environmental Protection
Office of Oil and Gas
WELL LOCATION FORM: GPS

API: 4706100384 WELL NO.: MICHEL W-2968
FARM NAME: N.E. Michael
RESPONSIBLE PARTY NAME: Diversified Production, LLC
COUNTY: Monongalia DISTRICT: Grant
QUADRANGLE: Rivesville 7.5'
SURFACE OWNER: Tammy Lynn & Kris B. Campbell
ROYALTY OWNER: Tammy Lynn Campbell
UTM GPS NORTHING: 4385321.09
UTM GPS EASTING: 576521.35 GPS ELEVATION: 1121.5'

The Responsible Party named above has chosen to submit GPS coordinates in lieu of preparing a new well location plat for a plugging permit or assigned API number on the above well. The Office of Oil and Gas will not accept GPS coordinates that do not meet the following requirements:

1. Datum: NAD 1983, Zone: 17 North, Coordinate Units: meters, Altitude: height above mean sea level (MSL) – meters.
2. Accuracy to Datum – 3.05 meters
3. Data Collection Method:

Survey grade GPS ____: Post Processed Differential ____


Real-Time Differential ____

Mapping Grade GPS X: Post Processed Differential X

Real-Time Differential ____

4. Letter size copy of the topography map showing the well location.

I the undersigned, hereby certify this data is correct to the best of my knowledge and belief and shows all the information required by law and the regulations issued and prescribed by the Office of Oil and Gas.

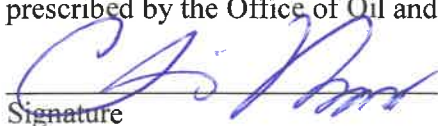
Signature

Chris Veazey - Director of Administration
Title

5/6/2016
Date

RECEIVED
Office of Oil and Gas
MAY 08 2016
WV Department of
Environmental Protection

06/19/2026