


LATITUDE 39° 40' 00"

08, 40, 08 LONGITUDE

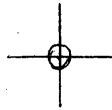

7'5 OGIS topo location

7.5' loc 1.075 15' loc _____
' 1.45w (calc.) _____

Company _____

Farm _____

Quad BLACKSVILLE 7 1/2'


County MONONGALIA

District CLAY

Class 1370 ± (TOPO)

WELL LOCATION MAP

File No. 061-0449

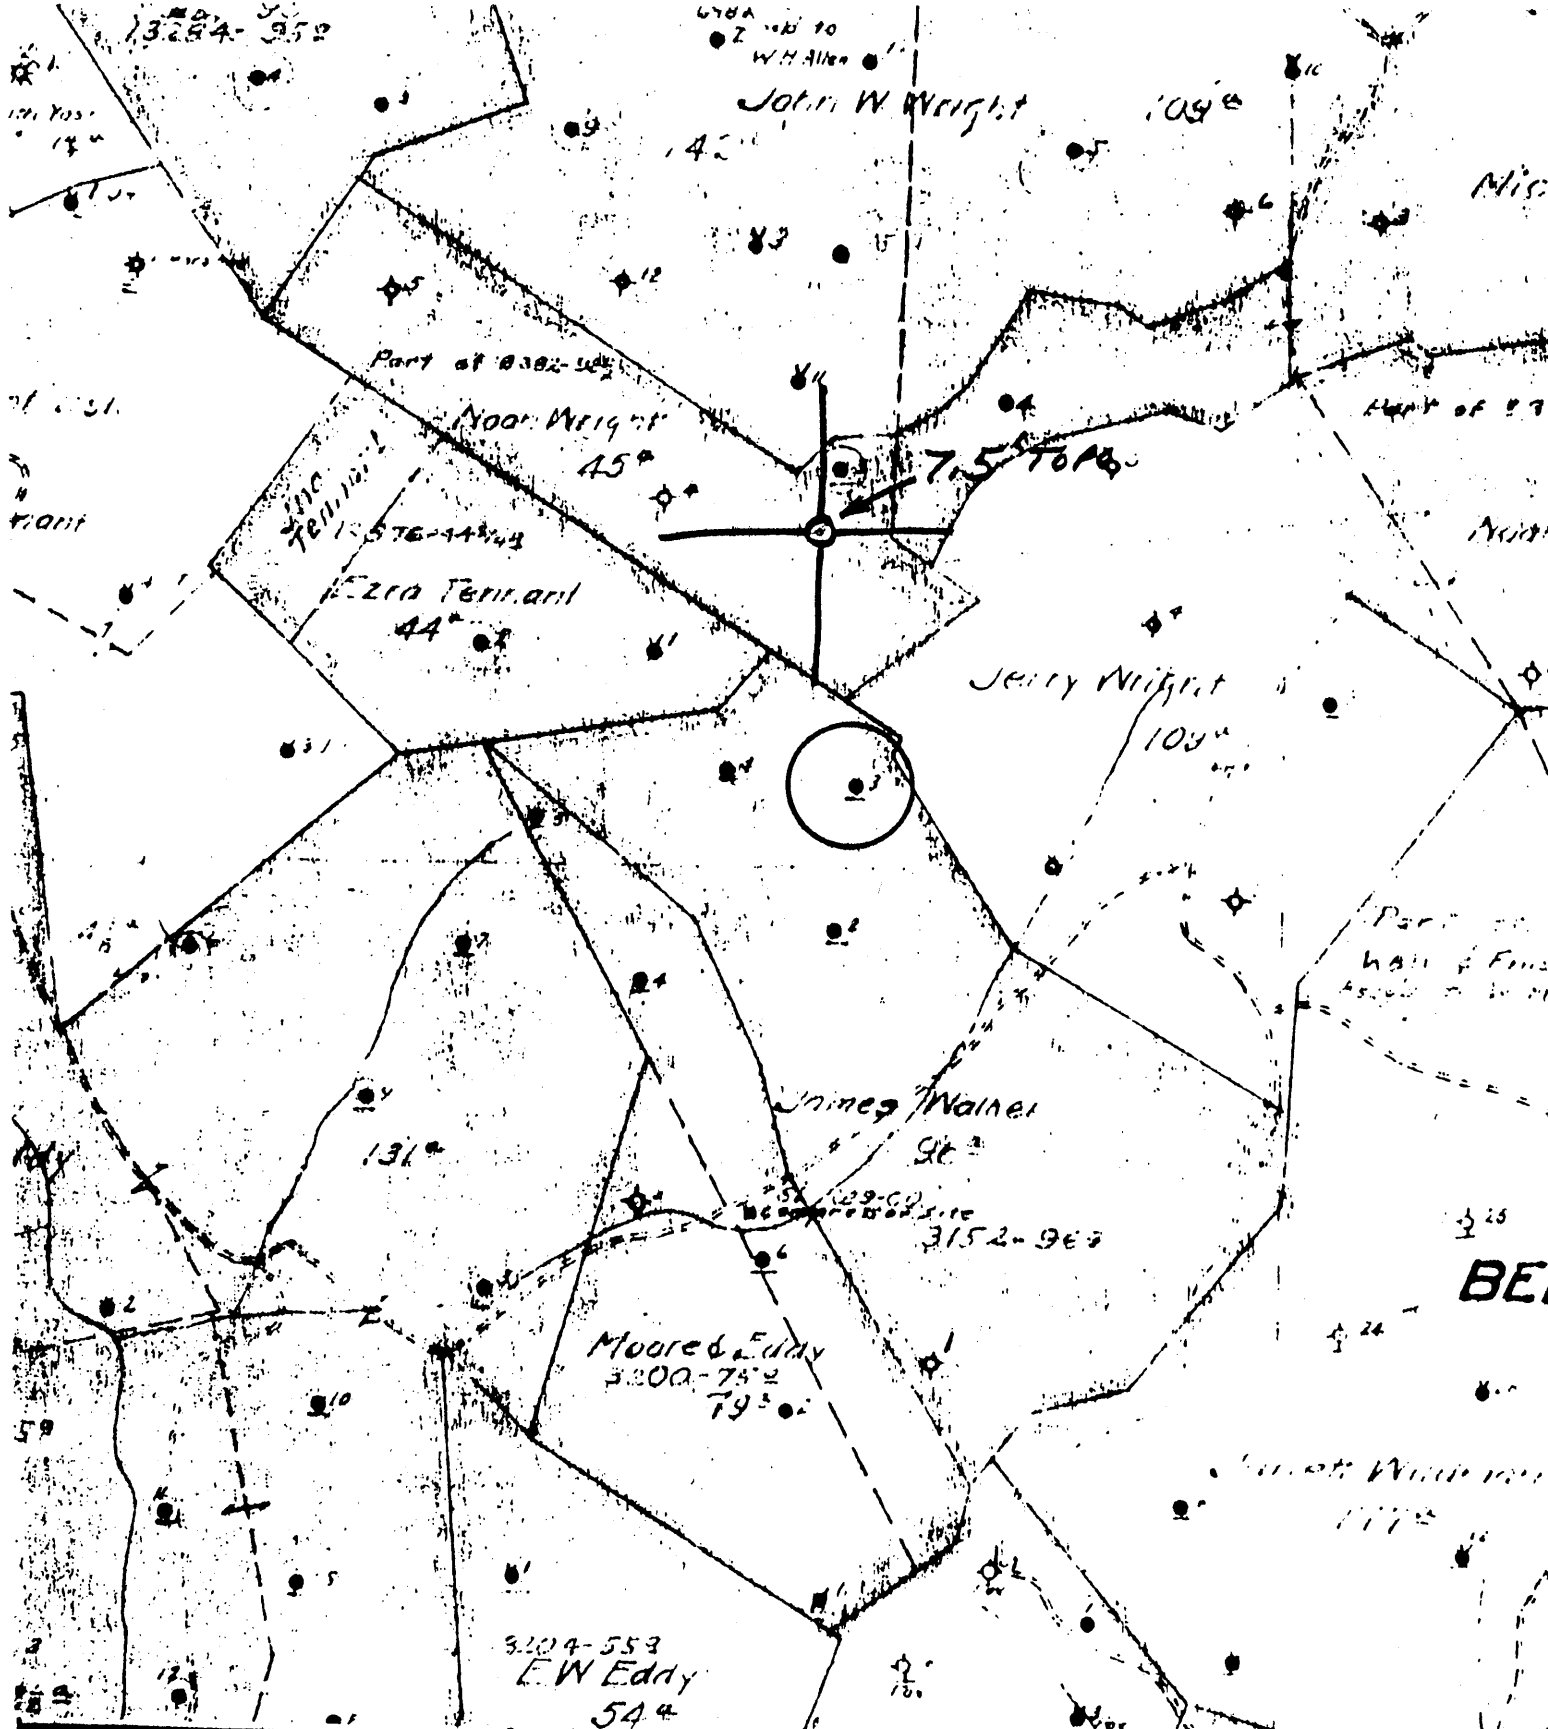

(+) DENOTES LOCATION OF WELL ON UNITED STATES TOPOGRAPHIC MAPS
 FORM IV-6
 (8-78)
 N72E N13 E26



DATE 1-24-1979
 OPERATOR'S WELL NO. 3
 API WELL NO. 47-261-0449
 STATE COUNTY PERMIT

STATE OF WEST VIRGINIA
 DEPARTMENT OF MINES
 OIL AND GAS DIVISION

WELL TYPE: OIL GAS LIQUID INJECTION WASTE DISPOSAL
 (IF "GAS", PRODUCTION STORAGE DEEP SHALLOW
 LOCATION: ELEVATION _____ WATER SHED JAMES RUN
 DISTRICT CLAY COUNTY MONONGALIA
 QUADRANGLE BLACKVILLE 7.5'
 SURFACE OWNER _____ ACREAGE _____
 OIL & GAS ROYALTY OWNER _____ LEASE NO. _____ LEASE ACREAGE _____
 PROPOSED WORK: DRILL CONVERT DRILL DEEPER REDRILL FRACTURE OR STIMULATE PLUS OFF OLD FORMATION PERFORATE NEW FORMATION OTHER PHYSICAL CHANGE IN WELL (SPECIFY) _____

PLUS AND ABANDON CLEAN OUT AND REPLUG
 TARGET FORMATION _____ ESTIMATED DEPTH _____
 WELL OPERATOR Pennzoil Company DESIGNATED AGENT James A. Crews
 ADDRESS P. O. Box 1588 ADDRESS P. O. Box 1588
Parkersburg, WV 26101 Parkersburg, WV 26101

J.S. WALKER-3

SOUTH PENN OIL COMPANY—COMPLETION

SERIAL NO. _____ FARM Walker J. S. WELL NO. 3
 ELEVATION _____ N. 13-14 S. _____ E. 26 W. _____
 LEASE NO. _____ ACRES 96
 WATERS OF Jakes Run
 DISTRICT Clay COUNTY Monongalia STATE W. Va.
 DRILLING COMMENCED 3/27/1923 COMPLETED 5/29/1923 DEPTH 2262

| SANDS | TOP | BOTTOM | ELEV. TOP | CASING Used. |
|-----------------------|------|--------|-----------|--------------|
| POH. COAL OR BIG LIME | 330 | | | 10" 850 |
| Big Injun | 2130 | | | 8 1/4" 860 |
| 1st. pay | 2225 | | | 6 5/8" 1855 |
| | | | | 5 3/16" 2138 |
| PACKERS AND DEPTH SET | | | | |

INITIAL PROD. No record SAND Big Injun DEPTH 2225
 GAS TEST. NO
 SHOT 5 QUARTS 4 to 40
 REMARKS (Not drilled through Big Injun)

REPORTED BY _____
 P. O. 524 5M-10-24

ABANDONED

47-061-0449

SOUTH PENN OIL COMPANY—COMPLETION

SERIAL NO. _____ FARM [REDACTED] WELL NO. [REDACTED]
 ELEVATION _____ N. 13-14 S. _____ E. 26 W. _____
 LEASE NO. _____ ACRES 96
 WATERS OF Jakes Run
 DISTRICT Clay COUNTY Monongalia STATE W. Va.
 DRILLING COMMENCED 7/27/1923 COMPLETED 7/29/1923 DEPTH 2262

| SANDS | TOP | BOTTOM | ELEV. TOP | CASING Used, |
|-----------------------|------|--------|-----------|--------------|
| POH. COAL OR BIG LIME | 330 | | | 10" 850 |
| Big Injun | 2130 | | | 8 1/4" 860 |
| 1st pay | 2225 | | | 6 1/8" 1855 |
| | | | | 5 3/16" 2138 |
| PACKERS AND DEPTH SET | | | | |

INITIAL PROD. No record SAND Big Injun DEPTH 2225
 GAS TEST NO
 SHOT 5 QUARTS 4 to 40
 REMARKS (Not drilled through Big Injun)

REPORTED BY [Signature] ABANDONED

RECEIVED

DEC 17 1926

OIL & GAS DIVISION
 DEPT. OF MINES

47-061-044