

WW-7
8-30-06



West Virginia Department of Environmental Protection
Office of Oil and Gas
WELL LOCATION FORM: GPS

API: 47-061-00449 WELL NO.: 3

FARM NAME: J.S. Walker

RESPONSIBLE PARTY NAME: NNE Resources LLC

COUNTY: Monongalia DISTRICT: Clay

QUADRANGLE: Blacksville'

SURFACE OWNER: David P. Walker, et al

ROYALTY OWNER: Linda Kay Tennant, et al

UTM GPS NORTHING: 4389392.8

UTM GPS EASTING: 572724.9 GPS ELEVATION: 1379'

The Responsible Party named above has chosen to submit GPS coordinates in lieu of preparing a new well location plat for a plugging permit or assigned API number on the above well. The Office of Oil and Gas will not accept GPS coordinates that do not meet the following requirements:

1. Datum: NAD 1983, Zone: 17 North, Coordinate Units: meters, Altitude: height above mean sea level (MSL) – meters.
2. Accuracy to Datum – 3.05 meters
3. Data Collection Method:

Survey grade GPS _____ : Post Processed Differential _____
Real-Time Differential _____

Mapping Grade GPS X : Post Processed Differential _____
Real-Time Differential X

4. **Letter size copy of the topography map showing the well location.**


I the undersigned, hereby certify this data is correct to the best of my knowledge and belief and shows all the information required by law and the regulations issued and prescribed by the Office of Oil and Gas.

[Signature]
Signature

General Manager - Operations
Title

14 OCT 2016
Date

JS WALKER NO. 3
 47-061-0049
 Northing: 4389392.8
 Easting: 572724.9
 Elevation: 1379'
 Blacksville 7.5 ' Quad

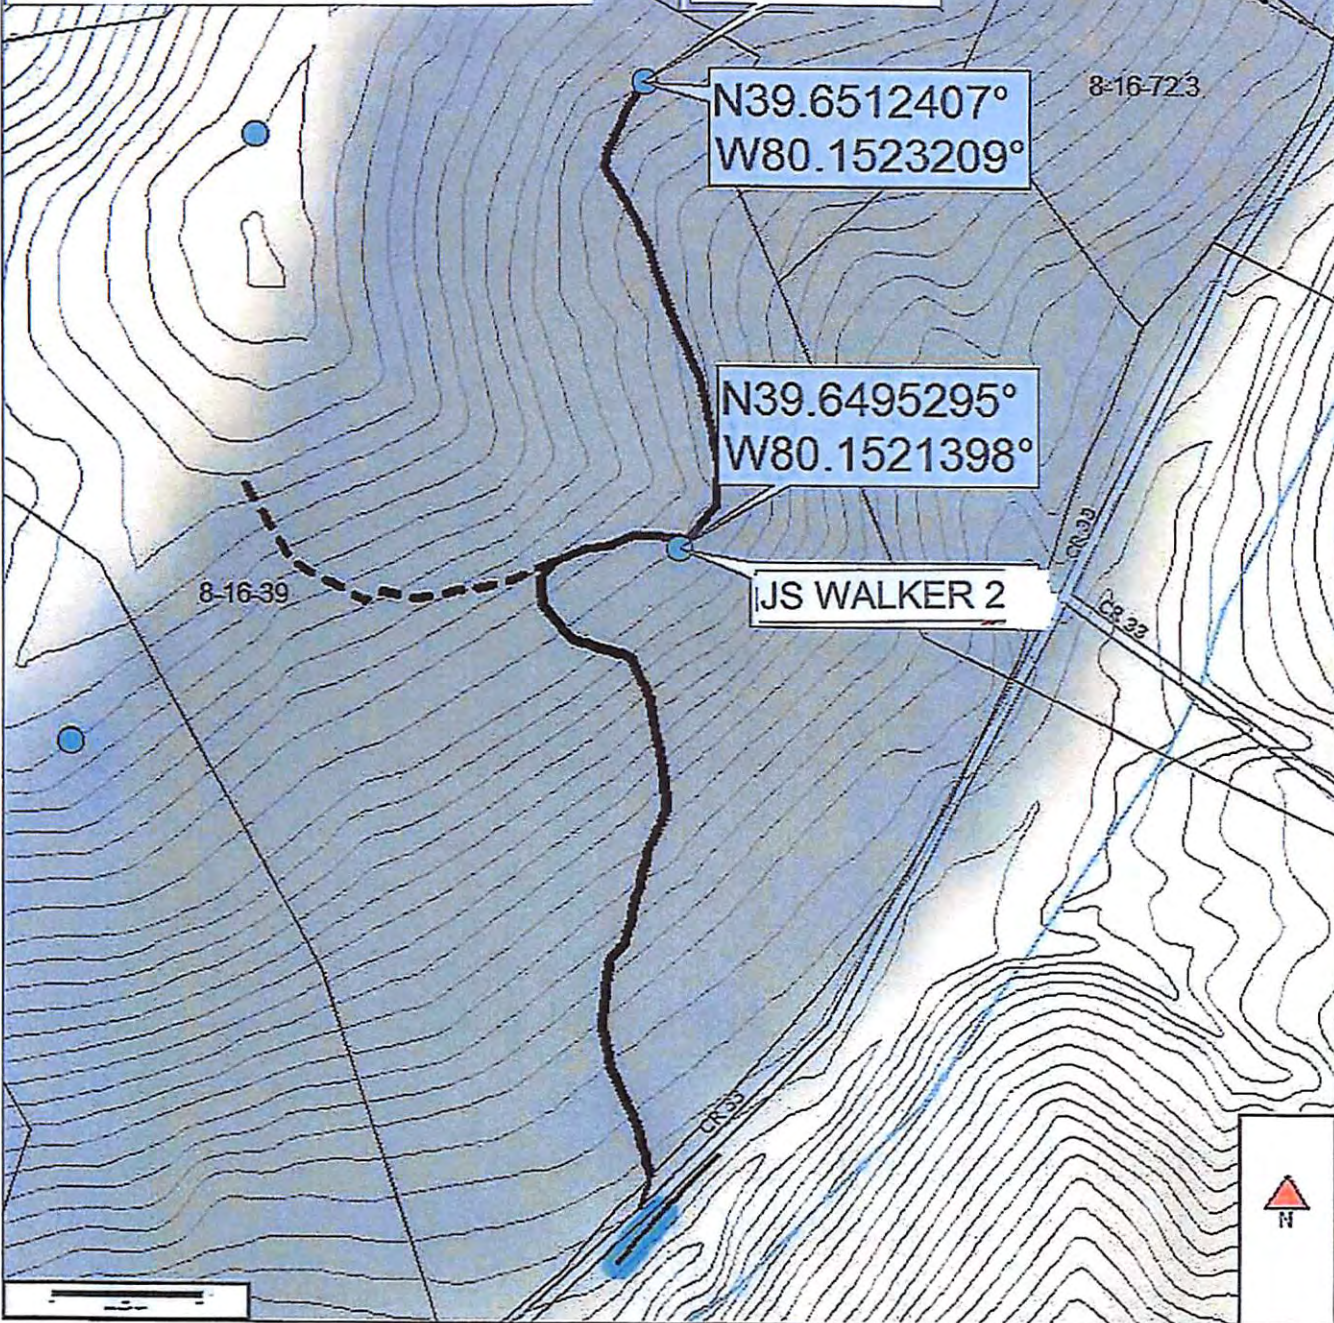

Data use subject to license.

© DeLorme. XMap® 7.

www.delorme.com