


LATITUDE 39° 40' 00"

00 51 08

LONGITUDE

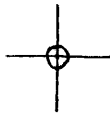

7.5 OGIS topo location

7.5' loc 2.65 S  
1.69 W

15' loc \_\_\_\_\_  
(calc.) \_\_\_\_\_

Company \_\_\_\_\_

Farm \_\_\_\_\_

Quad WADESTOWN 7 1/2'


County MONONGALIA

District BATTELLE

Elev. 1160 ± (TOPO)

WELL LOCATION MAP

File No. 061-0495

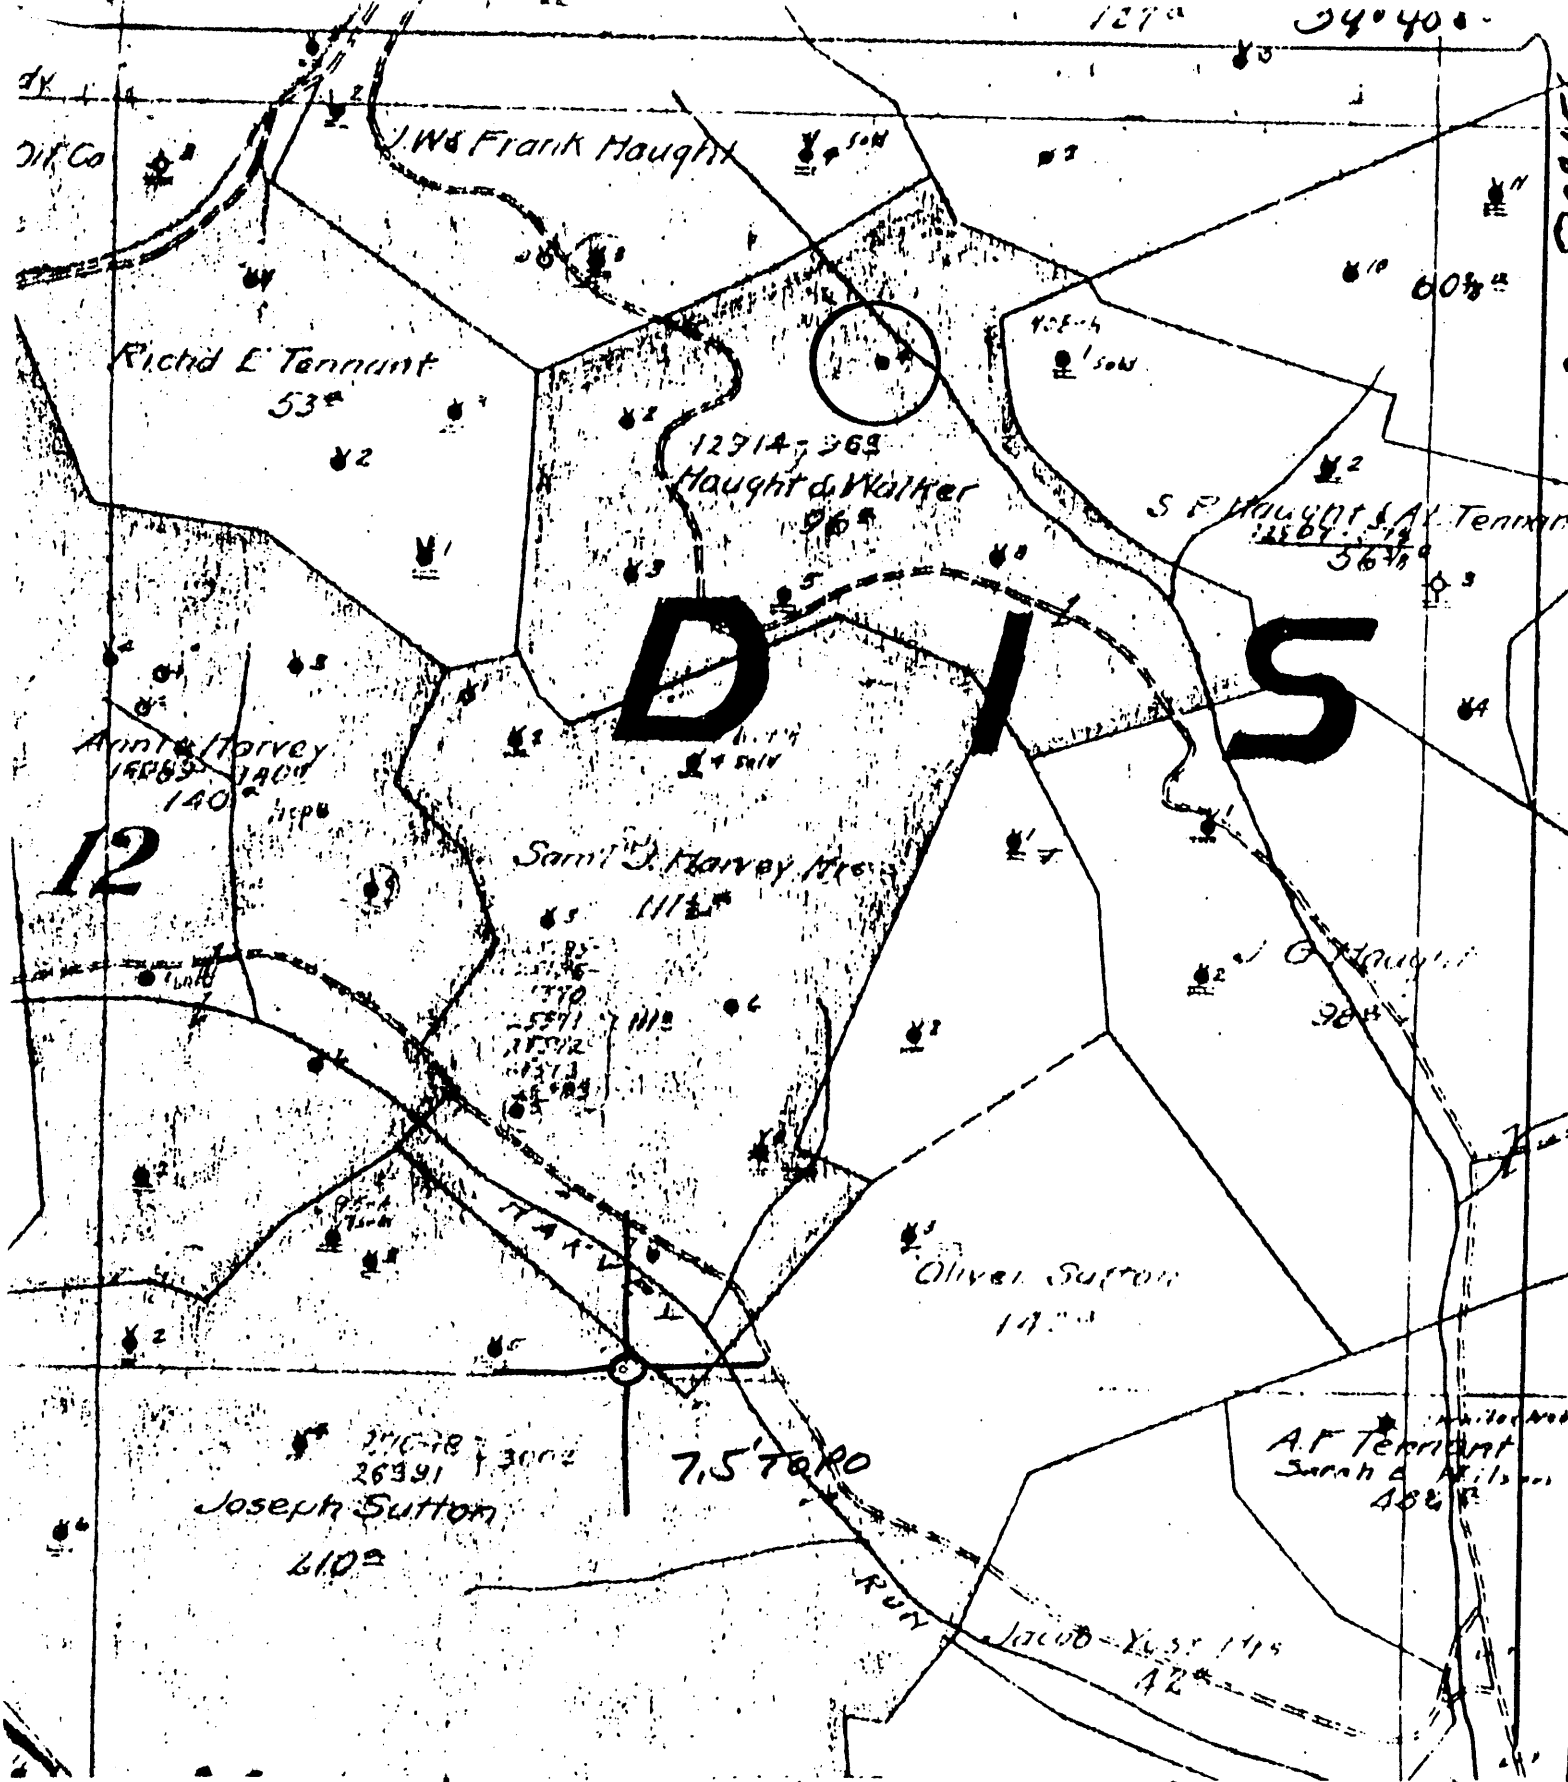

(\*) DENOTES LOCATION OF WELL ON UNITED STATES TOPOGRAPHIC MAPS  
 FORM IV-6  
 8-78  
 16E N12W20



DATE 1-24-1979  
 OPERATOR'S WELL NO. 4  
 API WELL NO. 47-061-0495  
 STATE COUNTY PERMIT

STATE OF WEST VIRGINIA  
 DEPARTMENT OF MINES  
 OIL AND GAS DIVISION

WELL TYPE: OIL  GAS \_\_\_\_\_ LIQUID INJECTION \_\_\_\_\_ WASTE DISPOSAL \_\_\_\_\_  
 (IF "GAS", PRODUCTION \_\_\_\_\_ STORAGE \_\_\_\_\_ DEEP \_\_\_\_\_ SHALLOW \_\_\_\_\_)  
 LOCATION: ELEVATION \_\_\_\_\_ WATER SHED PAW PAW CK  
 DISTRICT BATTELLE COUNTY MONONGALIA  
 QUADRANGLE WADESTOWN 7.5'  
 SURFACE OWNER \_\_\_\_\_ ACREAGE \_\_\_\_\_  
 OIL & GAS ROYALTY OWNER \_\_\_\_\_ LEASE ACREAGE \_\_\_\_\_  
 LEASE NO. \_\_\_\_\_  
 PROPOSED WORK: DRILL \_\_\_\_\_ CONVERT \_\_\_\_\_ DRILL DEEPER \_\_\_\_\_ REDRILL \_\_\_\_\_ FRACTURE OR  
 STIMULATE \_\_\_\_\_ PLUS OFF OLD FORMATION \_\_\_\_\_ PERFORATE NEW  
 FORMATION \_\_\_\_\_ OTHER PHYSICAL CHANGE IN WELL (SPECIFY) \_\_\_\_\_  
 PLUG AND ABANDON \_\_\_\_\_ CLEAN OUT AND REPLUG \_\_\_\_\_  
 TARGET FORMATION \_\_\_\_\_ ESTIMATED DEPTH \_\_\_\_\_  
 WELL OPERATOR Pennzoil Company DESIGNATED AGENT James A. Crews  
 ADDRESS P. O. Box 1588 ADDRESS P. O. Box 1588  
Parkersburg, WV 26101 Parkersburg, WV 26101

10.16.147 (J) WALKER - 4

Well No. 74 aught Walker Town  
 Lease No. 13 Attelle District Monongalia County  
 Rig built by O. W. D. D.  
 Well drilled by So. Penn. Oil Co Contractor  
 Began drilling June 17 1905 Completed June 30 1905

ROCK FORMATION.	TOP.	BOTTOM.	REMARKS.
Gordon Lomp	3138	3141	
$\frac{1}{4}$ Sand	3144		
Oil	315-		
Depth		3172 1/2	

**CASING RECORD.**

Min.	CHARGED TO WELL.		PUT IN WELL.		PULLED OUT.		LEFT IN WELL.		Transferred before Completion.	Left at Well Not in Use.
	Feet	In.	Feet	In.	Feet	In.	Feet	In.		
	no change.									

Production First 24 Hours }      Bbls Signed J. B. Greary Sup.

47-061-0495