

RECEIVED  
Office of Oil & Gas

MAR 13 2012

West Virginia Department of Environmental Protection  
Office of Oil & Gas

WV Department of  
Environmental Protection

WELL LOCATION FORM: GPS

API: 47- 061 0567 P WELL NO: No. 3

FARM NAME: Fox Heirs

RESPONSIBLE PARTY NAME: East Resources, Inc.

COUNTY: Monongalia DISTRICT: Battelle

QUADRANGLE: Wadestown 7.5'

SURFACE OWNER: Dickinson Fuel Company NA

ROYALTY OWNER: East Resources, Inc. et al.

UTM GPS NORTHING: 4,393,144 (NAD 83)

UTM GPS EASTING: 563,193 (NAD 83) GPS ELEVATION: 323 m.

The Responsible Party named above has chosen to submit GPS coordinates in lieu of preparing a new well location plat for a plugging permit on the above well. The Office of Oil & Gas will not accept GPS coordinates that do not meet the following requirements:

1. Datum: NAD 1983, Zone:17 North, Coordinate Units: meters, Altitude: height above mean sea level (MSL) - meters.
2. Accuracy to Datum - 3.05 meters
3. Data Collection Method:

Survey Grade GPS  Post Processed Differential   
 Real-Time Differential

Mapping Grade GPS  Post Processed Differential   
 Real-Time Differential


I the undersigned, hereby certify this data is correct to the best of my knowledge and belief and shows all the information required by law and the regulations issued and prescribed by the Office of Oil and Gas.

Diane C White Diane C White  
Signature

Accountant  
Title

March 8, 2012  
Date

SUBJECT WELL  
Fox Heirs No.3  
47-061-0567

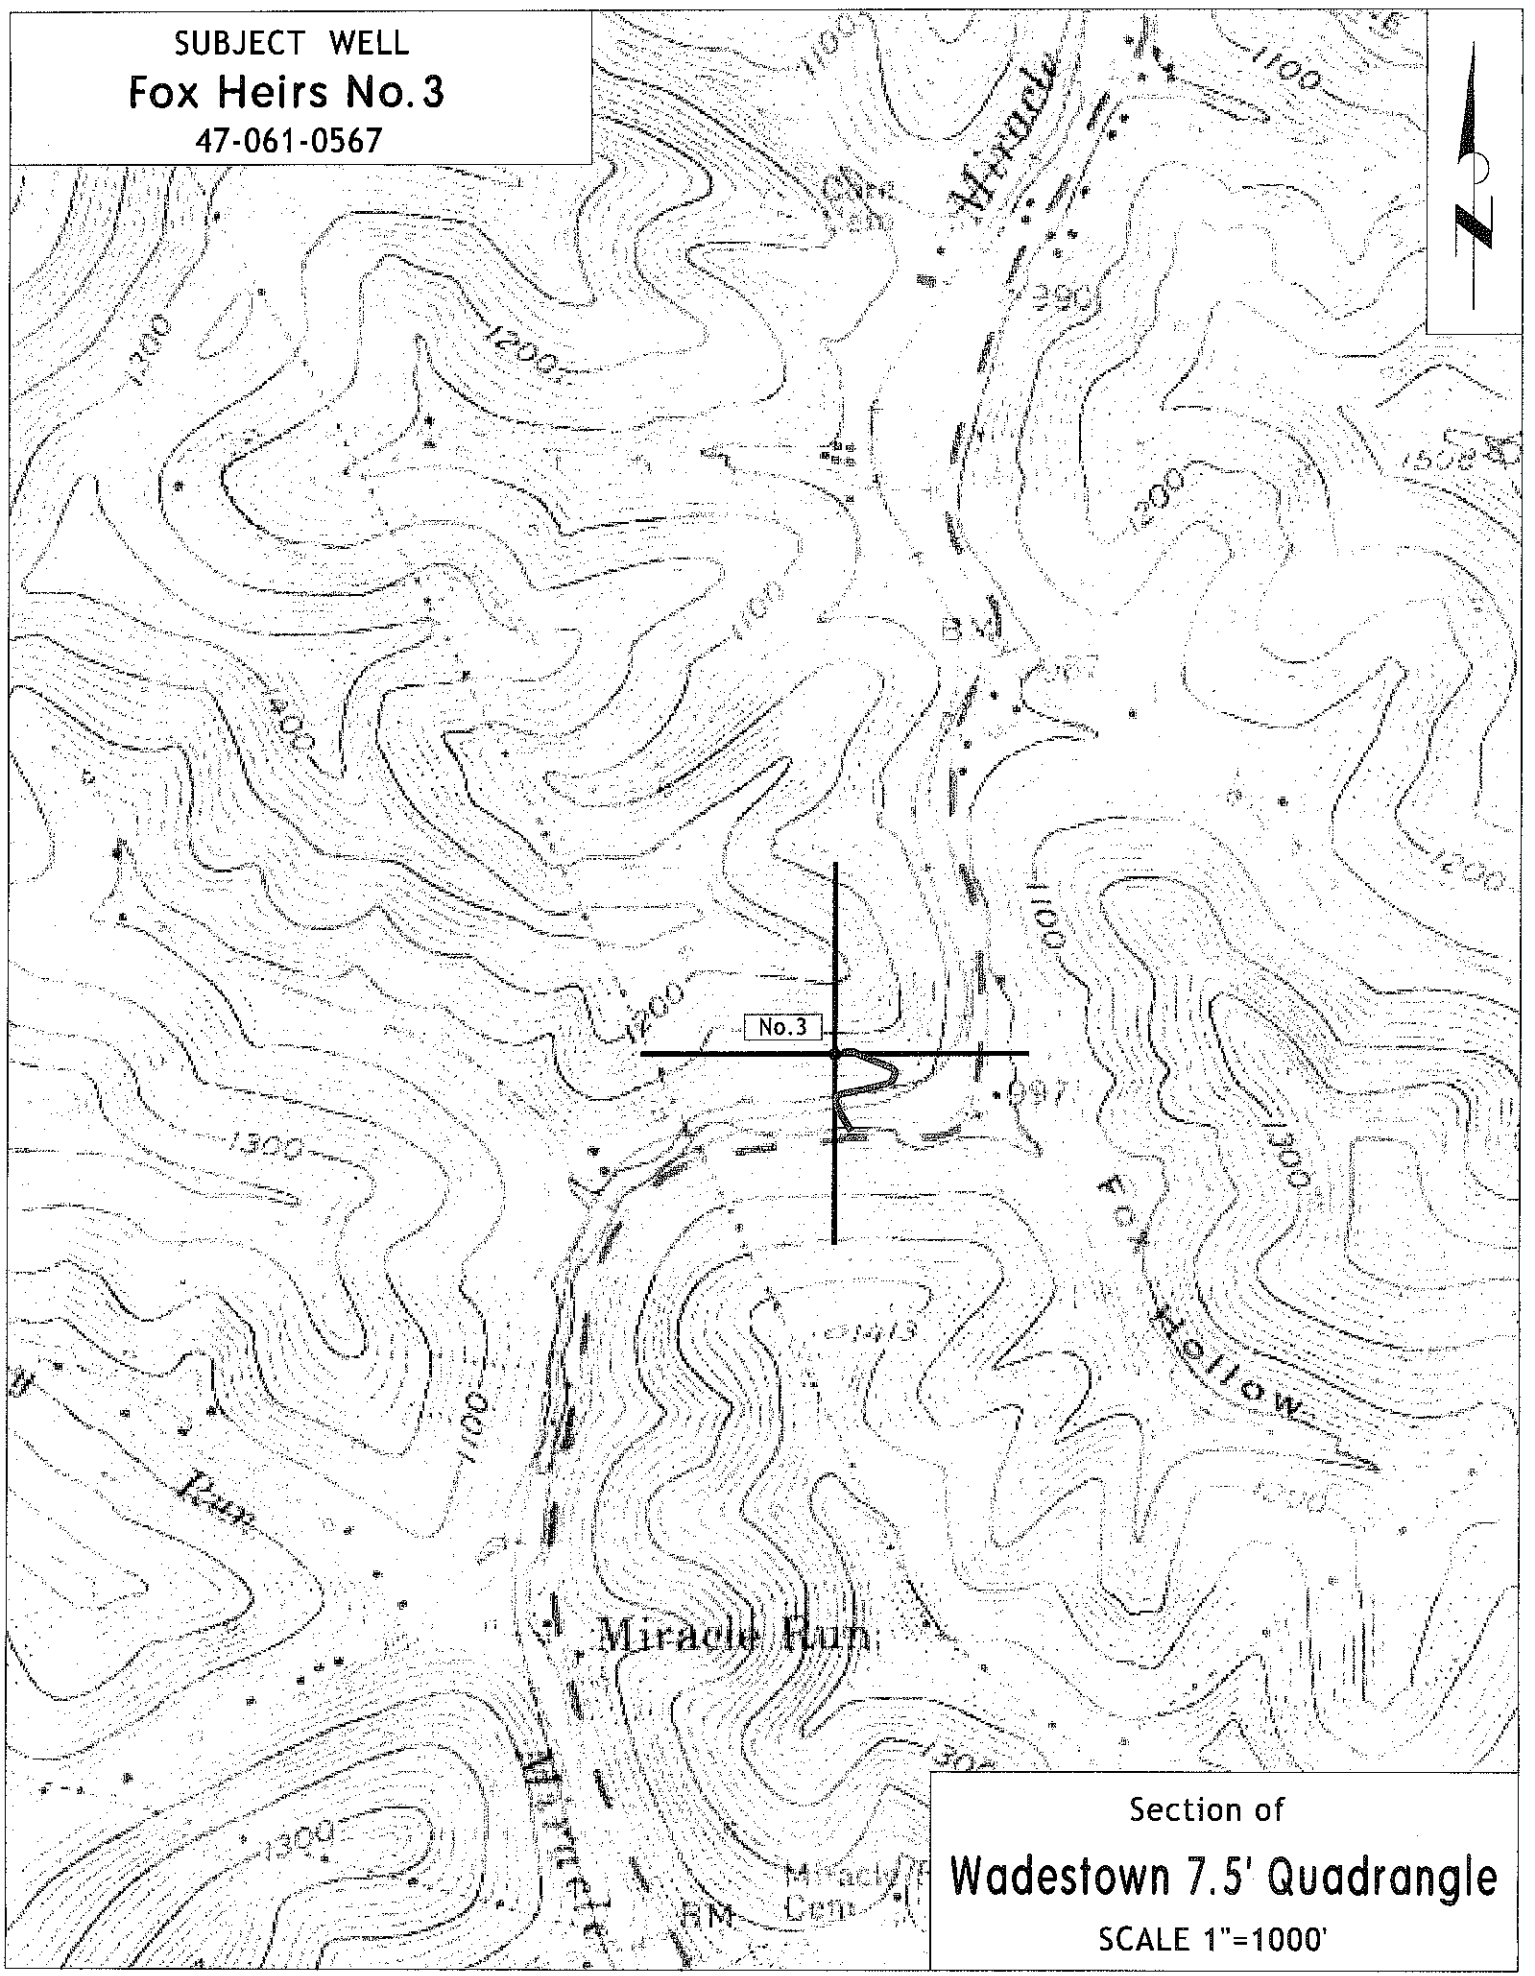

Section of  
Wadestown 7.5' Quadrangle  
SCALE 1"=1000'