




(15') 39° 40' 11/1/79

LATITUDE 39° 37' 30"

4200'

80° 20' LONGITUDE

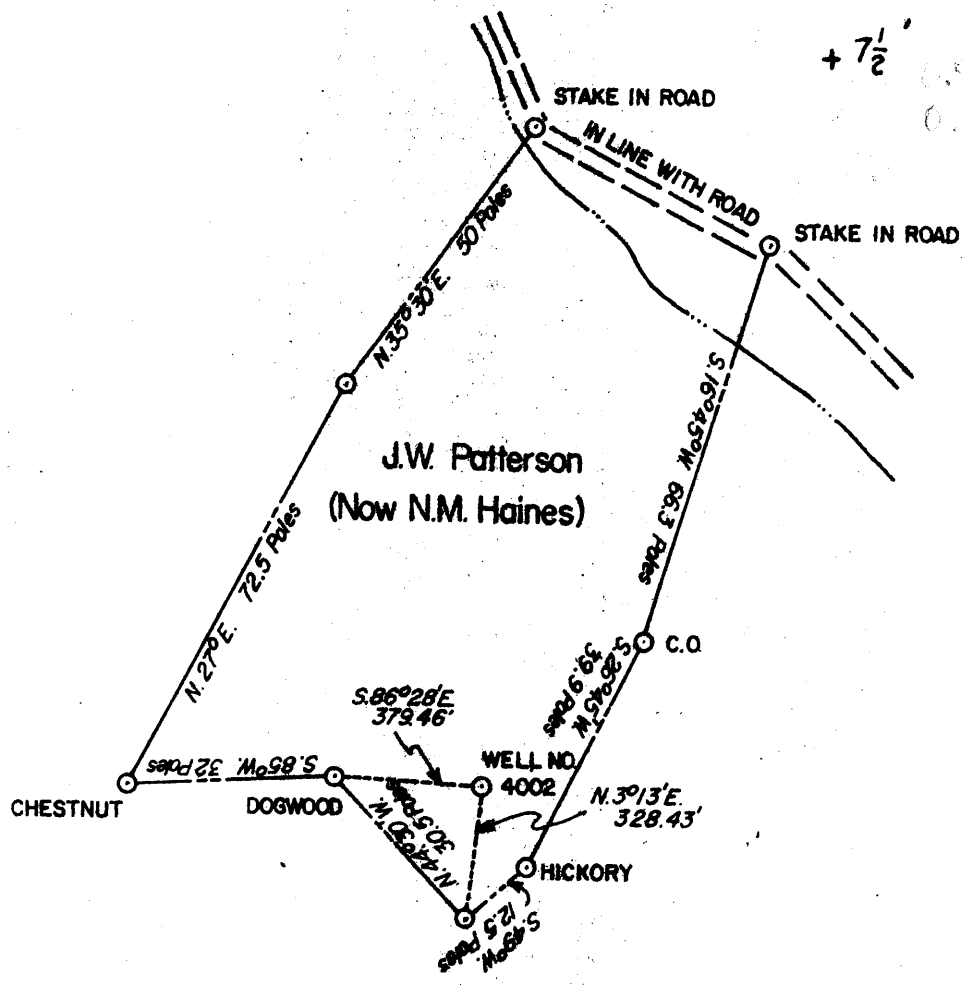

J.W. Patterson  
(Now N.M. Haines)

Calc 15 loc  
3.735  
0.78W

Minimum Error of Closure 1:200

Source of Elevation Company survey stations tied into U.S.G.S. network.

- Fracture
- New Location
- Drill Deeper
- Abandonment  11/1/79

I, the undersigned, hereby certify that this map is correct to the best of my knowledge and belief and shows all the information required by paragraph 6 of the rules and regulations of the oil and gas section of the mining laws of West Virginia

Signed: \_\_\_\_\_  
Squares: N S E W

Company CONSOLIDATION COAL COMPANY  
 Address PO. Box 1314, Morgantown, WV. 26505  
 Farm J.W. Patterson (now N.M. Haines)  
 Tract \_\_\_\_\_ Acres \_\_\_\_\_ Lease No. \_\_\_\_\_  
 Well (Farm) No. Consol 4002 Serial No. \_\_\_\_\_  
 Elevation (Spirit Level) 1497.14'  
 Quadrangle Mannington 7.5' Series, 15'  
 County Monongalia District Battelle  
 Engineer Donald W. Born  
 Engineer's Registration No. 2901  
 File No. \_\_\_\_\_ Drawing No. \_\_\_\_\_  
 Date 10-29-79 Scale 1" = 500'

STATE OF WEST VIRGINIA  
DEPARTMENT OF MINES  
OIL AND GAS DIVISION  
CHARLESTON

**WELL LOCATION MAP**

FILE NO. **47-061-0588-P**

† Denotes location of well on United States Topographic Maps, scale 1 to 24,000 latitude and longitude lines being represented by border lines as shown.

NOV 26 1979

— Denotes one inch spaces on border line of original tracing.

JAN 5 1980

**AFFIDAVIT OF PLUGGING AND FILLING WELL**

OIL & GAS DIVISION  
DEPARTMENT OF MINES

AFFIDAVIT SHOULD BE MADE IN TRIPPLICATE. ONE COPY MAILED TO THE DEPARTMENT, ONE COPY TO BE RETAINED BY THE WELL OPERATOR AND THE THIRD COPY (AND EXTRA COPIES IF REQUIRED) SHOULD BE MAILED TO EACH COAL OPERATOR AT THEIR RESPECTIVE ADDRESSES.

Consolidation Coal Company  
COAL OPERATOR OR OWNER  
P.O. Box 1314, Morgantown, WV 26505  
ADDRESS  
Same as above.  
COAL OPERATOR OR OWNER  
ADDRESS  
Noah Haines  
LEASE OR PROPERTY OWNER  
Wadestown, WV 26589  
ADDRESS

Consolidation Coal Company  
NAME OF WELL OPERATOR  
P.O. Box 1314, Morgantown, WV 26505  
COMPLETE ADDRESS  
January 5, 19 80  
WELL AND LOCATION  
Battelle District  
Monongalia County  
Well No. \*J.W. Patterson #1  
Noah H. Haines Farm

STATE INSPECTOR SUPERVISING PLUGGING

**AFFIDAVIT**

\* Consol Well No. 4002

STATE OF WEST VIRGINIA,  
County of Monongalia } ss:

Larry Yost and David Yost  
being first duly sworn according to law depose and say that they are experienced in the work of plugging and filling oil and gas wells and were employed by Consolidation Coal Company well operator, and participated in the work of plugging and filling the above well, that said work was commenced on the 1 day of November, 19 71, and that the well was plugged and filled in the following manner:

SAND OR ZONE RECORD FORMATION	FILLING MATERIAL	PLUGS USED SIZE & KIND	CAGING	
			CSG PULLED	CSG LEFT IN
Cleaned out well bore to cement plug at 2189'. Found 7" O.D. casing at 1064'. Pulled two joints			2" Pipe	810-1420'
7" casing from 1064' - 1100'. Both joints had cement around outside of casing. Could not pull anymore			4 1/2" csq.	1420-1390'
7" O.D. casing. Cut 7" casing at 1846' and 1506'. Run in hole with 390 feet of 2" pipe, 26 feet 4 1/2" casing, 4 1/2" x 7" tension packer, 6 feet 4 1/2" casing,			4 1/2" x 7" pkr.	1390
Howco latch down plug baffle and 1382' feet of 4 1/2" casing. Squeeze 90 sacks expanding cement below packer and pumped 716 sacks Pozzmix cement above packer. Bailed out 4 1/2" casing from 1382 to surface.			4 1/2" csq.	1390-1382
			Howco plug	1382
			4 1/2" csq.	1382=0
			7" csq.	100-2617'±
COAL SEALS				
(NAME) Pittsburgh	1292 - 1300			
(NAME)			DESCRIPTION OF MONUMENT	
(NAME)			6' of 4 1/2" casing sticking above surface. Plaque on top states:	
(NAME)			Consol Well No. 4002	
(NAME)			47-061-0588P	

and that the work of plugging and filling said well was completed on the 5 day of January, 19 80

And further deponents saith not.

Sworn to and subscribed before me this 30<sup>th</sup> day of January, 19 80

My commission expires:

Oct 17, 1984

*Larry Yost*  
*David Yost*  
*David F. [Signature]*

Notary Public

Permit No. 47-061-0588-P