


LATITUDE 39° 42' 30"

LONGITUDE 80° 22' 30"

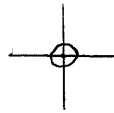

7'5 OGIS topo location

7.5' loc 2.81 s 15' loc \_\_\_\_\_  
                  1.23 w (calc.) \_\_\_\_\_

Company \_\_\_\_\_

Farm \_\_\_\_\_

Quad HUNDRED 7 1/2'

County MONONGALIA


District BATTELLE

Elev. 1390 ± (TOPS)

WELL LOCATION MAP

File No. 061 - 0608

061-608

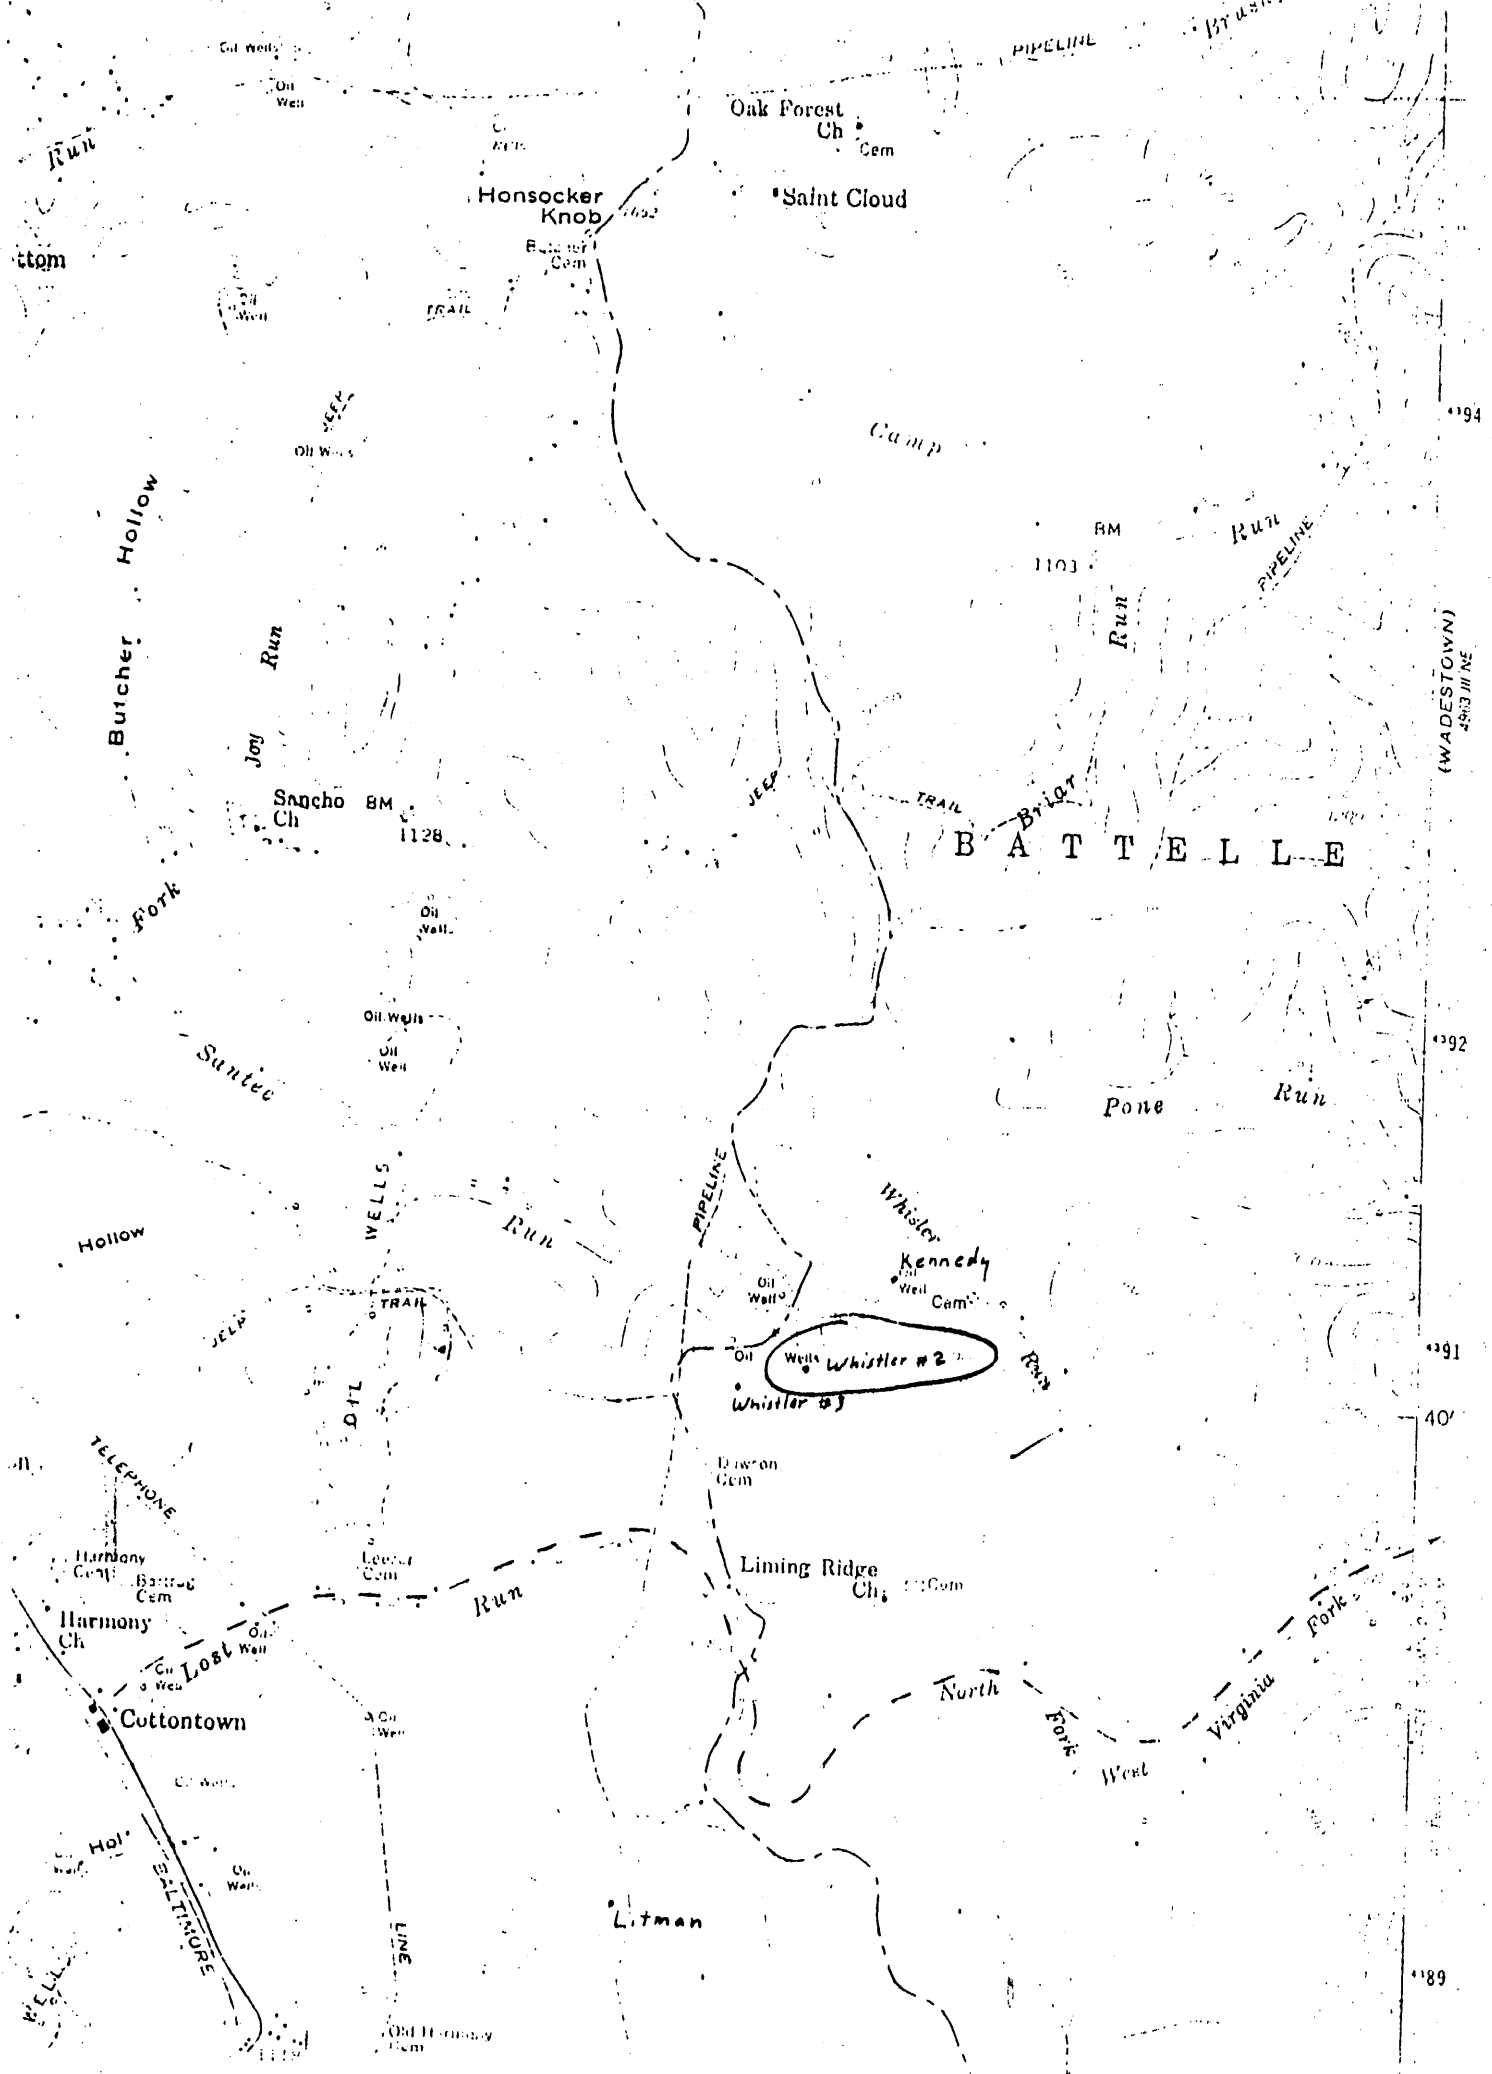

(WADESTOWN) 49°33' N

061-608

Pumped by Ken Grim  
Oil Well

POST OFFICE BOX 44  
ALEPPO, PENNSYLVANIA 15310  
PHONE 412/885-5100



061-608

WELL NO.	2 LESSOR A W WHISLER	LEASE NO.		ADDRESS ELEVATION	8 L DIV.	DIST.	
TWP OR DIST.	ARTELLE	FORMATIONS	TOP	BOTTOM	GAS AT	OK AT	WATER AT
COUNTY	MONTGOMERIA W. Va	WAYNESBURG COAL					
LOCATED		MAPLETON COAL					
W/O NO.	DATE	REDSTONE COAL					
CONTRACTOR		PITTSBURGH COAL	1215	1220			
COMMENCED	PER FT.	MURPHY SAND					
COMPLETED	8-20-26	AMES LIMESTONE					
PURCHASED FROM		BAKERSTOWN COAL					
DATE PURCHASED		L. DUNKARD SAND					
OUTSIDE SERIAL NO.		COAL					
SOLD TO		B. DUNKARD SAND					
DATE SOLD		UPPER FREEPORT COAL					
DATE ABANDONED		L. FREEPORT COAL					
DATE PLUGGED		U. KITTI. COAL					
ANNUAL ROYALTY \$	DUE	M. KITTI. COAL					
WORKMEN'S COMP. NOTICE POSTED		L. KITTI. COAL					
DRILLER'S LOG IN FILE		VAMPORT LIME					
		CLARION COAL					
		BROOKVILLE COAL					
OWNER		1st GAS SAND					
ADDRESS		MERCER COAL					
DATE NOTIFIED LOCATION		1st SALT SAND					
DATE APPROVED LOCATION		2nd SALT SAND					
		3rd SALT SAND					
		MAXTON SAND					
		LITTLE LIME					
		PENCIL CAVE					
		BIG LIME (KEENER)					
		BIG INJUN SAND					
		SOUAW SAND					
		2nd GAS SAND					
		MURRYSVILLE SAND (BEREA)					
ANNUAL ALLOWANCE	M.C.F.						
CONSUMER	(O.T.)						
ADDRESS		TOTAL DEPTH					
		TOTAL DEPTH	3284				

OPEN FLOW VOLUME & PRESSURE DATA

DATE	READING	LIQUID	SIZES					24 HR. 18 DAY R.P.	VOLUME	PRODUCING SAND	C/O NO.	DATE LAND	DATE RECT'D	SIZE	FEET LAND	FEET RECT'D	REMARKS
			1	2	3	4	5										
DATE TURNED IN LINE																	
DATE DISCONNECTED																	

REPAIR AND DRILLING DEEPER

W/O NO	DATE	REASON	COMMENCED	COMPLETED	OK'D	VOLUME		ROCK PRESS.		DATE	AMT.	DEPTH		VOLUME		PRESENT
						BEFORE	AFTER	BEFORE	AFTER			BEFORE	AFTER			
SHOOTING RECORD																

VOLUME FACTOR DATA

DATE DISCONNECTED