

LATITUDE 39° 42' 30"

LONGITUDE 80° 22' 30"



7'5 OGIS topo location

7.5' loc 2.86 S 15' loc _____
 1.37 W (calc.) _____

Company _____

Farm _____

Quad HUNDRED 7 1/2'


County MONONGALIA

District BATTELLE

(Clev 1340 ± (TOPO))

WELL LOCATION MAP

File No. 061-0609

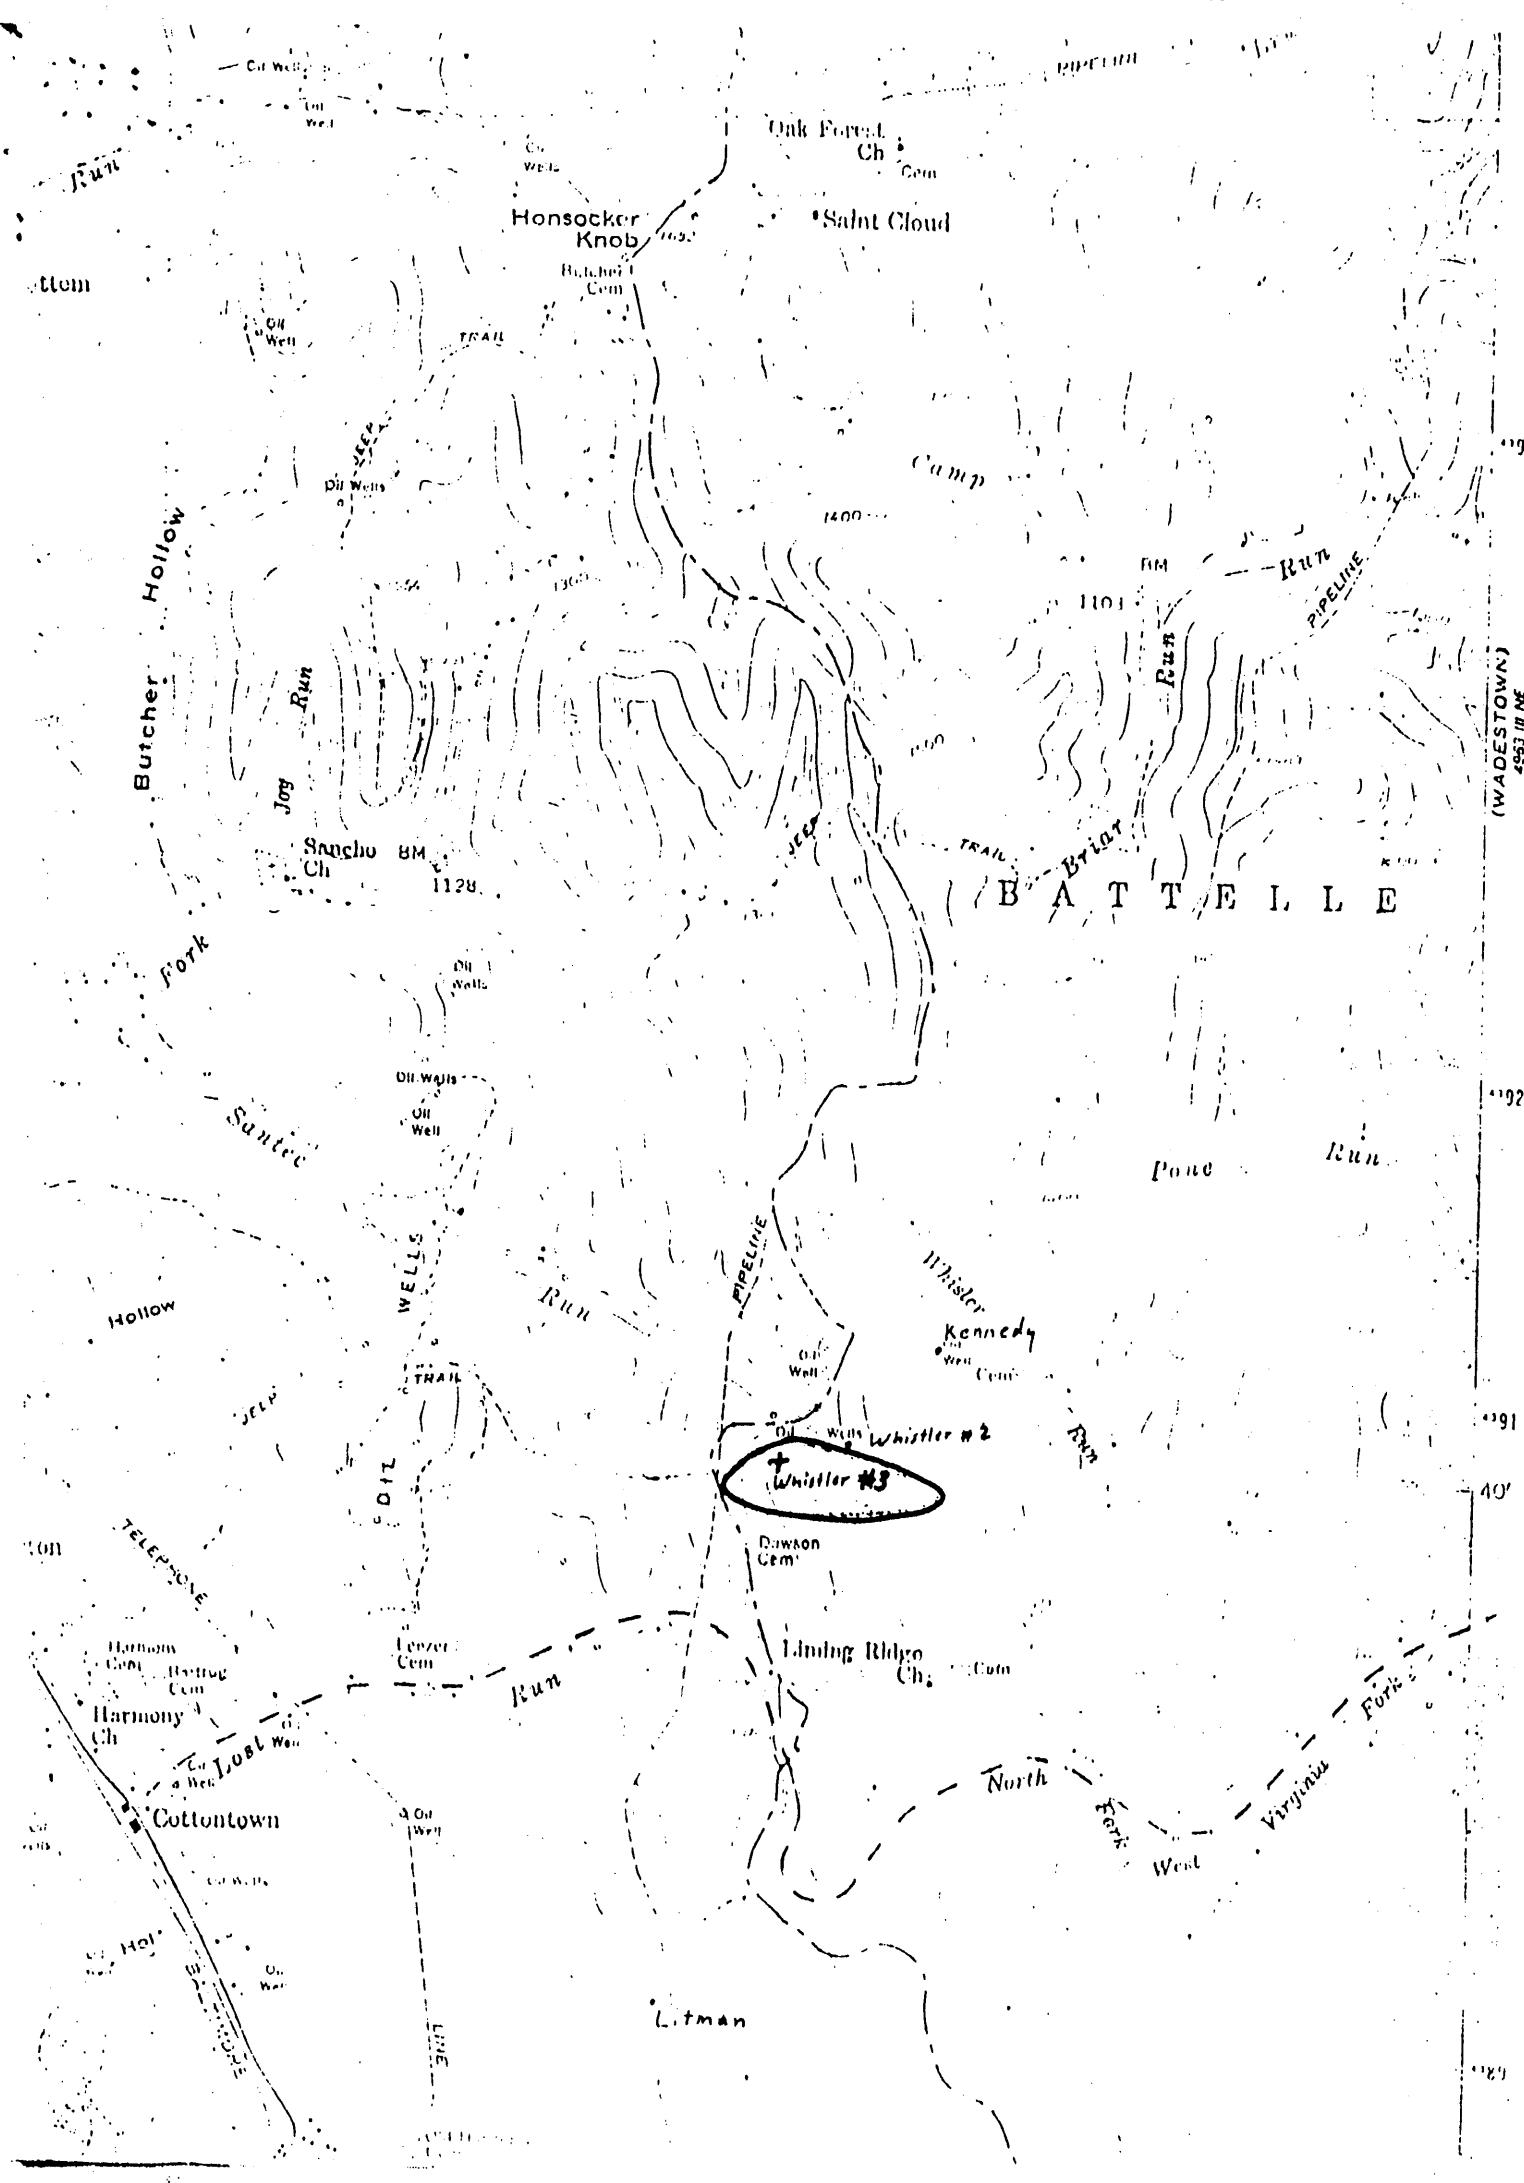

061-609

