

RECEIVED
Office of Oil and GasWW-7
8-30-06

MAY 20 2016

WV Department of
Environmental ProtectionWest Virginia Department of Environmental Protection
Office of Oil and Gas

WELL LOCATION FORM: GPS

API: 47-061-00778 WELL NO.: 1

FARM NAME: Asa Tennant

RESPONSIBLE PARTY NAME: Noumenon Corporation

COUNTY: Monongalia DISTRICT: Clay

QUADRANGLE: Blacksville, WV

SURFACE OWNER: Church of Christ-Mooresville

ROYALTY OWNER: Not Producing

UTM GPS NORTHING: 432006.412 = 4393050.391

UTM GPS EASTING: 1783680.199 = 572313.403 GPS ELEVATION: 1006.32

The Responsible Party named above has chosen to submit GPS coordinates in lieu of preparing a new well location plat for a plugging permit or assigned API number on the above well. The Office of Oil and Gas will not accept GPS coordinates that do not meet the following requirements:


1. Datum: NAD 1983, Zone: 17 North, Coordinate Units: meters, Altitude: height above mean sea level (MSL) – meters.
2. Accuracy to Datum – 3.05 meters
3. Data Collection Method:
Survey grade GPS : Post Processed Differential

Real-Time Differential Mapping Grade GPS : Post Processed Differential Real-Time Differential

4. Letter size copy of the topography map showing the well location.

I the undersigned, hereby certify this data is correct to the best of my knowledge and belief and shows all the information required by law and the regulations issued and prescribed by the Office of Oil and Gas.

 President 5/20/2016
Signature Title Date

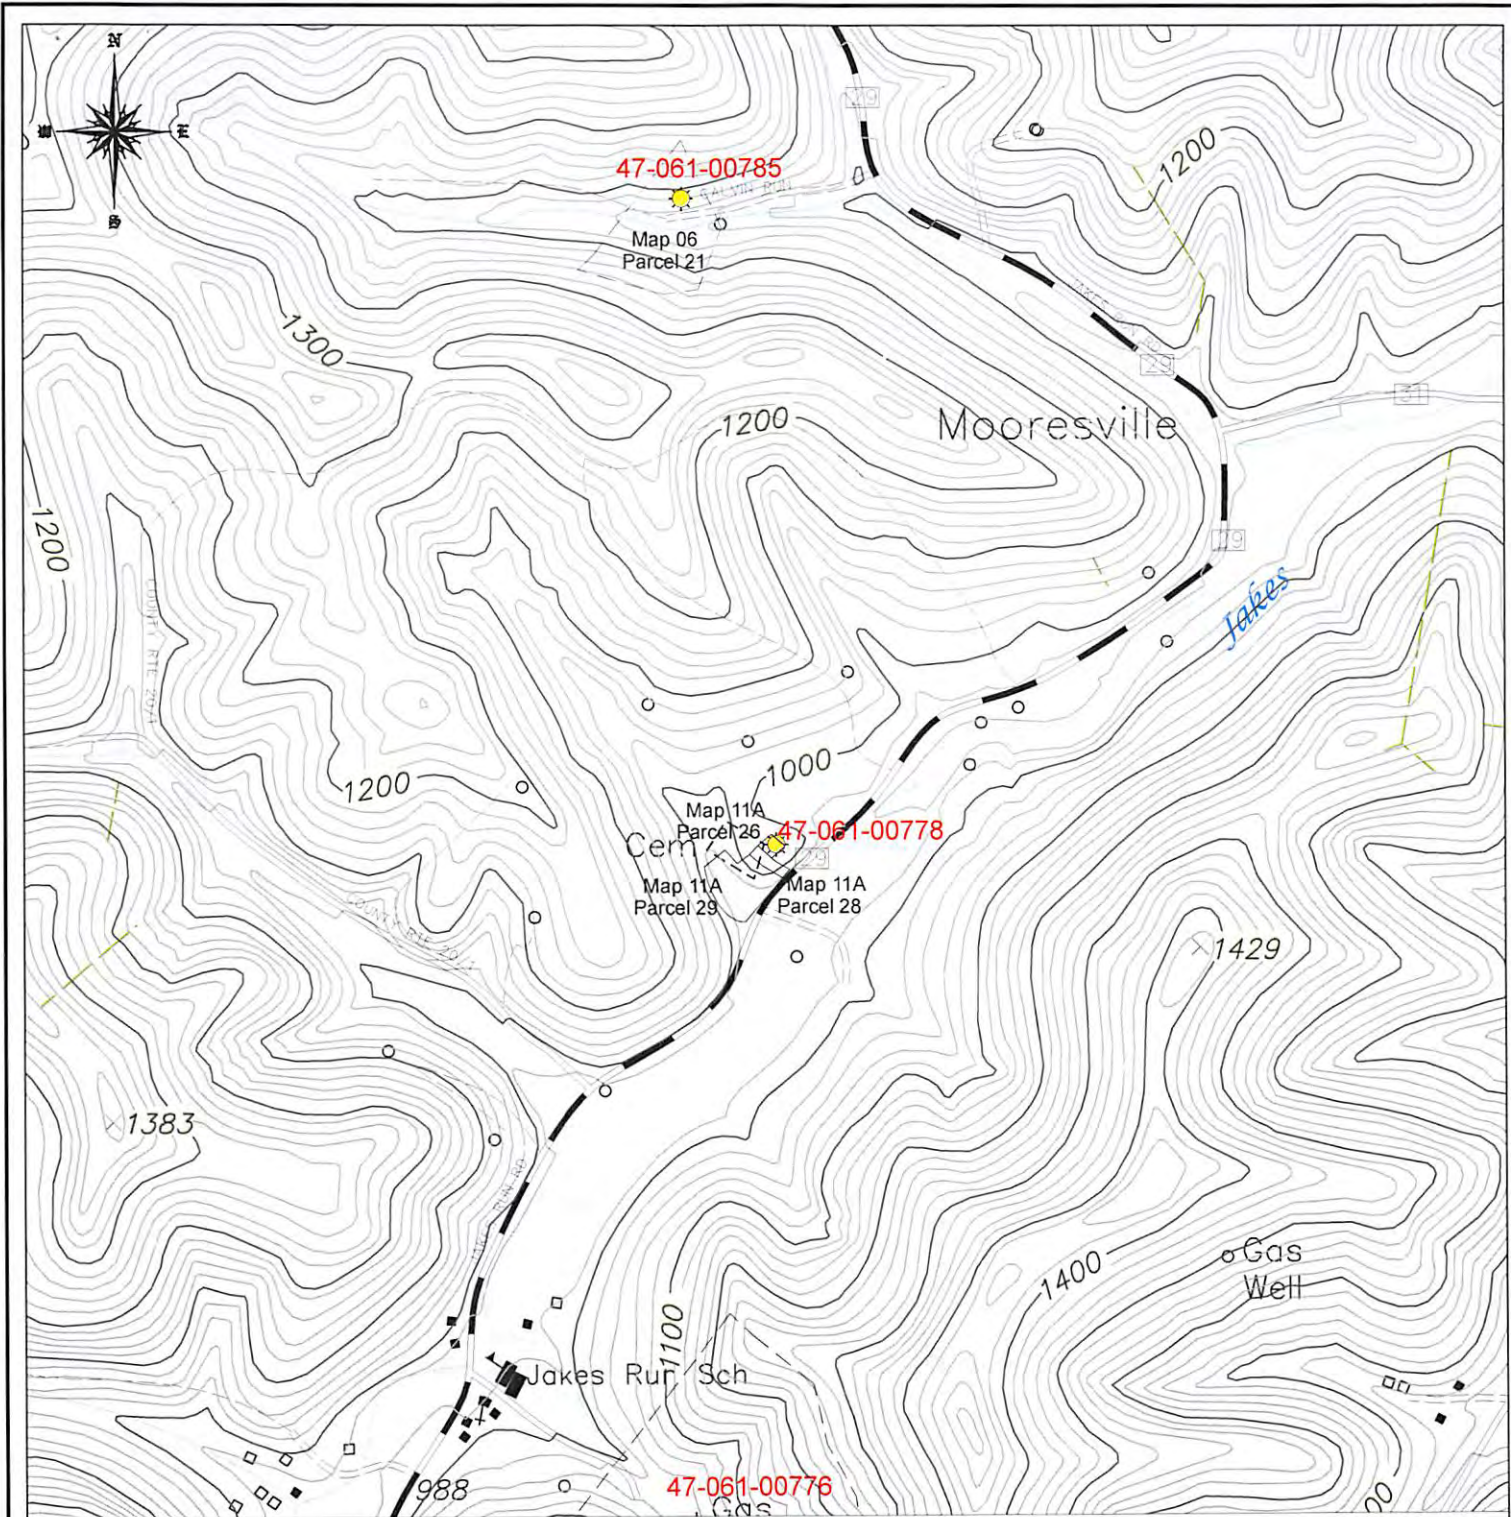

LEGEND

GAS WELL
LATITUDE: 39 41 03.2
LONGITUDE: 80 09 24.3
ELEVATION: 1008'

HAND HELD GPS SURVEYED WELL LOCATION 

PROPERTY LINE - - - - -

0FT 1000FT 2000FT



LOCATION MAP

NOUMENON CORPORATION
2461 MASON DIXON HIGHWAY, CORE, WV 26541

API WELL NO. - **47-061-00778**
OPERATOR'S WELL NO. - **1 ASA TENNANT**

CLAY DISTRICT - MONONGALIA COUNTY, WV
7.5 MINUTE SERIES - 20' CONTOUR INTERVAL
BLACKSVILLE, WV TOPO QUAD

WV Department of
Environmental Protection
06/17/2016