

WW-7
8-30-06

RECEIVED
Office of Oil and Gas

MAY 20 2016



WV Department of
Environmental Protection

West Virginia Department of Environmental Protection
Office of Oil and Gas
WELL LOCATION FORM: GPS

API: 47-061-00780 WELL NO.: 1
 FARM NAME: Eliza Tennant
 RESPONSIBLE PARTY NAME: Noumenon Corporation
 COUNTY: Monongalia DISTRICT: Clay
 QUADRANGLE: Blacksville, WV
 SURFACE OWNER: Todd J. and Carlene S. Moore
 ROYALTY OWNER: Not Producing
 UTM GPS NORTHING: 424849.620 = 4390844.970 N
 UTM GPS EASTING: 17787781.580 = 570857.356 E GPS ELEVATION: 983.86

The Responsible Party named above has chosen to submit GPS coordinates in lieu of preparing a new well location plat for a plugging permit or assigned API number on the above well. The Office of Oil and Gas will not accept GPS coordinates that do not meet the following requirements:

1. Datum: NAD 1983, Zone: 17 North, Coordinate Units: meters, Altitude: height above mean sea level (MSL) – meters.
2. Accuracy to Datum – 3.05 meters
3. Data Collection Method:

Survey grade GPS : Post Processed Differential

Real-Time Differential


Mapping Grade GPS : Post Processed Differential

Real-Time Differential

4. **Letter size copy of the topography map showing the well location.**


I the undersigned, hereby certify this data is correct to the best of my knowledge and belief and shows all the information required by law and the regulations issued and prescribed by the Office of Oil and Gas.

 President 5/20/2016
 Signature Title Date

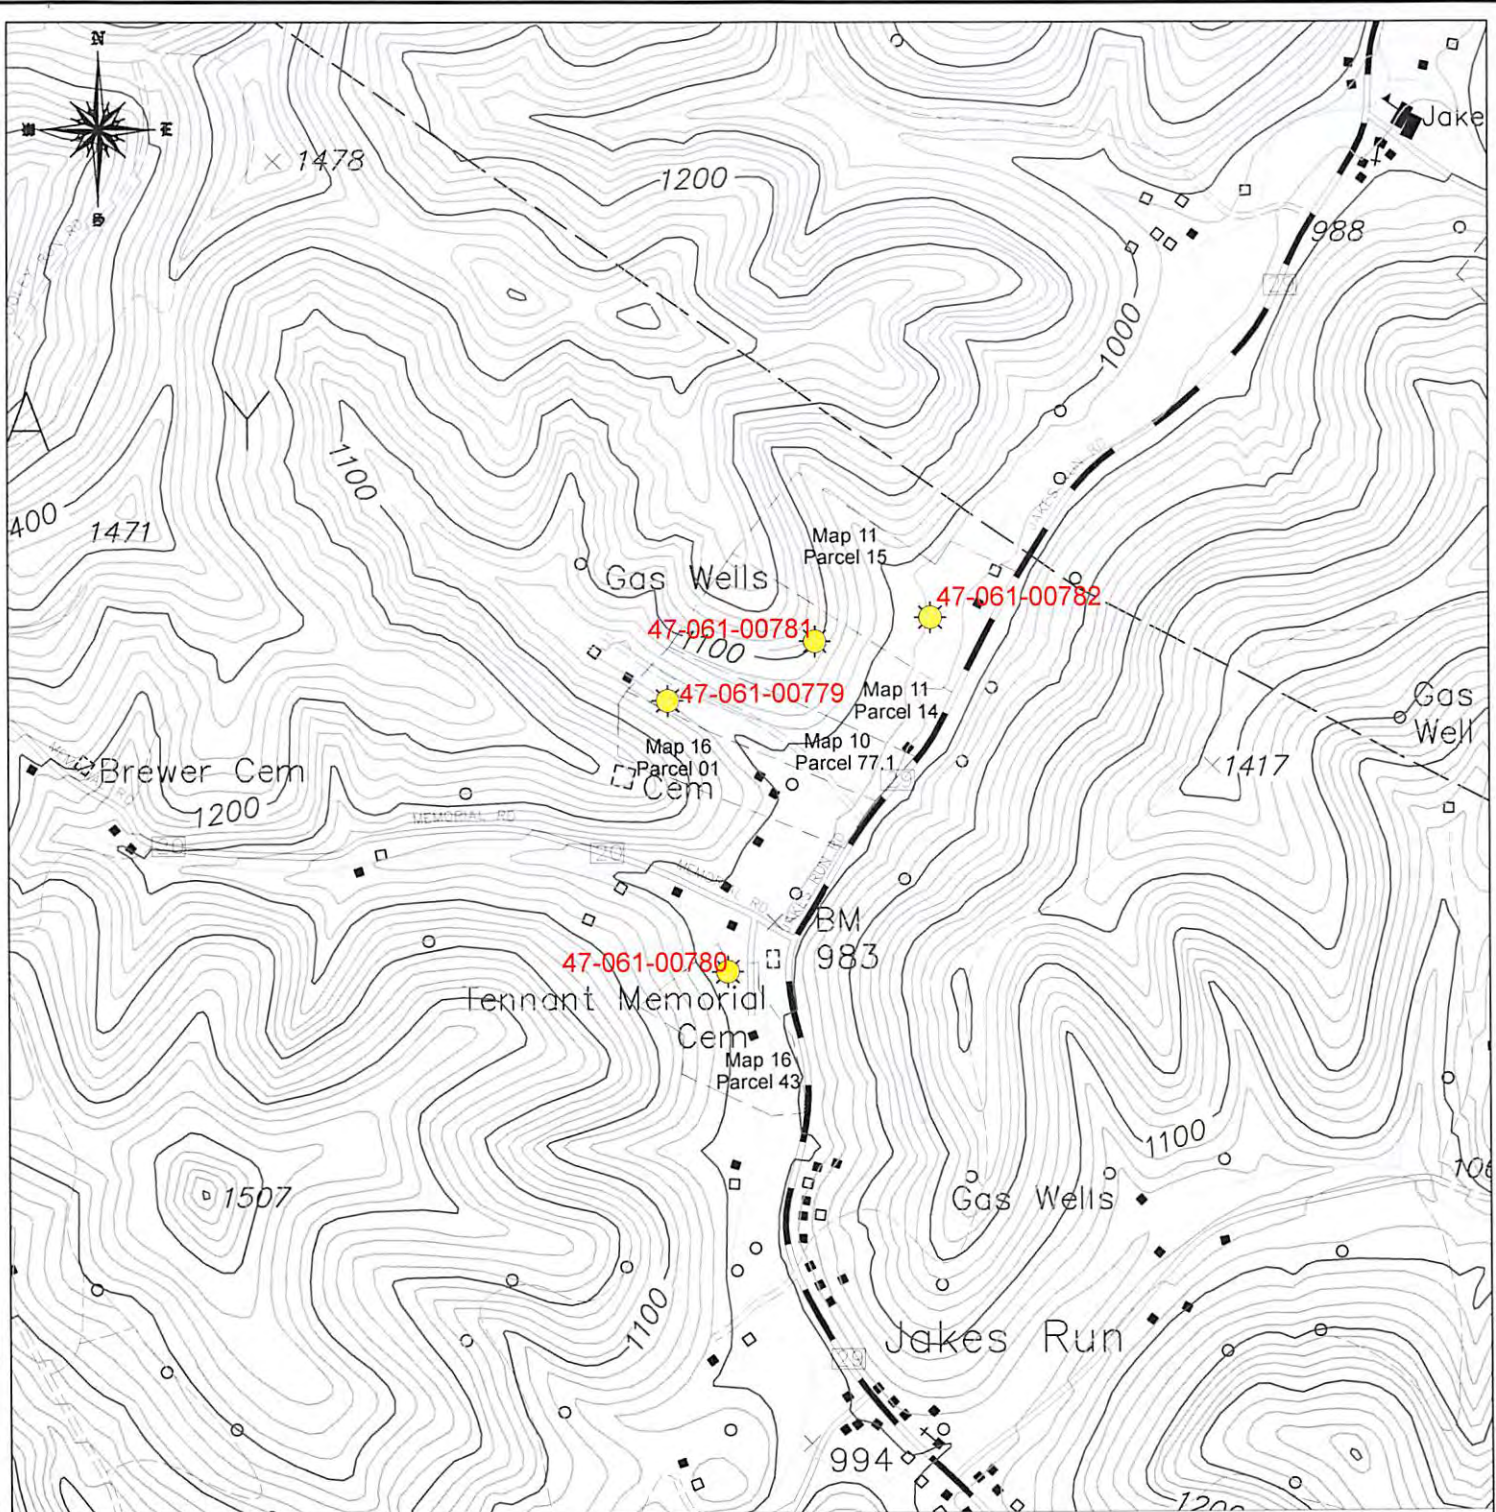

LEGEND

GAS WELL
 LATITUDE: 39 40 52.2
 LONGITUDE: 80 10 26.2
 ELEVATION: 988'

HAND HELD GPS SURVEYED WELL LOCATION 

PROPERTY LINE - - - - -

0FT 1000FT 2000FT



LOCATION MAP

NOUMENON CORPORATION
 2461 MASON DIXON HIGHWAY, CORE, WV 26541

RECEIVED
 Office of Oil and Gas
API WELL NO. - 47-061-00780
OPERATOR'S WELL NO. - 1 - ELIZA TENNANT

MAY 16 2016
 CLAY DISTRICT - MONONGALIA COUNTY, WV
 7.5 MINUTE SERIES- 20' CONTOUR INTERVAL
 BLACKSVILLE, WV TWP 02 04 N
 WV Department of
 Environmental Protection

06/17/2016