


LATITUDE 39° 40' 00"
4,950

LONGITUDE 80° 01' 00"

2,400

0.455
694W

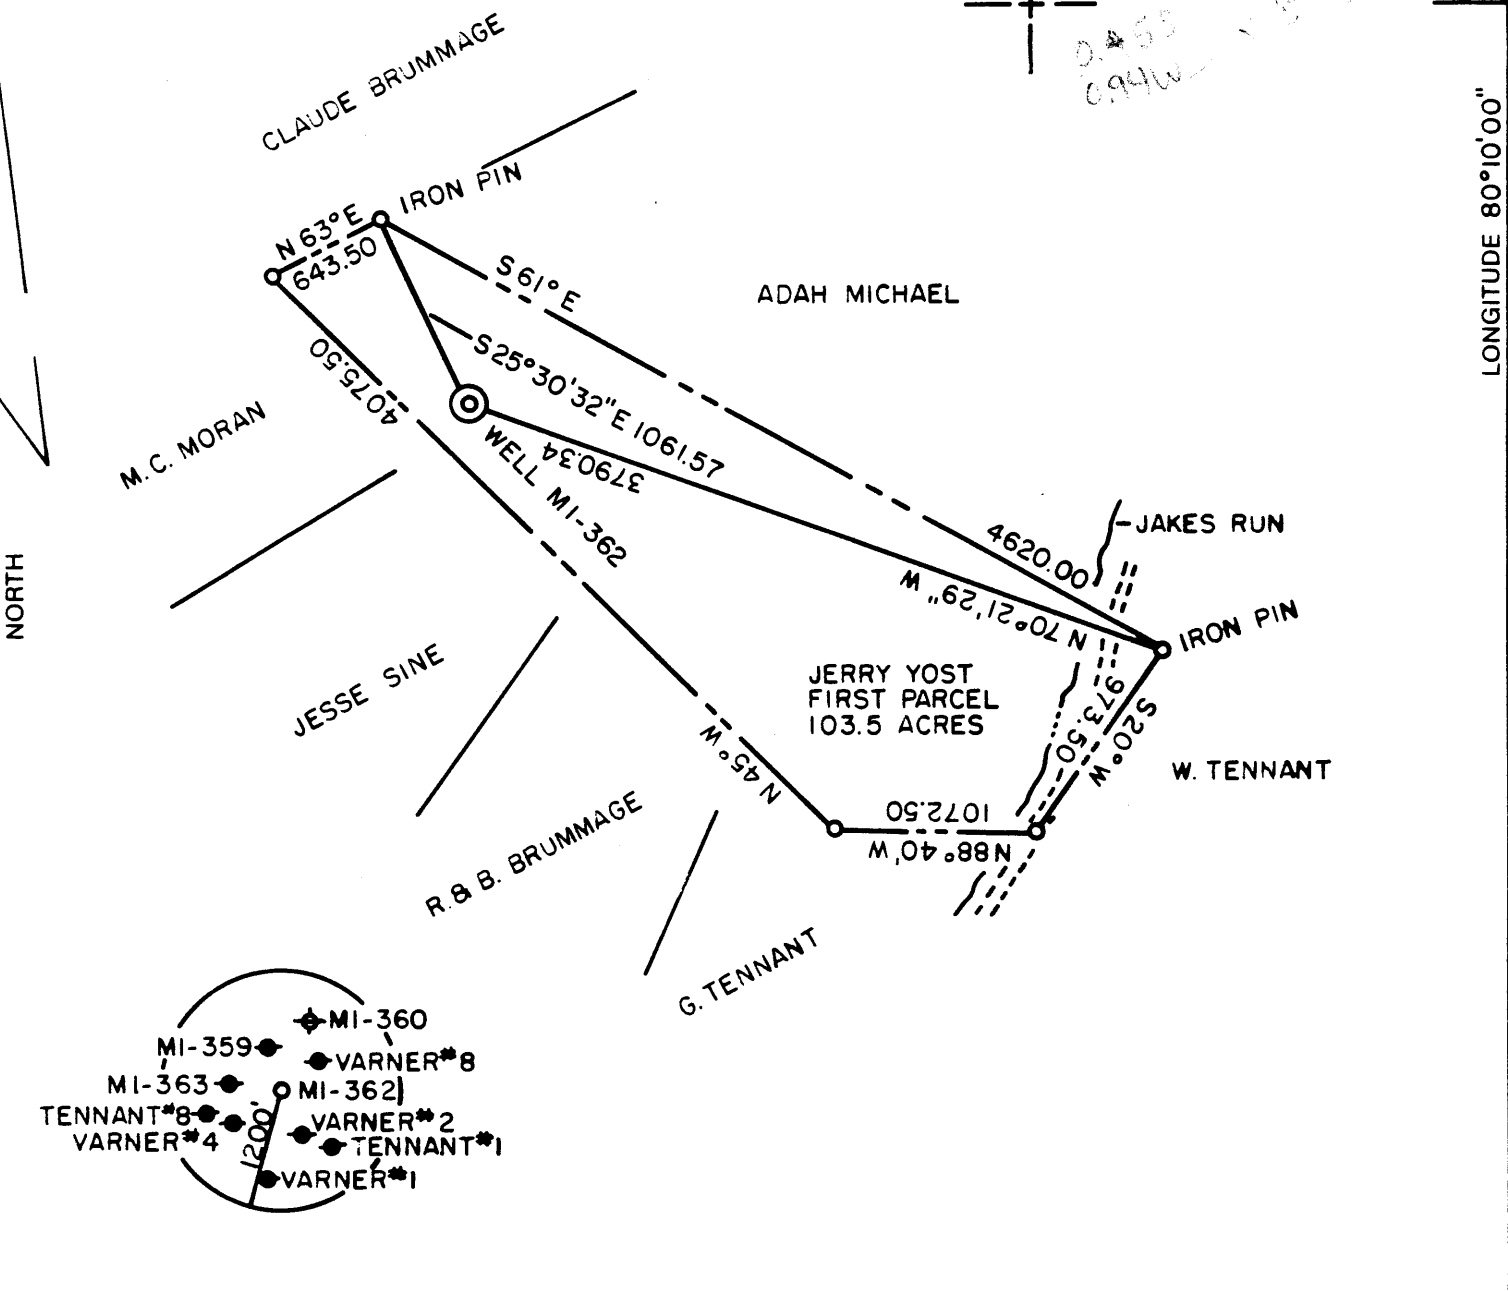

(+) DENOTES LOCATION OF WELL ON UNITED STATES TOPOGRAPHIC MAPS

FILE NO. _____
 DRAWING NO. _____
 SCALE 1" = 1000'
 MINIMUM DEGREE OF ACCURACY 1 IN 5000
 PROVEN SOURCE OF ELEVATION COMPANY SURVEY TIED INTO THE U.S.G.S. NETWORK

I THE UNDERSIGNED, HEREBY CERTIFY THAT THIS PLAT IS CORRECT TO THE BEST OF MY KNOWLEDGE AND BELIEF AND SHOWS ALL THE INFORMATION REQUIRED BY LAW AND THE REGULATIONS ISSUED AND PRESCRIBED BY THE DEPARTMENT OF MINES.
 (SIGNED) Robert Nelson McCoy
 R.P.E. _____ L.L.S. 110



STATE OF WEST VIRGINIA
 DEPARTMENT OF MINES
 OIL AND GAS DIVISION



DATE SEPTEMBER 7, 1984
 OPERATOR'S WELL NO. MI-362
 API WELL NO. _____

WELL TYPE: OIL ___ GAS ___ LIQUID INJECTION ___ WASTE DISPOSAL ___ STATE COUNTY PERMIT
 (IF "GAS,") PRODUCTION ___ STORAGE ___ DEEP ___ SHALLOW X ABANDONED X

LOCATION: ELEVATION 1388.76 WATERSHED JAKES RUN
 DISTRICT CLAY COUNTY MONONGALIA
 QUADRANGLE BLACKSVILLE W.V. PA. 7.5 15WC

SURFACE OWNER JERRY L. & AUDRA E. YOST ACREAGE 103.5

OIL & GAS ROYALTY OWNER _____ LEASE ACREAGE _____

PROPOSED WORK: DRILL ___ CONVERT ___ DRILL DEEPER ___ REDRILL X FRACTURE OR
 STIMULATE ___ PLUG OFF OLD FORMATION ___ PERFORATE NEW
 FORMATION ___ OTHER PHYSICAL CHANGE IN WELL (SPECIFY) _____

PLUG AND ABANDON ___ CLEAN OUT AND REPLUG X
 TARGET FORMATION NONE ESTIMATED DEPTH _____

WELL OPERATOR CONSOLIDATION COAL COMPANY DESIGNATED AGENT ROGER E. DUCKWORTH
 ADDRESS P.O. BOX 1314 MORGANTOWN W.V. 26505 ADDRESS P.O. BOX 1314 MORGANTOWN W.V. 26505

JUL 29 1985

FORM IV-6 (8-78)
H.T. HALL

COUNTY NAME PERMIT

STATE OF WEST VIRGINIA
DEPARTMENT OF MINES
OIL AND GAS WELLS DIVISION

RECEIVED
AUG 05 1985

AFFIDAVIT OF PLUGGING AND FILLING WELL
DIVISION OF OIL & GAS
DEPARTMENT OF ENERGY

AFFIDAVIT SHOULD BE MADE IN TRIPLICATE. ONE COPY MAILED TO THE DEPARTMENT, ONE COPY TO BE RETAINED BY THE WELL OPERATOR AND THE THIRD COPY (AND EXTRA COPIES IF REQUIRED) SHOULD BE MAILED TO EACH COAL OPERATOR AT THEIR RESPECTIVE ADDRESSES.

<u>Consolidation Coal Company</u> COAL OPERATOR OR OWNER P. O. Box 1314, Morgantown, WV 26507-1314 ADDRESS <u>Consolidation Coal Company</u> COAL OPERATOR OR OWNER P.O. Box 1314 Morgantown, W.Va. ADDRESS <u>Jerry L. Yost & Audra E. Yost</u> LEASE OR PROPERTY OWNER ADDRESS	<u>Consolidation Coal Company</u> NAME OF WELL OPERATOR P. O. Box 1314, Morgantown, WV 26507-1314 COMPLETE ADDRESS <u>August 21</u> 19 <u>85</u> WELL AND LOCATION <u>Clay</u> District <u>Monongalia</u> County Well No. <u>M1-362</u> Farm
--	---

STATE INSPECTOR SUPERVISING PLUGGING Don Ellis

AFFIDAVIT

STATE OF WEST VIRGINIA, }
County of Monongalia } SS:
Larry L. Yost and David D. Yost
being first duly sworn according to law depose and say that they are experienced in the work of plugging and filling oil and gas wells and were employed by Consolidation Coal Co., well operator, and participated in the work of plugging and filling the above well, that said work was commenced on the 25th day of July, 19 85, and that the well was plugged and filled in the following manner:

BAND OR ZONE RECORD	FILLING MATERIAL	PLUGS USED		CASING	
		SIZE & KIND	CBS PULLED	CBS LEFT IN	
FORMATION	Cleaned wellbore to 1820'. Pulled 315' of 7" and 200' of 8". Ran coal protection string as follows: 1047' of 4 1/2" casing; 746' of 2 3/8" tubing; Latchdown at 1024'; Float Valve at 1047'; Swedge at 1047'. Circulated cement to surface as follow; 935 sks. of Poz Mix; 260 sks. of Thixotropic; 1,000 gal. of mud flush.	7 in.	315'		
	Let sett, bailed dry, set monument.	8 in.	200'		
COAL BEAMS					
(NAME) Pittsburgh -	900 ft.				
(NAME)					
(NAME)					
(NAME)					
					DESCRIPTION OF MONUMENT
					75 ft. of 4 1/2" casing with plaque stating Consol M1-362
					47-061-0795-P

RECEIVED
AUG 29 1985
REGIONAL ENGINEERING

M.Y. 9/9/85

and that the work of plugging and filling said well was completed on the 6th day of August, 1985

And further deponents saith not.

Sworn to and subscribed before me this 27th day of August, 1985

Larry L. Yost
David D. Yost
Jarvis L. Helver

My commission expires: March 11, 1989

Notary Public.
Permit No. 061-0795-Y