


CODE _____ CARD _____ PLOT _____

10/1/85

LATITUDE 39° 37' 30" 5,110


LONGITUDE 80° 20' 00" 2,840

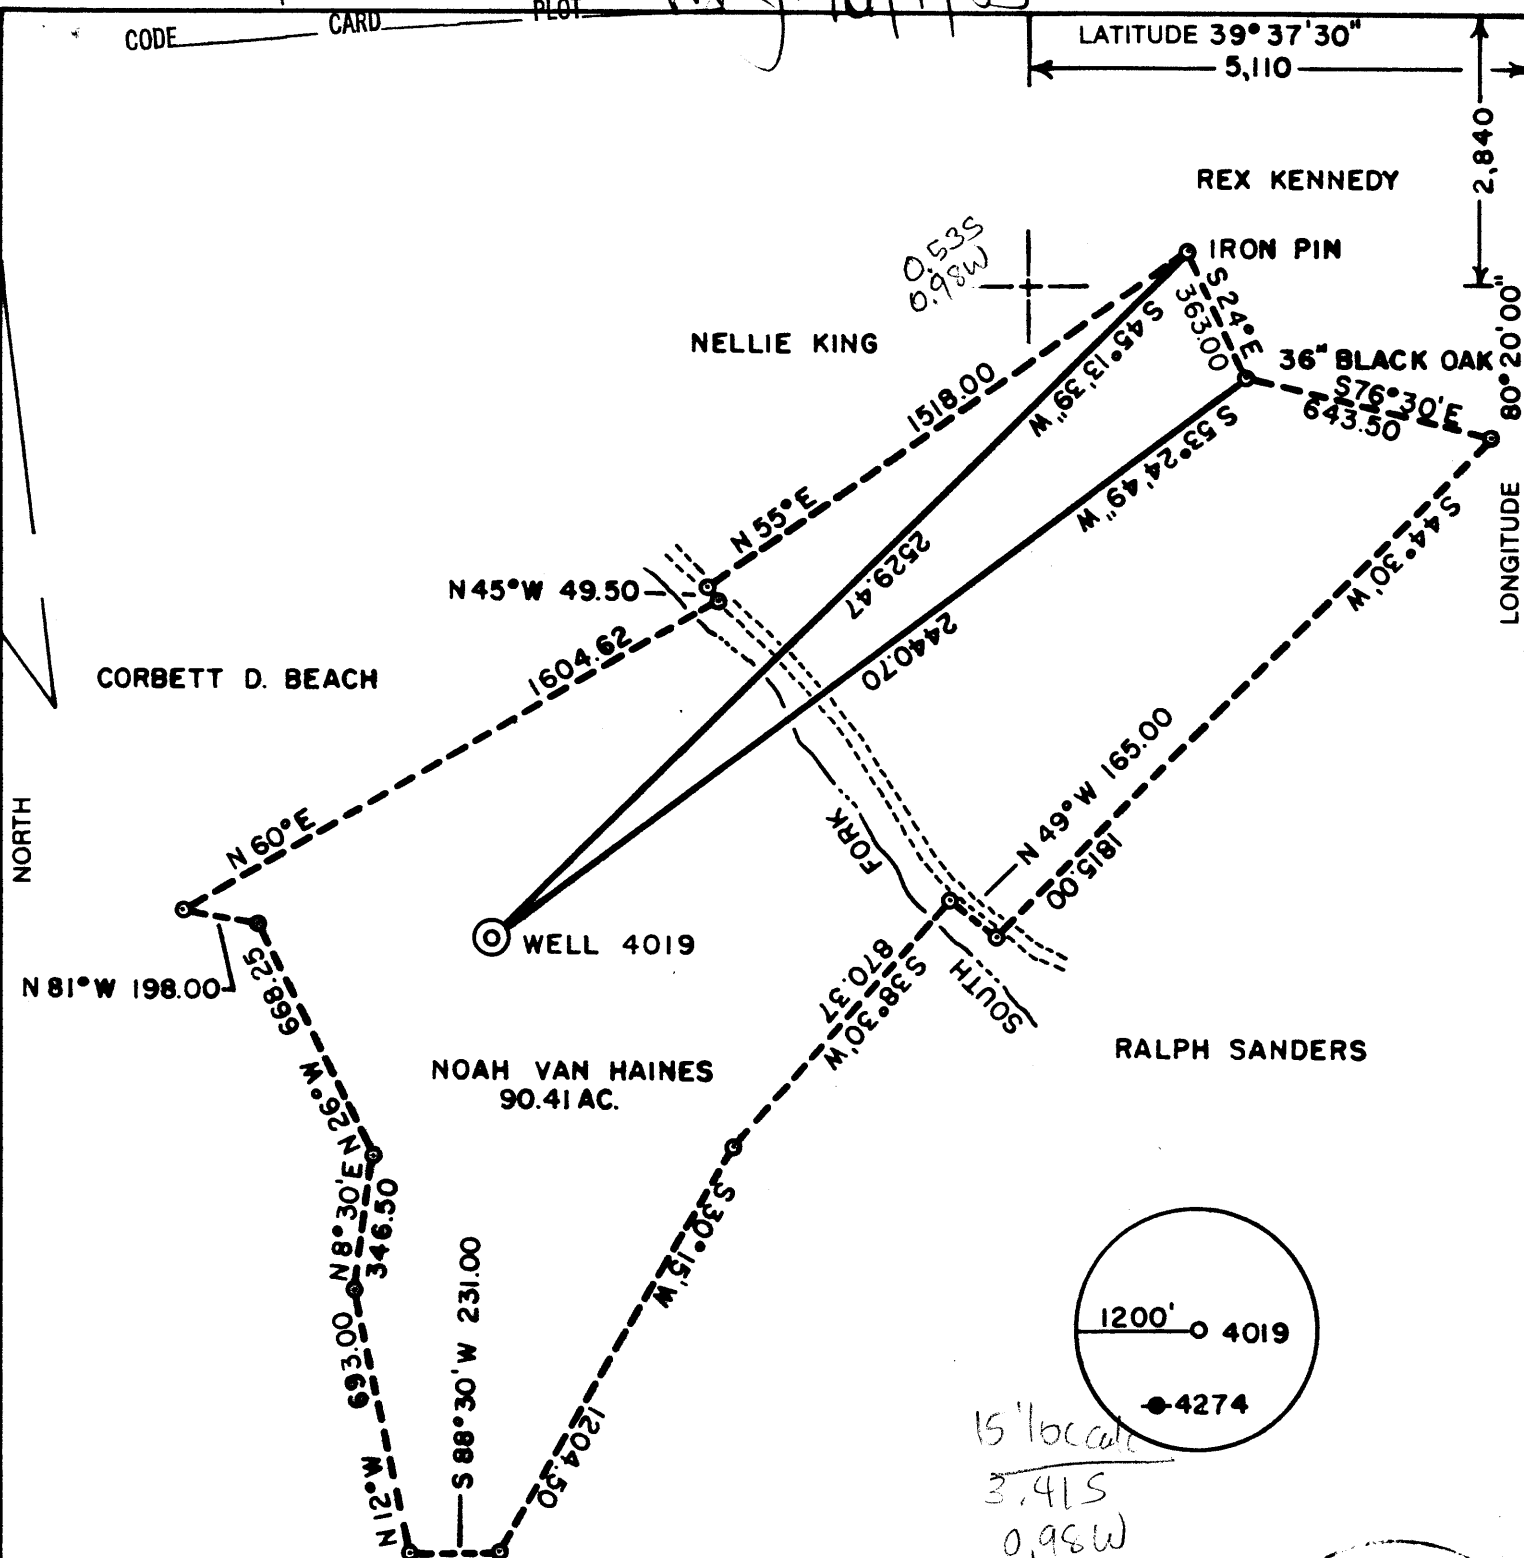

(+) DENOTES LOCATION OF WELL ON UNITED STATES TOPOGRAPHIC MAPS

FILE NO. _____
 DRAWING NO. _____
 SCALE 1" = 500'
 MINIMUM DEGREE OF ACCURACY 1 IN 5000
 PROVEN SOURCE OF ELEVATION COMPANY SURVEY TIED INTO U.S.G.S. NETWORK

I THE UNDERSIGNED, HEREBY CERTIFY THAT THIS PLAT IS CORRECT TO THE BEST OF MY KNOWLEDGE AND BELIEF AND SHOWS ALL THE INFORMATION REQUIRED BY LAW AND THE REGULATIONS ISSUED AND PRESCRIBED BY THE DEPARTMENT OF MINES.
 (SIGNED) R. Nelson McCoy
 R.P.E. _____ L.L.S. 110

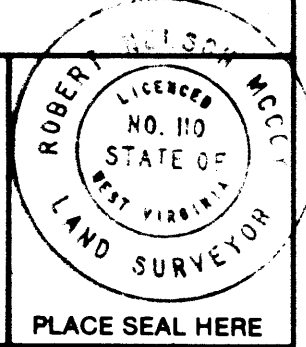

STATE OF WEST VIRGINIA
 DEPARTMENT OF MINES
OIL AND GAS DIVISION



DATE DECEMBER 29, 19 83
 OPERATOR'S WELL NO. 4019
 API WELL NO. _____

WELL TYPE: OIL GAS LIQUID INJECTION WASTE DISPOSAL
 (IF "GAS,") PRODUCTION STORAGE DEEP SHALLOW ABANDONED
 LOCATION: ELEVATION 1520.30 WATER SHED SOUTH FORK OF DUNKARD CREEK

DISTRICT BATTELLE COUNTY MONONGALIA
 QUADRANGLE MANNINGTON W.V. 7.5 + 15' 0

SURFACE OWNER NOAH VAN HAINES ACREAGE 90.41
 OIL & GAS ROYALTY OWNER UNKNOWN LEASE ACREAGE _____

LEASE NO. _____
 PROPOSED WORK: DRILL CONVERT DRILL DEEPER REDRILL FRACTURE OR STIMULATE PLUG OFF OLD FORMATION PERFORATE NEW FORMATION OTHER PHYSICAL CHANGE IN WELL (SPECIFY) _____

PLUG AND ABANDON CLEAN OUT AND REPLUG
 TARGET FORMATION NONE ESTIMATED DEPTH _____
 WELL OPERATOR CONSOLIDATION COAL COMPANY DESIGNATED AGENT ROGER E. DUCKWORTH
 ADDRESS P.O. BOX 1314 ADDRESS P.O. BOX 1314
MORGANTOWN W.V. 26505 MORGANTOWN W.V. 26505

OCT 15 1985

FORM IV-6 (8-78) H.T. HALL

COUNTY NAME PERMIT

RECEIVED
NOV 30 1985

AFFIDAVIT OF PLUGGING AND FILLING WELL

DIVISION OF OIL & GAS
DEPT. OF ENERGY

AFFIDAVIT SHOULD BE MADE IN TRIPLICATE, one copy mailed to the Department, one copy to be retained by the Well Operator and the third copy (and extra copies if required) should be mailed to each coal operator at their respective addresses.

Consolidation Coal Company
Coal Operator or Owner
P.O. Box 1314, Morgantown, WV 26507-1314
Address

Consolidation Coal Company
Coal Operator or Owner
P.O. Box 1314, Morgantown, WV 26507-1314
Address

Noah Van Haines
Lease or Property Owner
Mannington, W. Va.
Address

Consolidation Coal Company
Name of Well Operator
P.O. Box 1314, Morgantown, WV 26507-1314
Complete Address

November 14, 1985
WELL AND LOCATION

Battelle District

Monongalia County

WELL NO. 4019

Noah Van Haines Farm

STATE INSPECTOR SUPERVISING PLUGGING Don Ellis, Fairmont, WV 26554

AFFIDAVIT

STATE OF WEST VIRGINIA,
County of Monongalia ss:

Calvin C. Lofton and Mark Wright

being first duly sworn according to law depose and say that they are experienced in the work of plugging and filling oil and gas wells and were employed by Consolidation Coal Company, well operator, and participated in the work of plugging and filling the above well, that said work was commenced on the 21st day of October, 19 85, and that the well was plugged and filled in the following manner:

Sand or Zone Record Formation	Filling Material	Plugs Used Size & Kind	Casing	
			CSG PULLED	CSG LEFT IN
Cleaned out wellbore to 1,750 feet. Pulled 260 feet of 8 inch casing. Pulled 15 feet of 2 inch junk pipe. Ran coal protection string as follows: 2 3/8 inch tubing followed by 1,480.78 feet of 4 1/2 inch casing. Latch down plug at 1,456.38 feet. Float valve at 1,480.78 feet. Circulated cement to surface as follows: Pumped 1,190 sacks of poz mix followed by 160 sacks of expanding cement. Displaced cement to 1,456.38 feet with water. Let set. Bailed dry. Extreme circulation problem.				
Coal Seams				
(Name) Pittsburgh	1,328 feet to 1,336 feet	5 feet of 4 1/2 inch casing with plaque stating: Consol 4019 47-061-0800P		

RECEIVED
NOV 19 1985
REGISTRATION
ENGINEERING

Handwritten signature
11/21/85

and that the work of plugging and filling said well was completed on the 8th day of November, 19 85.

And further deponents saith not.

Sworn to and subscribed before me this 14th day of November, 1985.

Calvin C. Lofton
Mark Wright
J. R. Ewert
Notary Public

My commission expires:
9/8/88

Permit No. 47-061-0800P