


10/3/85

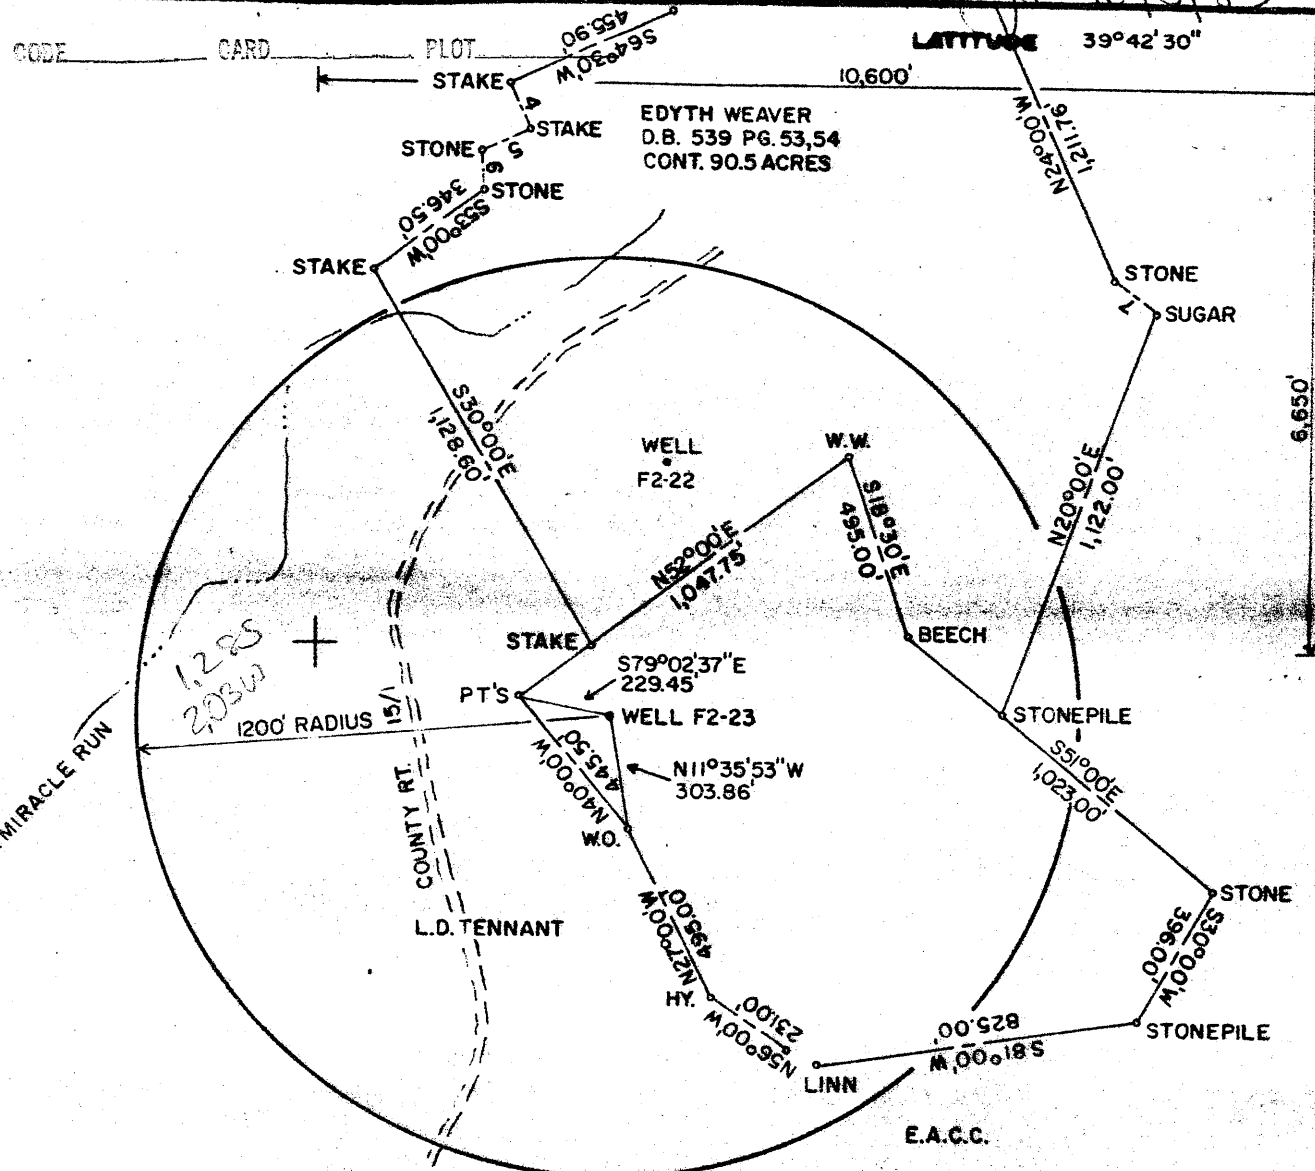


4-S 23°00'E - 128.04'
 5-S 65°00'W - 139.26'
 6-S 3°00'E - 106.10'
 7-N 51°00'W - 148.50'

15' loc calo
 4.65
 2.03w

FILE NO. F2-06-146
 DRAWING NO. F2-2-149
 SCALE 1"=500'
 MINIMUM DEGREE OF ACCURACY 1/2500
 PROVEN SOURCE OF ELEVATION USGS-BM 1014 GRAFTON 1902

I THE UNDERSIGNED, HEREBY CERTIFY THAT THIS PLAT IS CORRECT TO THE BEST OF MY KNOWLEDGE AND BELIEF AND SHOWS ALL THE INFORMATION REQUIRED BY LAW AND THE REGULATIONS ISSUED AND PRESCRIBED BY THE DEPARTMENT OF MINES.
 (SIGNED) Roger D. Raines 9/30/85
 R.P.E. 9752 L.L.S.

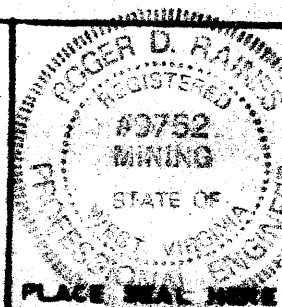

(+) DENOTES LOCATION OF WELL ON UNITED STATES TOPOGRAPHIC MAPS
 FORM IV-6
 (8-79)



DATE SEPTEMBER 21, 1985
 OPERATOR'S WELL NO. F2-23
 API WELL NO. 47-061-0801-P
 STATE COUNTY PERMIT

STATE OF WEST VIRGINIA
 DEPARTMENT OF MINES
 OIL AND GAS DIVISION

WELL TYPE: OIL GAS LIQUID INJECTION WASTE DISPOSAL
 (IF "GAS", PRODUCTION STORAGE DEEP SHALLOW
 LOCATION: ELEVATION 1319 WATER SHED RIGHT BRANCH MIRACLE RUN
 DISTRICT BATTELLE COUNTY MONONGALIA
 QUADRANGLE WADESTOWN 7 1/2' Mannington Ne
 SURFACE OWNER EDITH WEAVER ACRES 90.5
 OIL & GAS ROYALTY OWNER UNKNOWN LEASE ACRES UNKNOWN
 LEASE NO. _____
 PROPOSED WORK: DRILL CONVERT DRILL DEEPER REDRILL FRACTURE OR STIMULATE PLUS OFF OLD FORMATION PERFORATE NEW FORMATION OTHER PHYSICAL CHANGE IN WELL (SPECIFY) _____
 PLUS AND ABANDON CLEAR OUT AND REPLUG
 TARGET FORMATION UNKNOWN ESTIMATED DEPTH UNKNOWN
 WELL OPERATOR EASTERN ASSOC. COAL CORP DESIGNATED AGENT JOHN A. VEITCH OCT 15 1985
 ADDRESS RT 1 BOX 144 ADDRESS SAME
FAIRVIEW W.VA. 26570

RECEIVED
APR 30 1987

AFFIDAVIT OF PLUGGING AND FILLING WELL

DIVISION OF OIL & GAS
DEPARTMENT OF ENERGY

AFFIDAVIT SHOULD BE MADE IN TRIPLICATE, one copy mailed to the Department, one copy to be retained by the Well Operator and the third copy (and extra copies if required) should be mailed to each coal operator at their respective addresses.

Eastern Associated Coal Corp.
Coal Operator or Owner
Rt. 1, Box 144, Fairview, WV 26570
Address

Eastern Associated Coal Corporation
Name of Well Operator
Rt. 1, Box 144, Fairview, WV 26570
Complete Address

December 17, 19 85

Coal Operator or Owner
Address

WELL AND LOCATION
Battelle District
Monongalia County

Edyth Weaver, et al
Lease or Property Owner
83 Western Ave., Morgantown, WV 26505
Address

WELL NO. EACC-F2-23 (formerly A. Hikok #1)
A. Hikok, 30½ Acre Farm

STATE INSPECTOR SUPERVISING PLUGGING Don Ellis

AFFIDAVIT

STATE OF WEST VIRGINIA,
County of Monongalia ss:
Ray Smith and Melvin Eddy

being first duly sworn according to law depose and say that they are experienced in the work of plugging and filling oil and gas wells and were employed by Chisler Brothers, well operator, and participated in the work of plugging and filling the above well, that said work was commenced on the 13 day of November, 19 85, and that the well was plugged and filled in the following manner:

Sand or Zone Record Formation	Filling Material	Plugs Used Size & Kind	Casing	
			CSG PULLED	CSG LEFT IN
1. Cleaned out well to depth of 1506'.			Set a total	
2. Run 7" pipe to 1081' (Installed to drill to bottom).			of 1156' of	
3. Put stone bridge 1506' to 1491'.			4 1/2" casing	
4. Run 4 1/2" pipe to 1491', gelled hole - 15 bags gel and 5 bags paper mulch and got circulation.			starting at	the surface.
5. Pulled 7" pipe 1081'				
6. Regelled hole 25 bags gel and 2 bags paper mulch.				
7. Run 175 bags Chem Comp cement, pulled 10 joints 4 1/2" pipe (or 335')				
8. Pumped 776 bags Portland, 125 bags Chem Comp. Pumped plug down.				
9. Tagged cement outside of 4 1/2" down 35' 6". Pumped 1 bag gel flakes, 1 bag gel, 1 bag paper mulch, 125 bags Chem Comp cement, tagged cement at 8 feet down. Pumped 1 bag paper mulch. 15 bags Chem Comp Cement to surface.				
10. Tagged plug inside 4 1/2" at 487'. Drilled out to 1130'				
Coal Seams			Description of Monument	
(Name) Pittsburgh 1014' to 1022'			4 1/2" X 2" Swedge with a 2" stop at surface. 2" pipe with a metal plate monument welded to the 2" pipe.	
(Name)				
(Name)				
(Name)				

and that the work of plugging and filling said well was completed on the 17 day of December, 19 85.

And further deponents saith not.

Sworn to and subscribed before me this 21st day of January, 19 86.

Ray Smith
Melvin R. Eddy
James M. ...
Notary Public

My commission expires:
July 17, 1995

MAY 11 1987
47-061-0001 P
Permit No.