


(+) DENOTES LOCATION OF WELL ON UNITED STATES TOPOGRAPHIC MAPS

FILE NO. _____
 DRAWING NO. _____
 SCALE 1" = 500'
 MINIMUM DEGREE OF ACCURACY 1 IN 5000
 PROVEN SOURCE OF ELEVATION COMPANY SURVEY
TIED INTO THE U.S.G.S. NETWORK

I THE UNDERSIGNED, HEREBY CERTIFY THAT THIS PLAT IS CORRECT TO THE BEST OF MY KNOWLEDGE AND BELIEF AND SHOWS ALL THE INFORMATION REQUIRED BY LAW AND THE REGULATIONS ISSUED AND PRESCRIBED BY THE DEPARTMENT OF ENERGY.
 (SIGNED) J. E. Nelson McCoy
 R.P.E. _____ L.L.S. 110

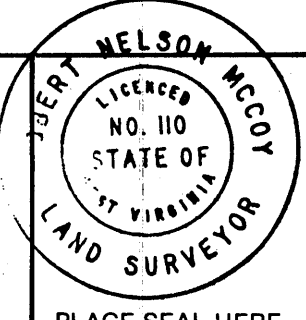

STATE OF WEST VIRGINIA
 DEPARTMENT OF ENERGY
 OIL AND GAS DIVISION



DATE OCTOBER 31, 19 85
 OPERATOR'S WELL NO. MI-530
 API WELL NO. _____

WELL TYPE: OIL ___ GAS ___ LIQUID INJECTION ___ WASTE DISPOSAL ___
 (IF "GAS,") PRODUCTION ___ STORAGE ___ DEEP ___ SHALLOW X ABANDONED X
 LOCATION: ELEVATION 1341.71 WATER SHED _____ DAYS RUN _____
 DISTRICT CLAY COUNTY MONONGALIA
 QUADRANGLE BLACKSVILLE W.V., PA. 75 15' NW

SURFACE OWNER RICHARD E. & BERTHA B. WILSON ACREAGE 57.29
 OIL & GAS ROYALTY OWNER UNKNOWN LEASE ACREAGE _____
 LEASE NO. _____

PROPOSED WORK: DRILL ___ CONVERT ___ DRILL DEEPER ___ REDRILL X FRACTURE OR STIMULATE ___ PLUG OFF OLD FORMATION ___ PERFORATE NEW FORMATION ___ OTHER PHYSICAL CHANGE IN WELL (SPECIFY) _____

PLUG AND ABANDON ___ CLEAN OUT AND REPLUG X
 TARGET FORMATION NONE ESTIMATED DEPTH _____
 WELL OPERATOR CONSOLIDATION COAL COMPANY DESIGNATED AGENT ROGER E. DUCKWORTH
 ADDRESS P.O. BOX 1314 MORGANTOWN W.V. 26505 ADDRESS P.O. BOX 1314 MORGANTOWN W.V. 26505

JUL 7 1986

H.T. HALL 48673 FORM WW-6

COUNTY NAME PERMIT

RECEIVED
DEC 11 1986

AFFIDAVIT OF PLUGGING AND FILLING WELL

DIVISION OF OIL & GAS
DEPARTMENT OF ENERGY

AFFIDAVIT SHOULD BE MADE IN TRIPLICATE, one copy mailed to the Division, one copy to be retained by the Well Operator and the third copy (and extra copies if required) should be mailed to each coal operator at their respective addresses.

Consolidation Coal Co.
Coal Operator or Owner
P.O. Box 1314, Morgantown, W. Va.
Address

Consolidation Coal Co.
Coal Operator or Owner
P.O. Box 1314, Morgantown, W. Va.
Address

Richard E. & Bertha Wilson
Lease or Property Owner
Fairview, W. Va.
Address

Consolidation Coal Co.
Name of Well Operator
P.O. Box 1314, Morgantown, W. Va.
Complete Address
October 7 19 86

WELL AND LOCATION
Clay District
Monongalia County

WELL NO. M1-530

_____ Farm

STATE INSPECTOR SUPERVISING PLUGGING Don Ellis

AFFIDAVIT

STATE OF WEST VIRGINIA,
County of Monongalia

ss:

Larry L. Yost and David D. Yost

being first duly sworn according to law depose and say that they are experienced in the work of plugging and filling oil and gas wells and were employed by Consolidation Coal Co., well operator, and participated in the work of plugging and filling the above well, that said work was commenced on the 19th day of September, 19 86, and that the well was plugged and filled in the following manner:

Sand or Zone Record Formation	Filling Material	Plugs Used Size & Kind	Casing	
			CSG PULLED	CSG LEFT IN
	Pulled 2140' of 5 3/16" casing. Ran tubing to 2300'. Circulated 130 sacks of cement. Pulled up to 1870'. Circulated out.	5 3/16"	2140'	
	Pulled 1824' of 7" casing; Pulled 1185' of 8 1/2" casing. Ran coal protection string as follows; 1080' of 4 1/2" casing; 746' of 2 3/8" tubing; Latchdown at 1056'; Float valve at 1080'; Swedge at 1080'. Circulated cement to surface as follows: 970 sacks of Pox Mix; 435 sacks of expanding type cement; 1,000 gal. of mud flush. Let set, bailed dry, set monument.	7" Top - 1824' Bottom - 2135"	1824'	
		8 1/2" Top - 1185' Bottom - 1708'	1185'	
Coal Seams				
(Name) Pittsburgh- 910'				
(Name)				
(Name)				
(Name)				
				Description of Monument
				6' of 4 1/2" casing with plating stating Consol M1-530.
				47-061-0820-P

and that the work of plugging and filling said well was completed on the 3rd day of October, 19 86.
And further deponents saith not.

Sworn to and subscribed before me this 3rd day of October, 19 86.
Larry L. Yost
David D. Yost
Kelli D. Wilson
Notary Public

My commission expires:
March 15, 1993

23 1986
Permit No. 47-061-0820-1