


82B 8/19/86 P.


LATITUDE 39° 40' 00"
7.150'

LONGITUDE 80° 51' 00"
9.500'

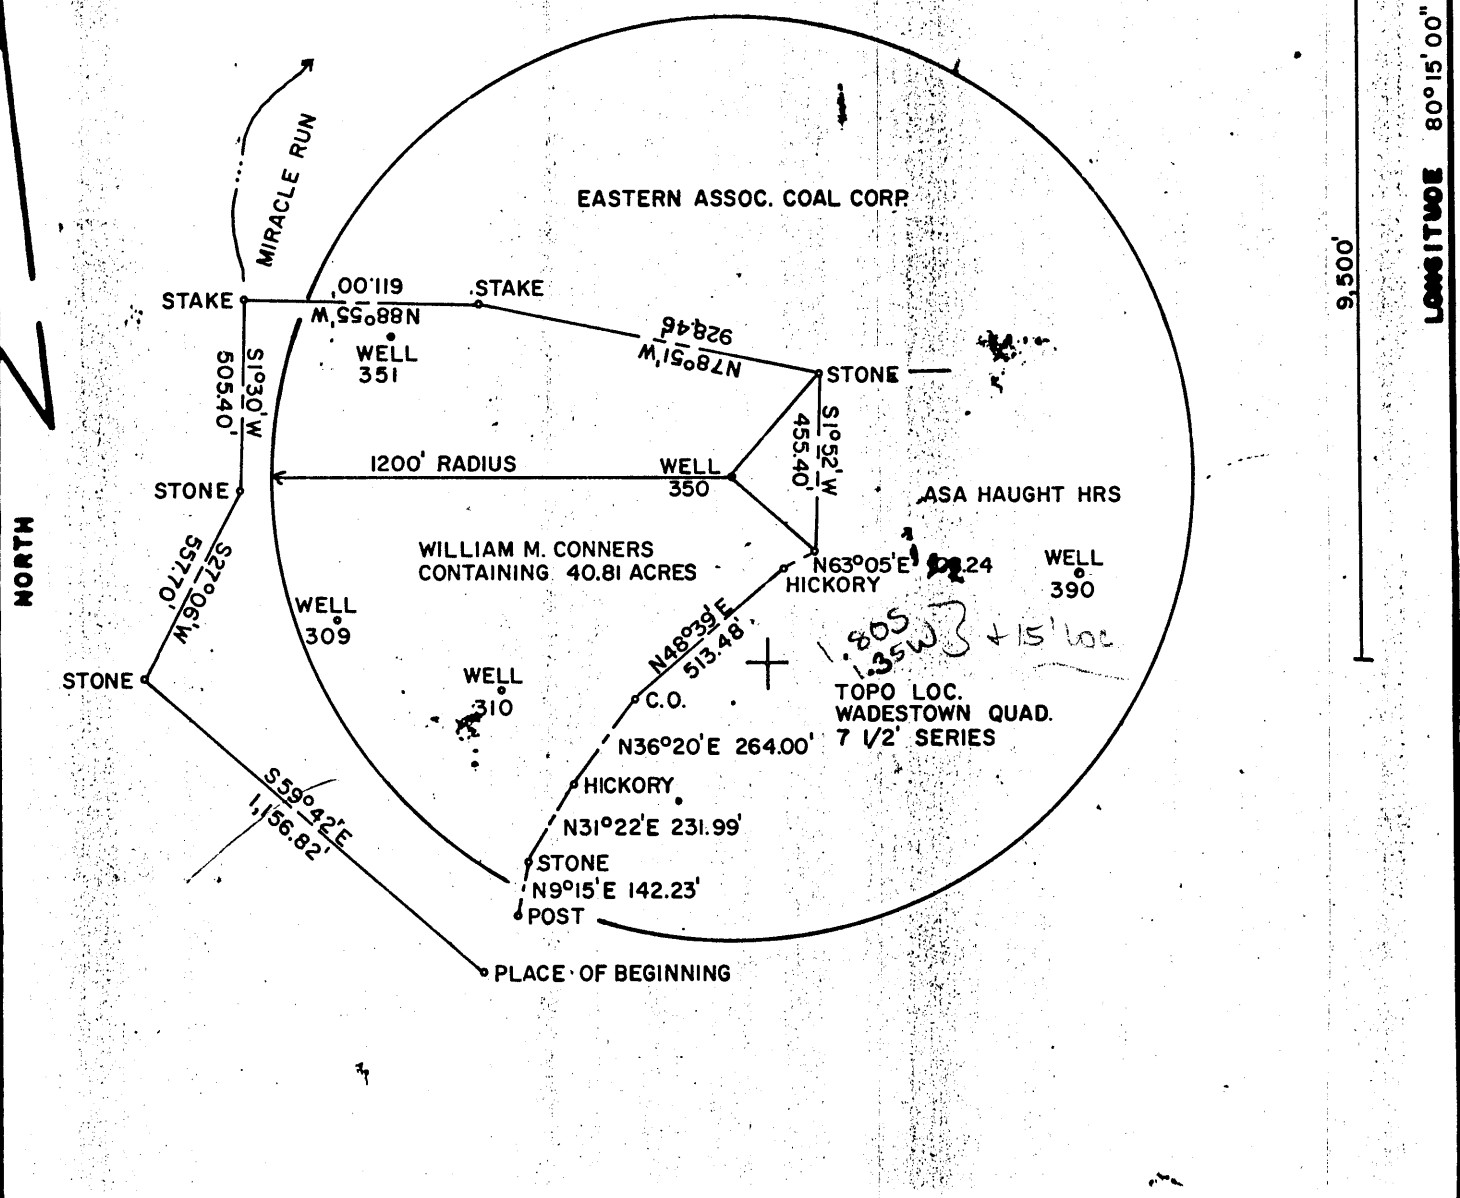

FILE NO. F2-0G-154
DRAWING NO. F2-2-161
SCALE 1"=500'
MINIMUM DEGREE OF ACCURACY 1/2500
PROVEN SOURCE OF ELEVATION USGS-BM "1014 GRAFTON 1902"

I THE UNDERSIGNED, HEREBY CERTIFY THAT THIS PLAT IS CORRECT TO THE BEST OF MY KNOWLEDGE AND BELIEF AND SHOWS ALL THE INFORMATION REQUIRED BY LAW AND THE REGULATIONS ISSUED AND PRESCRIBED BY THE DEPARTMENT OF MINES.
(SIGNED) Roger D. Raines 8/18/86
R.P.E. 9752 L.L.S. _____

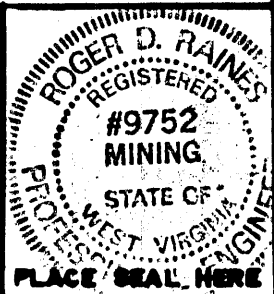

(+) DENOTES LOCATION OF WELL ON UNITED STATES TOPOGRAPHIC MAPS
FORM IV-6
(8-78)



DATE AUGUST 6, 1986
OPERATOR'S WELL NO F2-350
API WELL NO. 47-061-0824-P
STATE MONONGALIA COUNTY PERMIT

STATE OF WEST VIRGINIA
DEPARTMENT OF MINES
OIL AND GAS DIVISION

WELL TYPE: OIL GAS _____ LIQUID INJECTION _____ WASTE DISPOSAL _____
(IF "GAS", PRODUCTION _____ STORAGE _____ DEEP _____ SHALLOW _____)
LOCATION: ELEVATION 1,405' WATER SHED MIRACLE RUN
DISTRICT BATTELLE COUNTY MONONGALIA
QUADRANGLE WADESTOWN 7 1/2' Mannington EC
SURFACE OWNER WILLIAM M. CONNERS ACREAGE 40.81
OIL & GAS ROYALTY OWNER FORMERLY SOUTH PENN OIL CO. LEASE ACREAGE 96
LEASE NO. _____
PROPOSED WORK: DRILL _____ CONVERT _____ DRILL DEEPER _____ REDRILL FRACTURE OR STIMULATE _____ PLUS OFF OLD FORMATION _____ PERFORATE NEW FORMATION _____ OTHER PHYSICAL CHANGE IN WELL (SPECIFY) _____
PLUS AND ABANDON CLEAN OUT AND REPLUG _____
TARGET FORMATION GORDON ESTIMATED DEPTH 3,370'
WELL OPERATOR EASTERN ASSOC. COAL CORP. DESIGNATED AGENT JOHN A. VEITCH AUG 25 1986
ADDRESS RT. 1 BOX 144 FAIRVIEW W.VA. 26570 ADDRESS RT. 1 BOX 144 FAIRVIEW W.VA. 26570

RECEIVED
APR 30 1987

DIVISION OF OIL & GAS
DEPARTMENT OF ENERGY

AFFIDAVIT OF PLUGGING AND FILLING WELL

AFFIDAVIT SHOULD BE MADE IN TRIPPLICATE, one copy mailed to the Division, one copy to be retained by the Well Operator and the third copy (and extra copies if required) should be mailed to each coal operator at their respective addresses.

Eastern Assoc. Coal Corp.
Coal Operator or Owner
Rt. 1, Box 144
Address
Fairview, WV 26570
Coal Operator or Owner
Address
William M. Conner
Lease or Property Owner
P.O. Box 25, Wana, WV 26598
Address

Eastern Assoc. Coal Corp.
Name of Well Operator
Rt. 1, Box 144, Fairview, WV 26570
Complete Address
November 12, 1986
WELL AND LOCATION
Battelle District
Monongalia County
WELL NO. F2-350 E.A.C.C.
M. L. Anderson Farm

STATE INSPECTOR SUPERVISING PLUGGING Don Ellis

AFFIDAVIT

STATE OF WEST VIRGINIA,
County of Monongalia

ss:

Elmer Moore

and

Jim Gump

being first duly sworn according to law depose and say that they are experienced in the work of plugging and filling oil and gas wells and were employed by Chisler Brothers, well operator, and participated in the work of plugging and filling the above well, that said work was commenced on the 24 day of October, 19 86, and that the well was plugged and filled in the following manner:

Sand or Zone Record Formation	Filling Material	Plugs Used Size & Kind	Casing	
			CSG PULLED	CSG LEFT IN
1. Cleaned out to a depth of 1500'.		Pulled 67' of old 8"		
2. Run logs - Gamma Ray, Neutron & Caliper		1247' 11" of 4 1/2"		
3. Ripped old 8" pipe from 1400 to 1420.				
4. Cut old 8" pipe at 1150' pulled 67' & ripped old 10" from 1100' to 1130'.				
5. Run 4 1/2" pipe to 1475' pumped 37 sack gel, 6 bags paper mulch & got circulation.				
6. Recirculated hole with 1 sack gel, run 150 bags Chem Comp cement, pulled 4 1/2" pipe to 1247' 11", Run 720 bags Portland Cement 150 bags Chem Comp Cement & got circulation				
7. Pumped latch down plug to 1227' 11".				
8. Bailed water out of inside 4 1/2" pipe.				
Coal Seams		Description of Monument		
(Name) Pittsburgh Coal 1110' to 1118'		4 1/2" X 2" Swedge with a 2" stop at the surface. 2" pipe with a metal plat monument welded to the 2" pipe.		
(Name)				
(Name)				
(Name)				

and that the work of plugging and filling said well was completed on the 12 day of November, 19 86.

And further deponents saith not.

Sworn to and subscribed before me this 17th day of Nov., 19 86.

Elmer Moore
Jim Gump
James Moser
Notary Public

My commission expires:

July 17, 1995

MAY 11 1987

Permit No. 47-061-0824-P