



*Jamie 4/13/88*

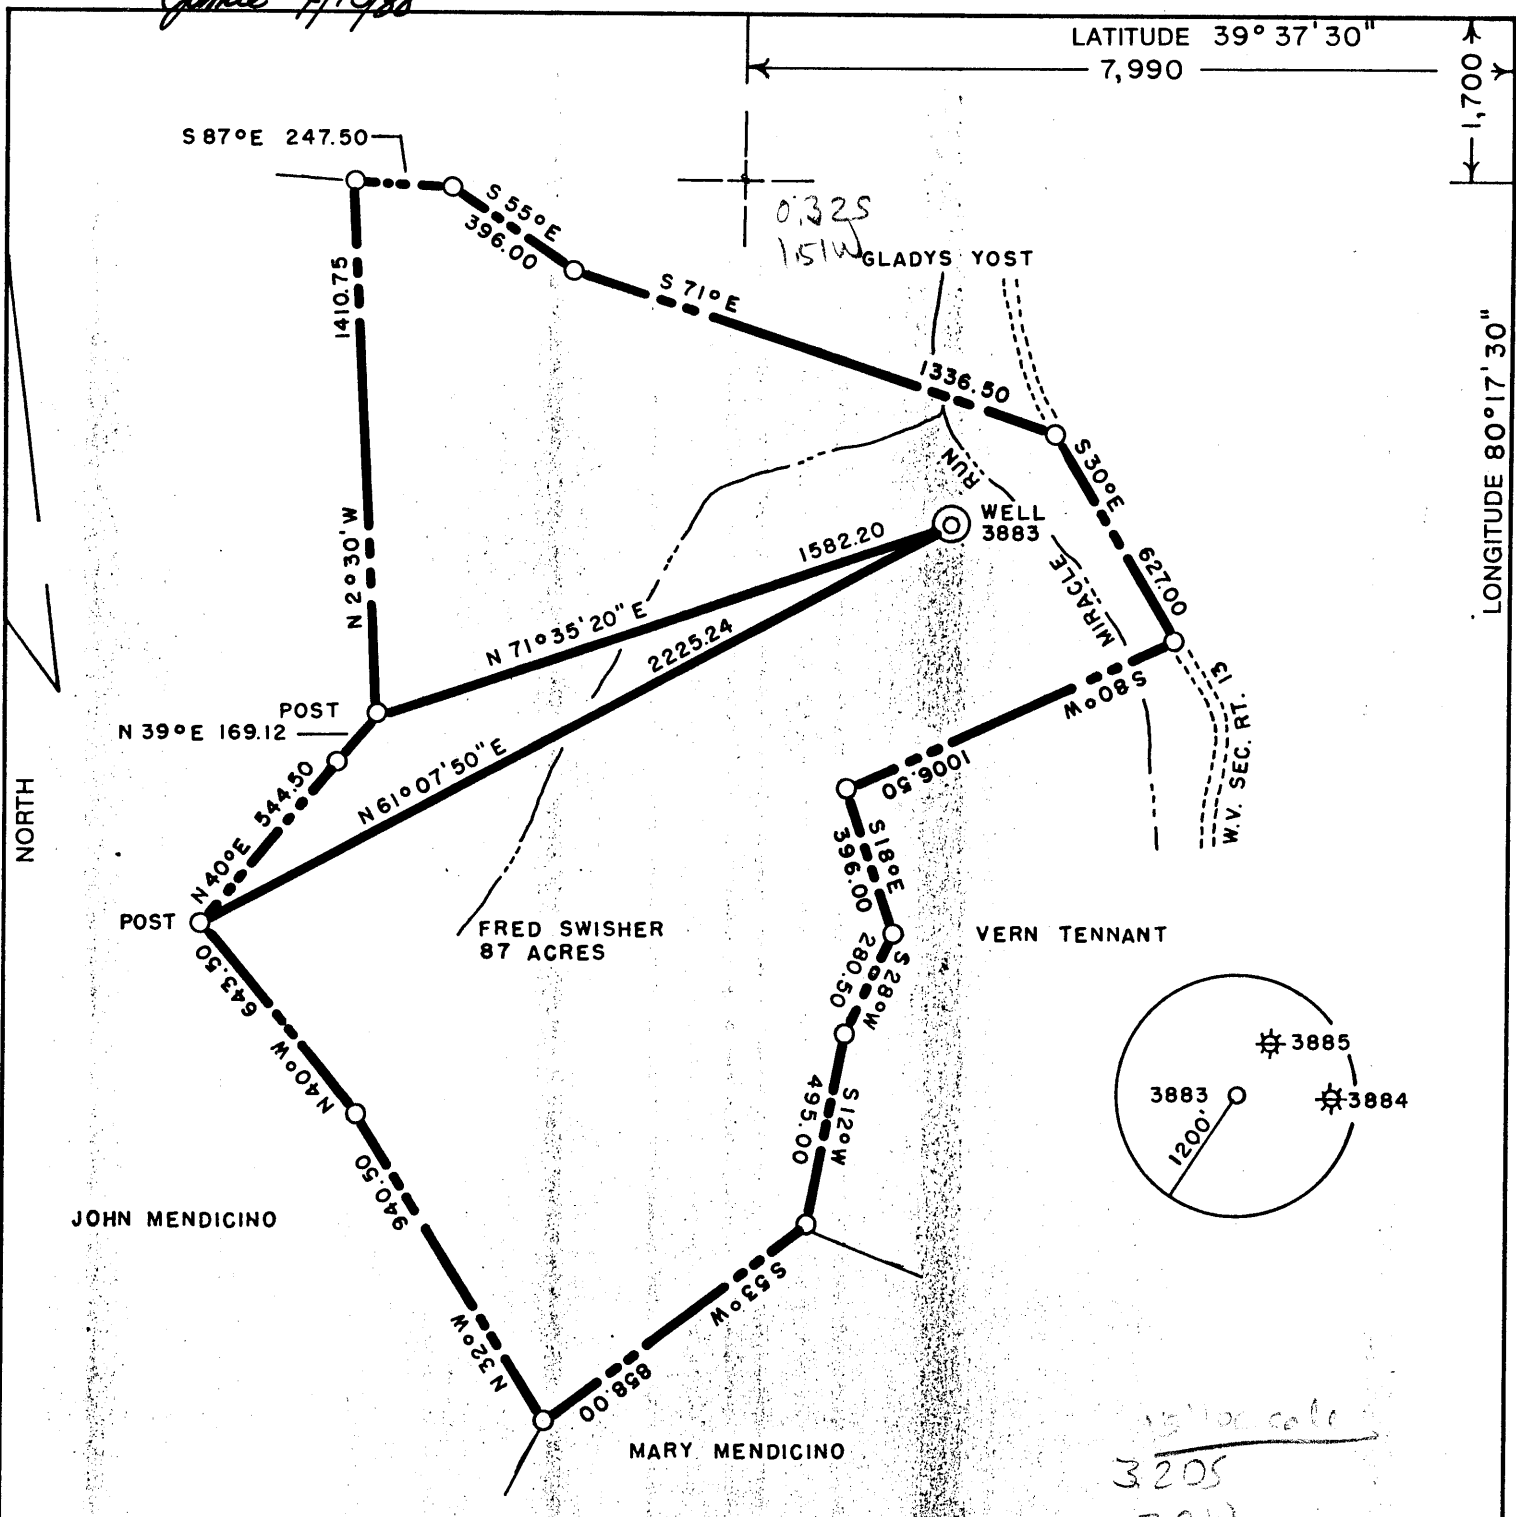

(+) DENOTES LOCATION OF WELL ON UNITED STATES TOPOGRAPHIC MAPS

FILE NO. \_\_\_\_\_  
 DRAWING NO. \_\_\_\_\_  
 SCALE 1" = 500'  
 MINIMUM DEGREE OF ACCURACY 1 IN 5000  
 PROVEN SOURCE OF ELEVATION COMPANY SURVEY TIED INTO THE U.S.G.S. NETWORK

I THE UNDERSIGNED, HEREBY CERTIFY THAT THIS PLAT IS CORRECT TO THE BEST OF MY KNOWLEDGE AND BELIEF AND SHOWS ALL THE INFORMATION REQUIRED BY LAW AND THE REGULATIONS ISSUED AND PRESCRIBED BY THE DEPARTMENT OF MINES.  
 (SIGNED) R. Nelson McCoy  
 R.P.E. \_\_\_\_\_ L.L.S. 110

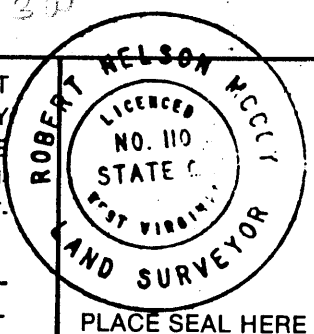

*151' or 151'  
 3205  
 3173W*

**STATE OF WEST VIRGINIA**  
 DEPARTMENT OF MINES  
**OIL AND GAS DIVISION**



DATE SEPTEMBER 12 1985  
 OPERATOR'S WELL NO. 3883  
 API WELL NO. \_\_\_\_\_

WELL TYPE: OIL \_\_\_ GAS \_\_\_ LIQUID INJECTION \_\_\_ WASTE DISPOSAL \_\_\_  
 (IF "GAS,") PRODUCTION \_\_\_ STORAGE \_\_\_ DEEP \_\_\_ SHALLOW X ABANDONED X

LOCATION: ELEVATION 1160.89 WATER SHED MIRACLE RUN  
 DISTRICT BATTELLE COUNTY MONONGALIA  
 QUADRANGLE MANNINGTON, W.V. 7.5 +151c

SURFACE OWNER FRED J. SWISHER ACREAGE 87  
 OIL & GAS ROYALTY OWNER MANUFACTURER LIGHT & HEAT LEASE ACREAGE \_\_\_\_\_  
 LEASE NO. \_\_\_\_\_

PROPOSED WORK: DRILL \_\_\_ CONVERT \_\_\_ DRILL DEEPER \_\_\_ REDRILL X FRACTURE OR STIMULATE \_\_\_ PLUG OFF OLD FORMATION \_\_\_ PERFORATE NEW FORMATION \_\_\_ OTHER PHYSICAL CHANGE IN WELL (SPECIFY) \_\_\_\_\_  
APR 15 1988

PLUG AND ABANDON \_\_\_ CLEAN OUT AND REPLUG X  
 TARGET FORMATION NONE ESTIMATED DEPTH \_\_\_\_\_  
 WELL OPERATOR CONSOLIDATION COAL COMPANY DESIGNATED AGENT ROGER E. DUCKWORTH  
 ADDRESS P.O. BOX 1314 MORGANTOWN, W.V. 26505 ADDRESS P.O. BOX 1314 MORGANTOWN, W.V. 26505

FORM IV-6 (8-78)  
 H.T. HALL

COUNTY NAME  
 PERMIT

RECEIVED  
SEP 21 1988

AFFIDAVIT OF PLUGGING AND FILLING WELL

DIVISION OF OIL & GAS  
DEPARTMENT OF ENERGY

AFFIDAVIT SHOULD BE MADE IN TRIPLICATE, one copy mailed to the Division, one copy to be retained by the Well Operator and the third copy (and extra copies if required) should be mailed to each coal operator at their respective addresses.

Consolidation Coal Company

Coal Operator or Owner  
P. O. Box 1314, Morgantown, WV 26507-1314  
Address

Coal Operator or Owner  
Fred J. & Billie Swisher  
Address  
Fred J. & Billie Swisher  
Lease or Property Owner  
R. R. #1, Box 29, Wadestown, WV 26589  
Address

Consolidation Coal Company

Name of Well Operator  
P. O. Box 1314, Morgantown, WV 26507-1314  
Complete Address  
May 13, 19 88  
WELL AND LOCATION  
Battelle District  
Monongalia County  
WELL NO. 3883  
Fred J. Swisher Farm

STATE INSPECTOR SUPERVISING PLUGGING Don Ellis, Fairmont, WV 26554

AFFIDAVIT

STATE OF WEST VIRGINIA,  
County of Harrison

ss:

Calvin C. Lofton and George R. Gore

being first duly sworn according to law depose and say that they are experienced in the work of plugging and filling oil and gas wells and were employed by Consolidation Coal Company, well operator, and participated in the work of plugging and filling the above well, that said work was commenced on the 20th day of April, 19 88, and that the well was plugged and filled in the following manner:

Sand or Zone Record Formation	Filling Material	Plugs Used Size & Kind	Casing	
			CSG PULLED	CSG LEFT IN
Pulled 2,895' of 5 3/16" casing. Cemented hole from 3,300' back to 1,700'. Pulled 1,642' of 6 5/8" casing. 6 5/8" casing left in hole from 1,642' to 2,410'. Pulled 214' of 8 1/2" casing. 8 1/2" casing left in hole from 1,176' to 1,410'. Cleaned 7 7/8" hole to 1,642'. Ran coal protection string as follows: 521.48' of 2 3/8" tubing followed by 1,108.03' of 4 1/2" casing. Latch down plug at 1,087.76'. Float valve at 1,108.03'. Swedge: 1,109.03'. Circulated cement to surface as follows: Pumped 600 sacks of pox mix followed by 295 sacks of expanding cement. Displaced cement to 1,087.76 feet with water. Let set, bailed dry.				
TOTAL DEPTH: 1,629.51 feet.				
Coal Seams		Description of Monument		
(Name) Pittsburgh:	922 feet to 932 feet.	5 feet of 4 1/2" casing with plaque stating:		
(Name)		Consol #3883		
(Name)		47-61-0861-P		

and that the work of plugging and filling said well was completed on the 29th day of April, 19 88.

And further deponents saith not.

Sworn to and subscribed before me this 13th day of May, 19 88

*Calvin C. Lofton*  
*George R. Gore*

*J. H. Everett*  
Notary Public

My commission expires:  
September 08, 1988

SEP 23 1988

Permit No. 47-61-0861-P