


A	= N 38° 30' W	313.50
B	= N 7° 00' E	198.00
C	= N 11° 00' E	726.00
D	= N 10° 00' W	701.25
E	= N 6° 52' W	123.75
F	= N 5° 00' W	280.50
G	= N 6° 24' E	577.50
H	= N 67° 00' E	569.25
I	= N 36° 00' E	841.50
J	= N 60° 24' W	858.00
K	= S 63° 30' E	541.20
L	= N 87° 00' E	564.30
M	= S 54° 11' E	338.60
N	= S 12° 11' W	61.40
O	= S 81° 12' W	487.11
P	= N 77° 48' W	198.5
Q	= S 73° 37' W	655.81
R	= S 55° 31' W	99.07
S	= S 27° 01' W	584.53
T	= S 41° 48' W	113.90
U	= S 57° 32' W	247.51

(+) DENOTES LOCATION OF WELL ON UNITED STATES TOPOGRAPHIC MAPS

FILE NO. _____
 DRAWING NO. _____
 SCALE 1" = 1000'
 MINIMUM DEGREE OF ACCURACY 1" IN 5000
 PROVEN SOURCE OF ELEVATION COMPANY SURVEY
 TIED INTO U.S.G.S. NETWORK

I THE UNDERSIGNED, HEREBY CERTIFY THAT THIS PLAT IS CORRECT TO THE BEST OF MY KNOWLEDGE AND BELIEF AND SHOWS ALL THE INFORMATION REQUIRED BY LAW AND THE REGULATIONS ISSUED AND PRESCRIBED BY THE DEPARTMENT OF ENERGY.
 (SIGNED) Carl Morris
 R.P.E. _____ L.L.S. 460

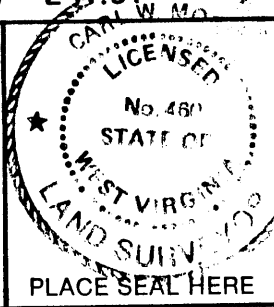

STATE OF WEST VIRGINIA
 DEPARTMENT OF ENERGY
 OIL AND GAS DIVISION



DATE AUGUST 23 19 88
 OPERATOR'S WELL NO. 3863
 API WELL NO. _____

WELL TYPE: OIL ___ GAS ___ LIQUID INJECTION ___ WASTE DISPOSAL ___
 (IF "GAS,") PRODUCTION ___ STORAGE ___ DEEP ___ SHALLOW X ABANDONED X
 LOCATION: ELEVATION 1243.19 WATER SHED PAW PAW
 DISTRICT BATTELLE COUNTY MONONGALIA
 QUADRANGLE MANNINGTON W.V. +15' EC
 SURFACE OWNER CONSOLIDATION COAL CO. ACREAGE 335.72
 OIL & GAS ROYALTY OWNER _____ LEASE ACREAGE _____
 LEASE NO. _____
 PROPOSED WORK: DRILL ___ CONVERT ___ DRILL DEEPER ___ REDRILL X FRACTURE OR
 STIMULATE ___ PLUG OFF OLD FORMATION ___ PERFORATE NEW
 FORMATION ___ OTHER PHYSICAL CHANGE IN WELL (SPECIFY) SEP 09 1988
 PLUG AND ABANDON ___ CLEAN OUT AND REPLUG X
 TARGET FORMATION NONE ESTIMATED DEPTH _____
 WELL OPERATOR CONSOLIDATION COAL CO. DESIGNATED AGENT ROGER E. DUCKWORTH
 ADDRESS P.O. BOX 1314 MORGANTOWN W.V. 26505 ADDRESS P.O. BOX 1314 MORGANTOWN W.V. 26505

H.T. HALL 48673 FORM WW-6

COUNTY NAME PERMIT

RECEIVED
FEB 28 1989

AFFIDAVIT OF PLUGGING AND FILLING WELL

DIVISION OF OIL & GAS
DEPARTMENT OF ENERGY

AFFIDAVIT SHOULD BE MADE IN TRIPLICATE, one copy mailed to the Division, one copy to be retained by the Well Operator and the third copy (and extra copies if required) should be mailed to each coal operator at their respective addresses.

Consolidation Coal Company
Coal Operator or Owner
P. O. Box 1314, Morgantown, WV 26507-1314

Consolidation Coal Company
Name of Well Operator
P. O. Box 1314, Morgantown, WV 26507-1314

Address

Complete Address

Coal Operator or Owner

February 01, 19 89

Address

WELL AND LOCATION

Consolidation Coal Company

Battelle District

Lease or Property Owner

Monongalia County

P. O. Box 1314, Morgantown, WV 26507-1314

WELL NO. 3863

Address

Consolidation Coal Company Farm

STATE INSPECTOR SUPERVISING PLUGGING Don Ellis, Fairmont, WV

AFFIDAVIT


STATE OF WEST VIRGINIA,
County of Harrison

ss:

Calvin C. Lofton and George R. Gore

being first duly sworn according to law depose and say that they are experienced in the work of plugging and filling oil and gas wells and were employed by Consolidation Coal Company, well operator, and participated in the work of plugging and filling the above well, that said work was commenced on the 18th day of January, 19 89, and that the well was plugged and filled in the following manner:

Sand or Zone Record Formation	Filling Material	Plugs Used Size & Kind	Casing	
			CSG PULLED	CSG LEFT IN
Cleaned 9 7/8" hole to 950'. Reduced hole to 6 1/2" at 950'. Extreme difficulty getting inside 7" casing at 958'. Cleaned 6 1/2" hole to 1,621'. Pulled 132' of 7" casing, 7" left in hole from 1,090' to 1,621'. Drilled 9 7/8" hole thru Pittsburgh Coal (936' to 944'. Ran coal protection string as follows: 496.84' of 2 3/8" tubing followed by 1,094.85' of 4 1/2" casing. Latch down plug at 1,067.58'. Float valve at 1,094.85'. Swedge at 1,095.85'. Circulated cement to surface as follows: Pumped 500 sacks of poz mix followed by 210 sacks of thixotropic cement. Used 1,000 gallons mud flush. Displaced cement to 1,067.58' with water. Let set, bailed dry.				
TOTAL DEPTH: 1,591.69 feet				
Coal Seams		Description of Monument		
(Name) Pittsburgh	936 feet to 944 feet	5 feet of 4 1/2" casing with plaque stating: Consol WV #3863 #47-061-0878-P		

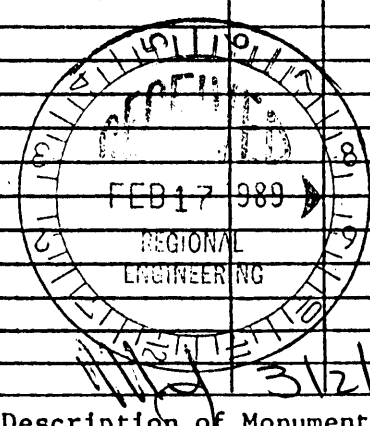

and that the work of plugging and filling said well was completed on the 31st day of January, 1989.

And further deponents saith not.

Sworn to and subscribed before me this 1st day of February, 19 89.

Calvin C. Lofton
George R. Gore
Notary Public

My commission expires:
April 21, 1993

Permit No. 47-061-0878-P

3/3/89