
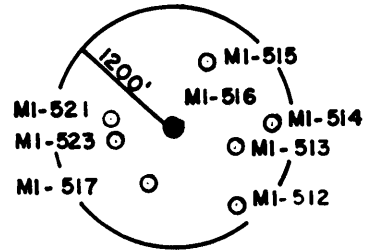


Jamie 1/4/89

39°40'00" LATITUDE
10,250

8,620
80°10'00" LONGITUDE

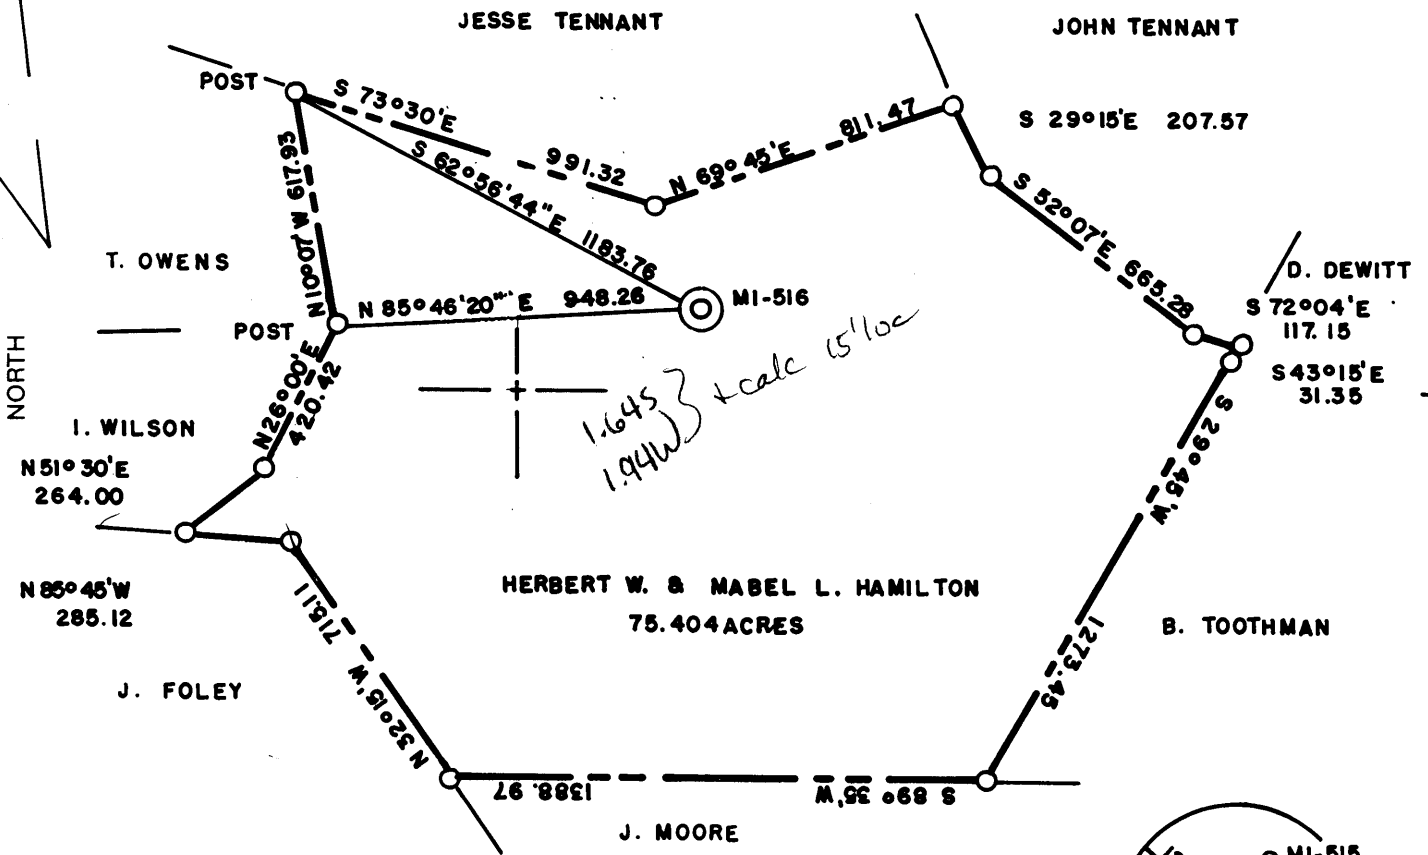

(+) DENOTES LOCATION OF WELL ON UNITED STATES TOPOGRAPHIC MAPS

FILE NO. _____
 DRAWING NO. _____
 SCALE **1" = 500'**
 MINIMUM DEGREE OF ACCURACY **1 IN 5000**
 PROVEN SOURCE OF ELEVATION **COMPANY SURVEY TIED INTO U.S.G.S. NETWORK**

I THE UNDERSIGNED, HEREBY CERTIFY THAT THIS PLAT IS CORRECT TO THE BEST OF MY KNOWLEDGE AND BELIEF AND SHOWS ALL THE INFORMATION REQUIRED BY LAW AND THE REGULATIONS ISSUED AND PRESCRIBED BY THE DEPARTMENT OF ENERGY.
 (SIGNED) Carl Morris
 R.P.E. _____ L.L.S. **460**

PLACE SEAL HERE

STATE OF WEST VIRGINIA
 DEPARTMENT OF ENERGY
 OIL AND GAS DIVISION



DATE 7-14, 19 88
 OPERATOR'S WELL NO. MI-516
 API WELL NO. _____

WELL TYPE: OIL GAS LIQUID INJECTION WASTE DISPOSAL
 (IF "GAS,") PRODUCTION STORAGE DEEP SHALLOW ABANDONED
 STATE COUNTY PERMIT

LOCATION: ELEVATION 1540.78 WATER SHED JAKES RUN
 DISTRICT CLAY COUNTY MONONGALIA

SURFACE OWNER HERBERT W. & MABEL L. HAMILTON ACREAGE 75.404

OIL & GAS ROYALTY OWNER _____ LEASE ACREAGE _____

LEASE NO. _____

PROPOSED WORK: DRILL CONVERT DRILL DEEPER REDRILL FRACTURE OR STIMULATE PLUG OFF OLD FORMATION PERFORATE NEW FORMATION OTHER PHYSICAL CHANGE IN WELL (SPECIFY) _____

PLUG AND ABANDON CLEAN OUT AND REPLUG

TARGET FORMATION NONE ESTIMATED DEPTH _____

WELL OPERATOR CONSOLIDATION COAL CO. DESIGNATED AGENT ROGER E. DUCKWORTH

ADDRESS P.O. BOX 1314 MORGANTOWN W.V. 26505 ADDRESS P.O. BOX 1314 MORGANTOWN W.V. 26505

JAN 06 1988

AFFIDAVIT OF PLUGGING AND FILLING WELL

AFFIDAVIT SHOULD BE MADE IN TRIPLICATE, one copy mailed to the Division, one copy to be retained by the Well Operator and the third copy (and extra copies if required) should be mailed to each coal operator at their respective addresses.

Consolidation Coal Co.
Coal Operator or Owner
P.O. Box 1314 Morgantown, W.Va. 26507
Address

Consolidation Coal Co.
Coal Operator or Owner
P.O. Box 1314 Morgantown, W.VA.
Address

Herbert & Mabel Hamilton
Lease or Property Owner
Rt. 2 FAirview, W.Va. 26570
Address

Consolidation Coal Co.
Name of Well Operator
P.O. Box 1314 Morgantown, W.Va. 26507
Complete Address

May 31 19 89

WELL AND LOCATION

Clay District

Monongalia County

WELL NO. M1-516

Hamilton Farm

STATE INSPECTOR SUPERVISING PLUGGING Don Ellis

AFFIDAVIT

STATE OF WEST VIRGINIA,
County of Monongalia ss:

Larry L. Yost and Dennis L. Yost

being first duly sworn according to law depose and say that they are experienced in the work of plugging and filling oil and gas wells and were employed by Consolidation Coal Co., well operator, and participated in the work of plugging and filling the above well, that said work was commenced on the 8th day of May, 19 89, and that the well was plugged and filled in the following manner:

Sand or Zone Record Formation	Filling Material	Plugs Used ft. Size & Kind	Casing	
			C5G PULLED	C5G LEFT IN
	Cleaned wellbore to 1530		306	Et.
	Pulled 306 ft. of 6 5/8"	6 5/8"	280	Et.
	casing; Pulled 280 ft. of	8 1/2"	TOP	
	8 1/2" casing. Pulled 10"	10"	640	Et.
	casing out of coal area.		BOTTOM	
	Ran coal protection string		678	Et.
	as follows; 1326 ft. of			
	4 1/2" casing; 140 ft. of			
	3 1/2" tubing; Latch down			
	plug at 1294 ft.; Float			
	valve at 1304 ft.; Swedge			
	at 1326 ft. Circulated			
	cement to surface as			
	follows; 990 sacks of			
	Poz Mix; 290 sacks of			
	expanding type cement; 1,000			
	gal. of mud flush. Let			
Coal Seams		Description of Monument		
(Name) Pittsburgh - 1055'	set, bailed dry, set	6 ft. of 4 1/2" casing with		
(Name)	monument.	plaque stating Consol		
(Name)		M1-516.		
(Name)		47-61-0899-P		

RECEIVED
JUN 21 1989
DIVISION OF OIL & GAS
DEPARTMENT OF ENERGY

and that the work of plugging and filling said well was completed on the 26th day of May, 19 89.

And further deponents saith not.

Sworn to and subscribed before me this 15th day of June, 19 89.

Larry L. Yost
Dennis L. Yost
Gelli D. Wilson
Notary Public

My commission expires:
March 15, 1993

JUN 30 1989
Permit No. 47-61-0899-P