


Jamie 6/23/89

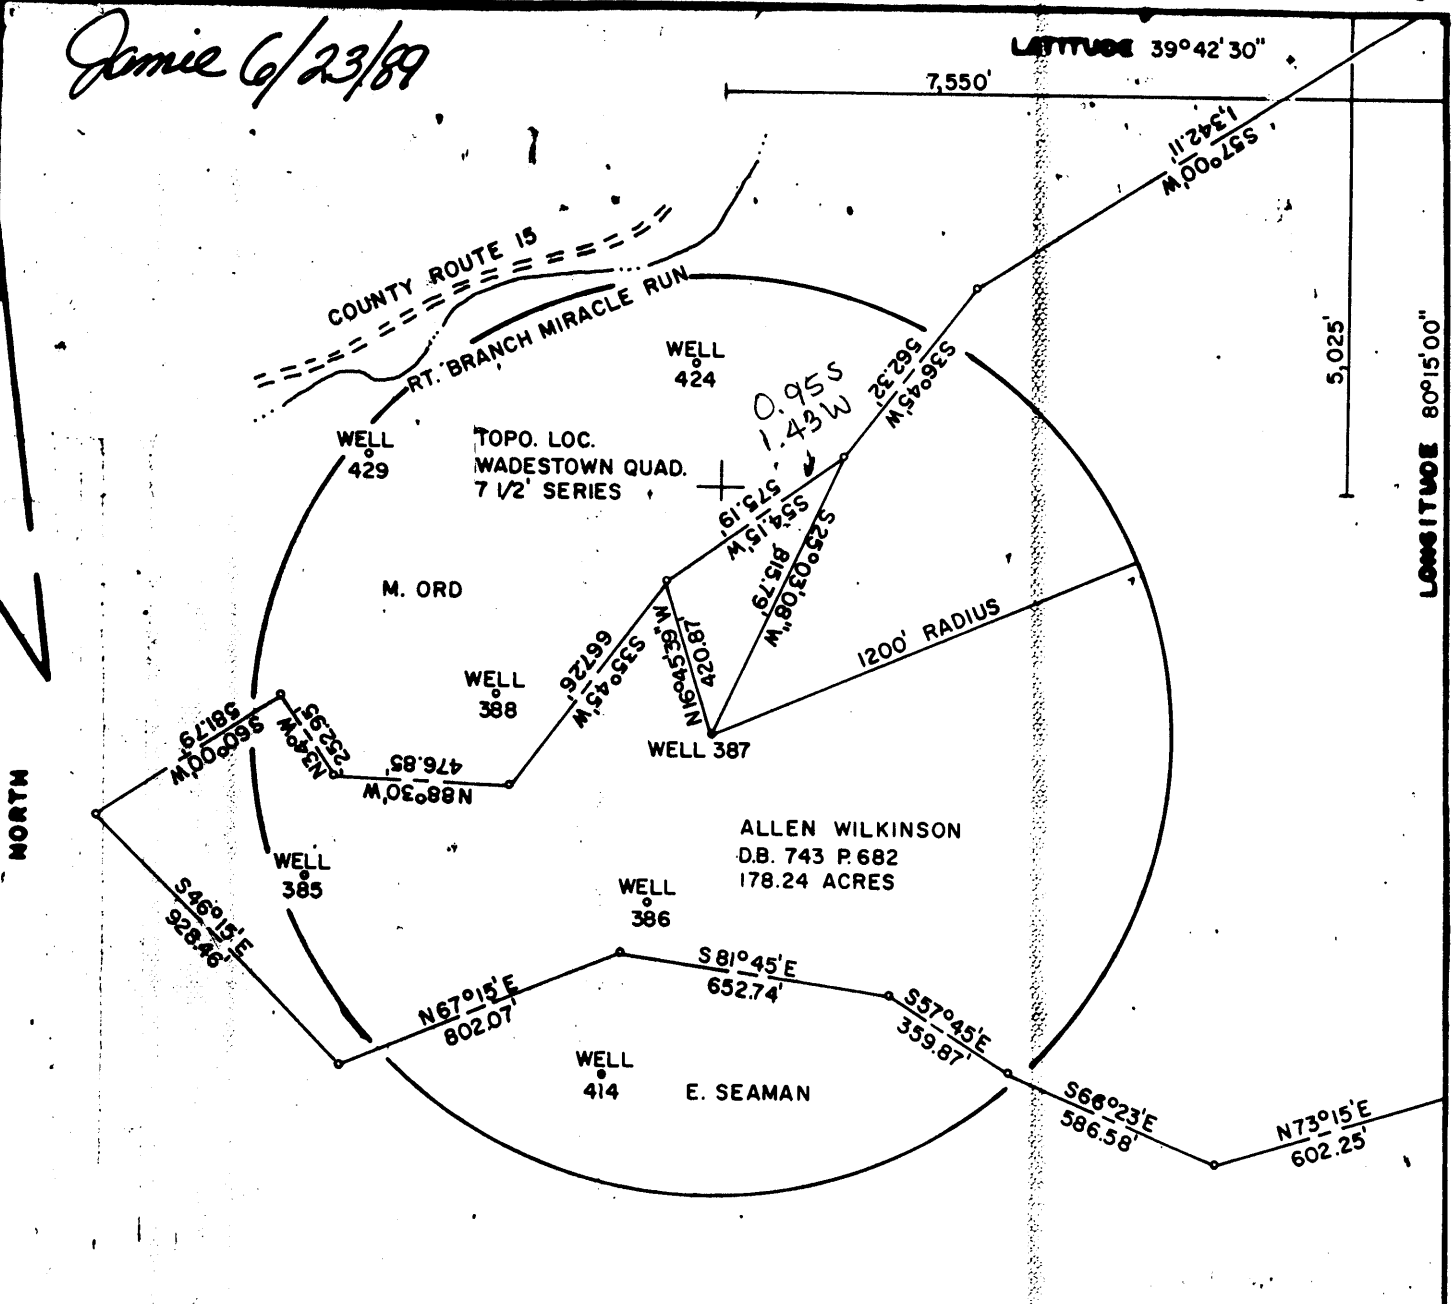


calc. is loc
3.835
1.43W

FILE NO. F2-2-173
DRAWING NO. F2-2-190
SCALE 1" = 500'
MINIMUM DEGREE OF ACCURACY 1/2500
PROVEN SOURCE OF ELEVATION USGS BM

I THE UNDERSIGNED, HEREBY CERTIFY THAT THIS PLAT IS CORRECT TO THE BEST OF MY KNOWLEDGE AND BELIEF AND SHOWS ALL THE INFORMATION REQUIRED BY LAW AND THE REGULATIONS ISSUED AND PRESCRIBED BY THE DEPARTMENT OF MINES.

(SIGNED) Gary Halstead
R.P.E. 9235 L.L.S.

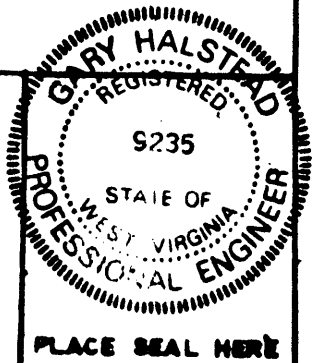

PLACE SEAL HERE

(+) DENOTES LOCATION OF WELL ON UNITED STATES TOPOGRAPHIC MAPS
FORM IV-6
(8-78)



DATE JUNE 6, 19 89
OPERATOR'S WELL NO F2-387
API WELL NO 47 061
STATE 0919 COUNTY PERMIT

STATE OF WEST VIRGINIA
DEPARTMENT OF MINES
OIL AND GAS DIVISION

Plugging

WELL TYPE: OIL & GAS LIQUID INJECTION WASTE DISPOSAL
LIQUID GAS PRODUCTION STORAGE DEEP SHALLOW X
LOCATION: ELEVATION 1380 WATER SHED RIGHT BRANCH MIRACLE RUN
ROUTE 1 BATTLE COUNTY MONONGALIA
QUADRANGLE WADESTOWN 7 1/2' SERIES Mannington no
SURFACE OWNER ALLEN WILKINSON ACREAGE 178.24
OIL & GAS ROYALTY OWNER FORMERLY SOUTH PENN OIL COMPANY LEASE ACREAGE _____
LEASE NO. _____
PROPOSED WORK: WELL CONVERT DRILL DEEPER REDRILL X FRACTURE OR
STIMULATE PLUS OFF OLD FORMATION PERFORATE NEW
FORMATION OTHER PHYSICAL CHANGE IN WELL (SPECIFY) _____

PLUG AND ABANDON X CLEAN OUT AND REFLUG _____
TARGET FORMATION BORDON SAND ESTIMATED DEPTH 3312' JUN 30 1989
WELL OPERATOR EASTERN ASSOC. COAL CORP. DESIGNATED AGENT TERRY O. HENDERSHOT
ADDRESS ROUTE 1 BOX 144 ADDRESS ROUTE 1 BOX 144
FAIRVIEW W. VA 26570 ADDRESS FAIRVIEW W. VA 26570

RECORDED
AUG 09 1989

STATE OF WEST VIRGINIA
DEPARTMENT OF ENERGY
DIVISION OF OIL AND GAS

DIVISION OF OIL & GAS
DEPARTMENT OF ENERGY
AFFIDAVIT OF PLUGGING AND FILLING WELL

AFFIDAVITE SHOULD BE IN TRIPLICATE, one copy mailed to the Division, one copy to be retained by the Well Operator and the third copy (and extra copies if required) should be mailed to each coal operator at their respective addresses.

Farm name: WILKINSON, ALLEN & LYDIA Operator Well No.: F2-387

LOCATION: Elevation: 1360.00 Quadrangle: WADESTOWN
District: BATTELLE County: MONONGALIA
Latitude: 5025 Feet South of 39 Deg. 42 Min. 30 Sec.
Longitude 7550 Feet West of 80 Deg. 15 Min. 0 Sec.

Well Type: OIL X GAS _____

Company: South Penn Oil Company
PO Drawer 1588
Parkersburg, WV 26102

Coal Operator Eastern Assoc. Coal C
or Owner Route 1 Box 144
Fairview, WV 26570

Agent: Terry O. Hendershot
Inspector: Don Ellis
Permit Issued: 06/26/89

Coal Operator Eastern Assoc. Coal C
or Owner Route 1 Box 144
Fairview, WV 26570

AFFIDAVIT

STATE OF WEST VIRGINIA,
County of Monongalia ss:

Jim Gump and Mark Moore being first duly sworn according to law depose and say that they are experienced in the work of plugging and filling oil and gas wells and were employed by Chisler Brothers, well operator, and participated in the work of plugging and filling the above well, that said work was commenced on the 26 day of June, 1989, and that the well was plugged and filled in the following manner:

TYPE	FROM	TO	PIPE REMOVED	LEFT
Cleaned out to 1367'	Run Logs, Gamma Ray, Neutron	& 3 Arm Caliper		
Run 4 1/2" pipe to 1367'	gelled hole with 25 sack gell & 3 sacks paper mulch and got circulation.	Run 200 sack chem comp cement.	pulled 4 1/2" pipe to 1184'.	Pumped
Run 600 sacks Portland cement at 300'	plug set with 700 PS cement at 300'	Run 425 sacks Portland	and got	
latch down plug to 1164'				
Run rubbing tagged circulation				
Boiled water out inside 4 1/2" pipe			and checked plug ok.	
Pittsburgh Coal 1057'	to 1065'			

Description of monument:

and that the work of plugging and filling said well was completed on the 3 day of August, 1989.

And further deponents saith not.

Jim Gump

Mark Moore

Sworn and subscribe before me this 4th day of August, 1989
My commission expires: June 17, 1997

William F. Tuttle
Notary Public

MAY 22 1990