

WW-7  
8-30-06



West Virginia Department of Environmental Protection  
Office of Oil and Gas

**WELL LOCATION FORM: GPS**

API: 47-061-00990 WELL NO.: 5

FARM NAME: Barrackman

RESPONSIBLE PARTY NAME: NNE Resources LLC

COUNTY: Monongalia DISTRICT: Clay

QUADRANGLE: Blacksville, WV

SURFACE OWNER: Mark V. and Betty Eddy

ROYALTY OWNER: Martha E. Barrickman

UTM GPS NORTHING: 4388968.6

UTM GPS EASTING: 574253.0 GPS ELEVATION: 1,280'

The Responsible Party named above has chosen to submit GPS coordinates in lieu of preparing a new well location plat for a plugging permit or assigned API number on the above well. The Office of Oil and Gas will not accept GPS coordinates that do not meet the following requirements:

1. Datum: NAD 1983, Zone: 17 North, Coordinate Units: meters, Altitude: height above mean sea level (MSL) – meters.
2. Accuracy to Datum – 3.05 meters
3. Data Collection Method:

Survey grade GPS  : Post Processed Differential   
Real-Time Differential

Mapping Grade GPS  : Post Processed Differential   
Real-Time Differential

4. Letter size copy of the topography map showing the well location.

I the undersigned, hereby certify this data is correct to the best of my knowledge and belief and shows all the information required by law and the regulations issued and prescribed by the Office of Oil and Gas.

Hollimney  
Signature

Regulatory Manager  
Title

7-13-2018  
Date



RECEIVED  
Office of Oil and Gas

JUL 30 2018

WV Department of  
Environmental Protection



BARRACKMAN NO. 5  
UTM NAD 83:  
EASTING: 574253  
NORTHING: 4388968.6  
ELEVATION: 1280'  
BLACKSVILLE 7.5' USGS QUAD

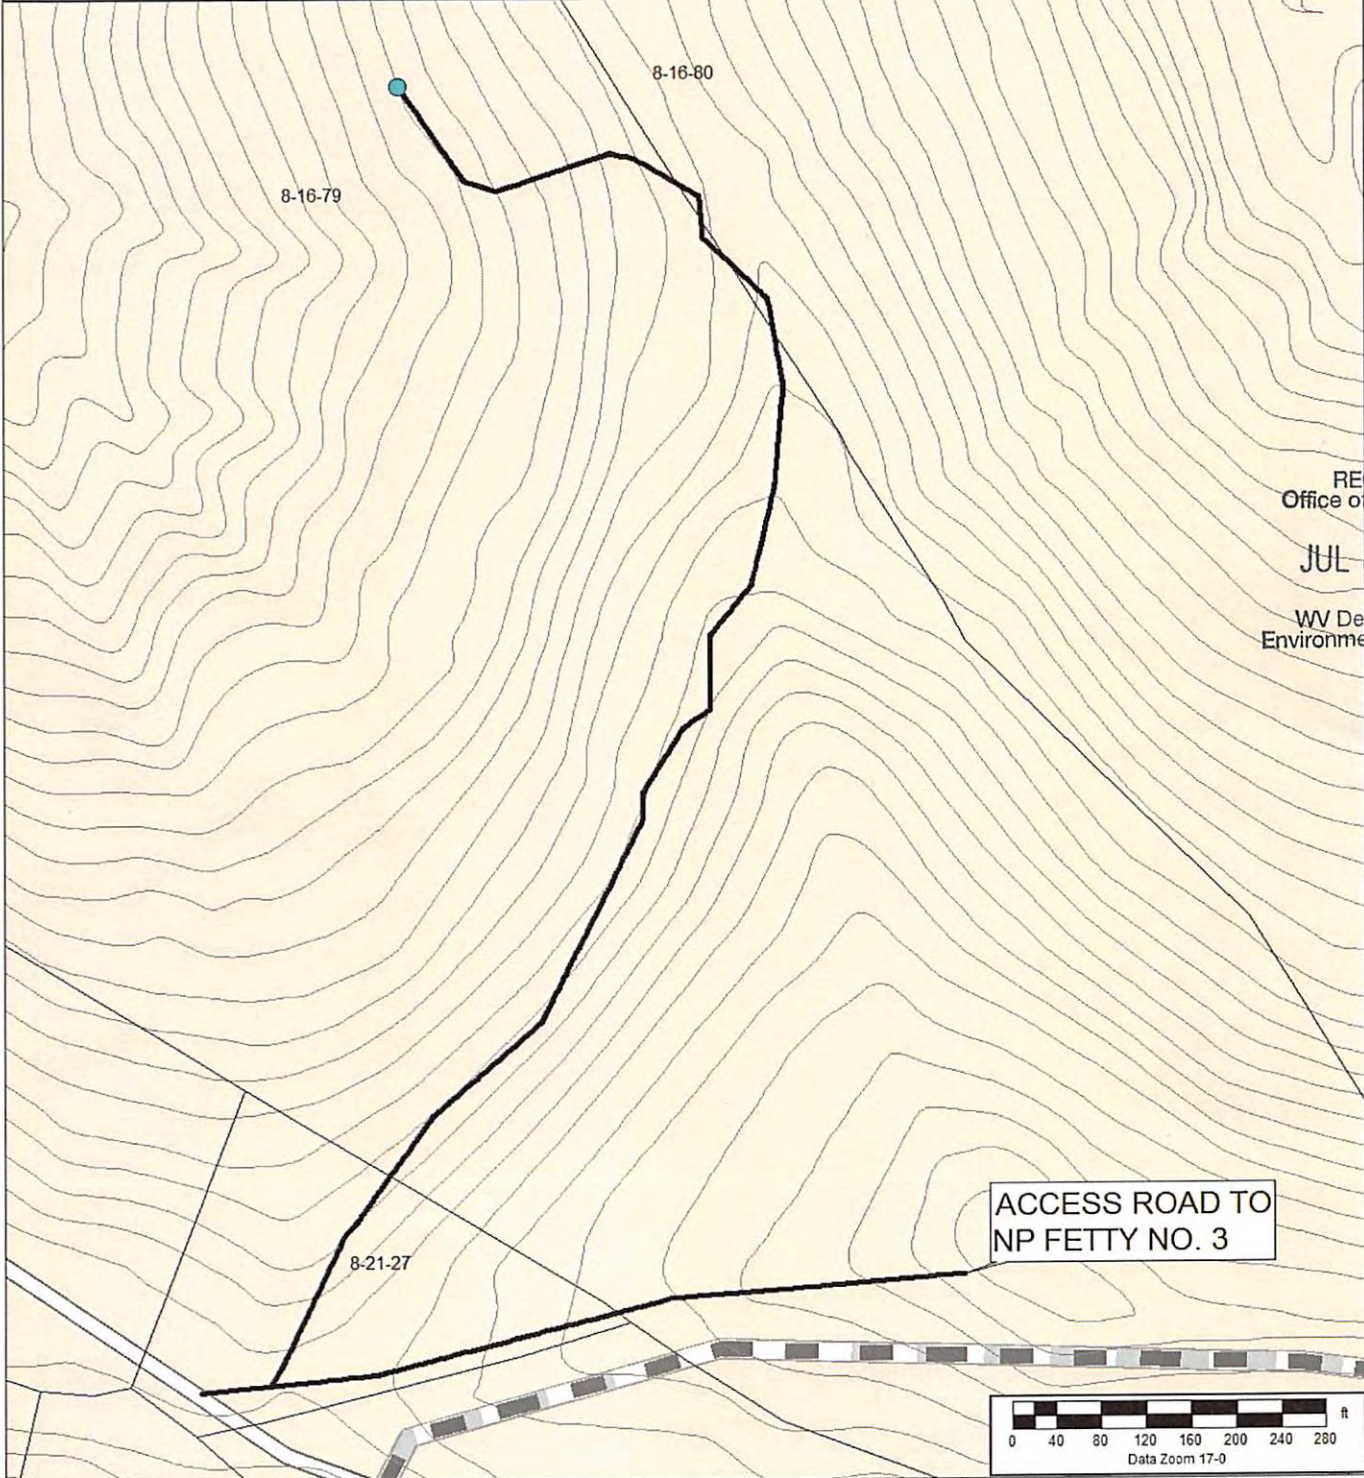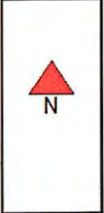

RECEIVED  
Office of Oil and Gas  
JUL 30 2018  
WV Department of  
Environmental Protection