


39° 40'

LATITUDE

5,350

11,450  
LONGITUDE

80° 10'

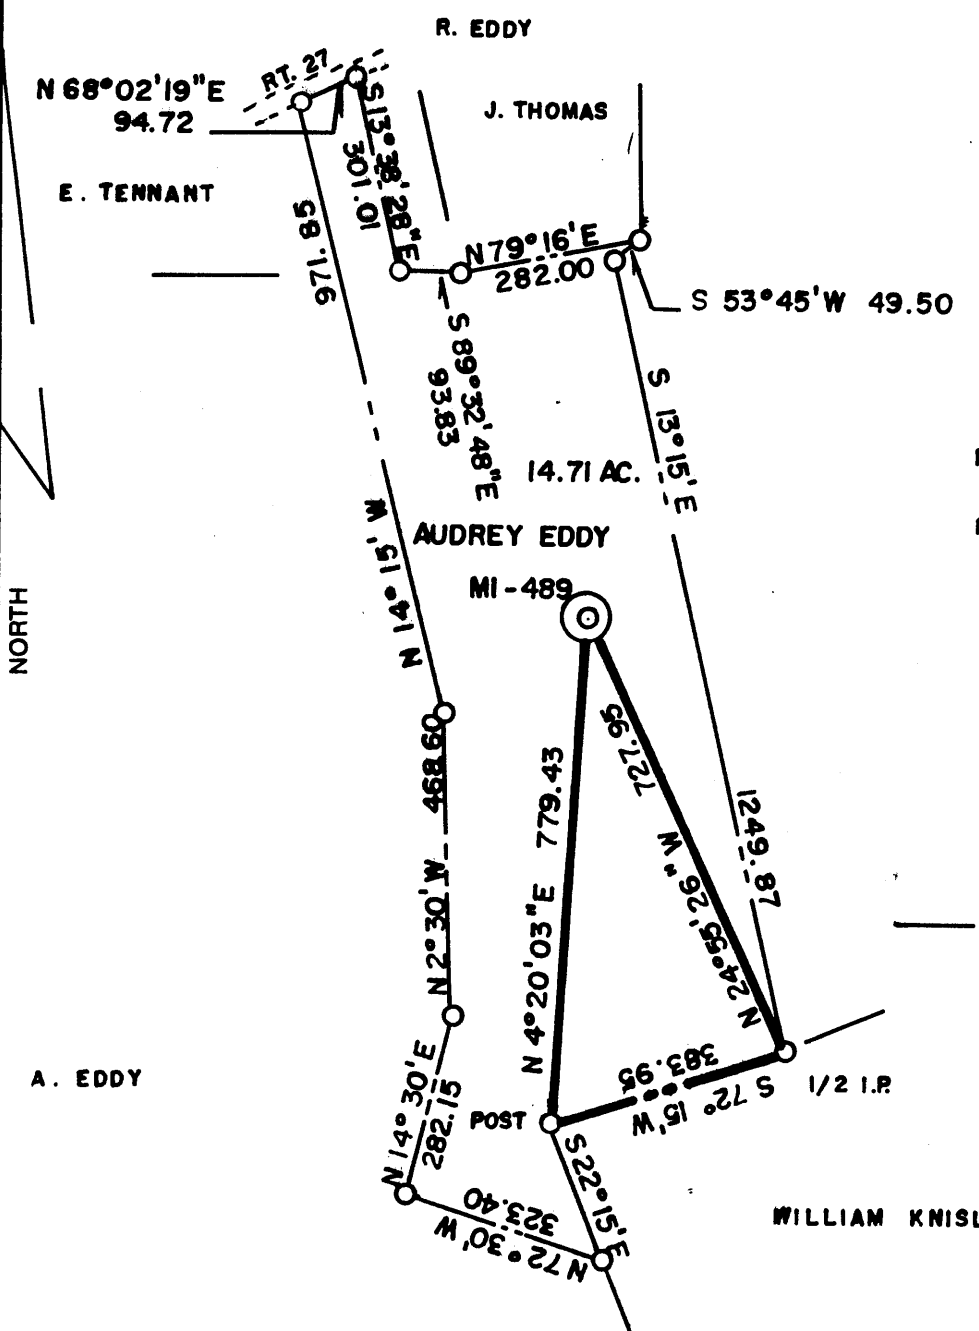

(+) DENOTES LOCATION OF WELL ON UNITED STATES TOPOGRAPHIC MAPS

FILE NO. \_\_\_\_\_  
 DRAWING NO. \_\_\_\_\_  
 SCALE 1" = 300'  
 MINIMUM DEGREE OF ACCURACY 1 IN 5000  
 PROVEN SOURCE OF ELEVATION COMPANY SURVEY TIED INTO U.S.G.S. NETWORK

I THE UNDERSIGNED, HEREBY CERTIFY THAT THIS PLAT IS CORRECT TO THE BEST OF MY KNOWLEDGE AND BELIEF AND SHOWS ALL THE INFORMATION REQUIRED BY LAW AND THE REGULATIONS ISSUED AND PRESCRIBED BY THE DEPARTMENT OF ENERGY.  
 (SIGNED) Paul D. Harbert  
 R.P.E. \_\_\_\_\_ L.L.S. 862



2,205 15'  
1,034

**STATE OF WEST VIRGINIA**  
 DEPARTMENT OF ENERGY  
 OIL AND GAS DIVISION



DATE 4-29, 19 91  
 OPERATOR'S WELL NO. MI-489  
 API WELL NO. 47-61-1034-P

WELL TYPE: OIL \_\_\_ GAS \_\_\_ LIQUID INJECTION \_\_\_ WASTE DISPOSAL \_\_\_  
 (IF "GAS,") PRODUCTION \_\_\_ STORAGE \_\_\_ DEEP \_\_\_ SHALLOW X ABANDONED X PERMIT  
 LOCATION: ELEVATION 1172.19 WATER SHED STATLER RUN  
 DISTRICT CLAY COUNTY MONONGALIA  
 QUADRANGLE BLACKVILLE WV, PA  
 SURFACE OWNER AUDREY E. EDDY ACREAGE 14.71  
 OIL & GAS ROYALTY OWNER \_\_\_\_\_ LEASE ACREAGE \_\_\_\_\_

PROPOSED WORK: DRILL \_\_\_ CONVERT \_\_\_ DRILL DEEPER \_\_\_ REDRILL \_\_\_ FRACTURE OR STIMULATE \_\_\_ PLUG OFF OLD FORMATION \_\_\_ PERFORATE NEW FORMATION \_\_\_ OTHER PHYSICAL CHANGE IN WELL (SPECIFY) \_\_\_\_\_

PLUG AND ABANDON \_\_\_ CLEAN OUT AND REPLUG X ESTIMATED DEPTH \_\_\_\_\_  
 TARGET FORMATION NONE  
 WELL OPERATOR CONSOLIDATION COAL CO. DESIGNATED AGENT ROGER E. DUCKWORTH  
 ADDRESS P.O. BOX 1314 MORGANTOWN WV 26505 ADDRESS P.O. BOX 1314 MORGANTOWN WV 26505

AUG 5 1991

FORM WW-6 HALLS INC. 068965

COUNTY NAME PERMIT

RECEIVED  
OCT 16 1991

AFFIDAVIT OF PLUGGING AND FILLING WELL

FIDAVIT SHOULD BE MADE IN TRIPLICATE, one copy mailed to the Division, one copy to be retained by the Well Operator and the third copy (and extra copies if required) should be mailed to each coal operator at their respective addresses.

Consolidation Coal Co.  
Coal Operator or Owner  
O. Box 1314 Morgantown, W. Va.  
Address

Consolidation Coal Co.  
Name of Well Operator  
P.O. Box 1314 Morgantown, WV. 26507  
Complete Address

Consolidation Coal Co.  
Coal Operator or Owner  
O. Box 1314 Morgantown, W. Va. 26507  
Address

August 29 19 91  
WELL AND LOCATION  
Clay District

Audrey Eddy  
Lease or Property Owner  
Address

Monongalia County  
WELL NO. M1-489  
Audrey Eddy Farm

STATE INSPECTOR SUPERVISING PLUGGING Don Ellis

AFFIDAVIT

STATE OF WEST VIRGINIA,  
County of Monongalia

ss:

Larry L. Yost and Dennis L. Yost

being first duly sworn according to law depose and say that they are experienced in the work of plugging and filling oil and gas wells and were employed by Consolidation Coal Co., well operator, and participated in the work of plugging and filling the above well, that said work was commenced on the 5th day of August 19 91, and that the well was plugged and filled in the following manner:

Sand or Zone Record Formation	Filling Material	Plugs Used Size & Kind	Casing	
			CSG PULLED	CSG LEFT IN
	Pulled 622 ft. of 2 3/8" tubing. Cemented solid from 620 ft. to surface with 500 sacks of cement.	2 3/8"	622	
Coal Seams				
(Name) Pittsburgh-	622 ft.	6 ft. of 4 1/2" casing with plaque stating Consol		
(Name)		M1-489.		
(Name)		37-61-1034-P		

and that the work of plugging and filling said well was completed on the 26th day of August, 19 91.

And further deponents saith not.

*Larry L. Yost*  
*Dennis L. Yost*

Sworn to and subscribed before me this 30th day of Sept, 19 91

*William H. Wilborn*  
Notary Public

My commission expires: March 15, 1993