well spot

190 (7, 50 "

Longitude

30/77-

Topo Location

7.5' Loc. <u>0.365</u> 15' Loc. <u>3.245</u> <u>0.01W</u> (calc.) <u>2.23W</u>

Company/Numeron Corp.

Farm I. M. John 415

15' Quad Mozantown (NW)


(sec.)

7.5' Quad Mozantown Inth

District ass

WELL LOCATION PLAT

County 061 Permit 1149N

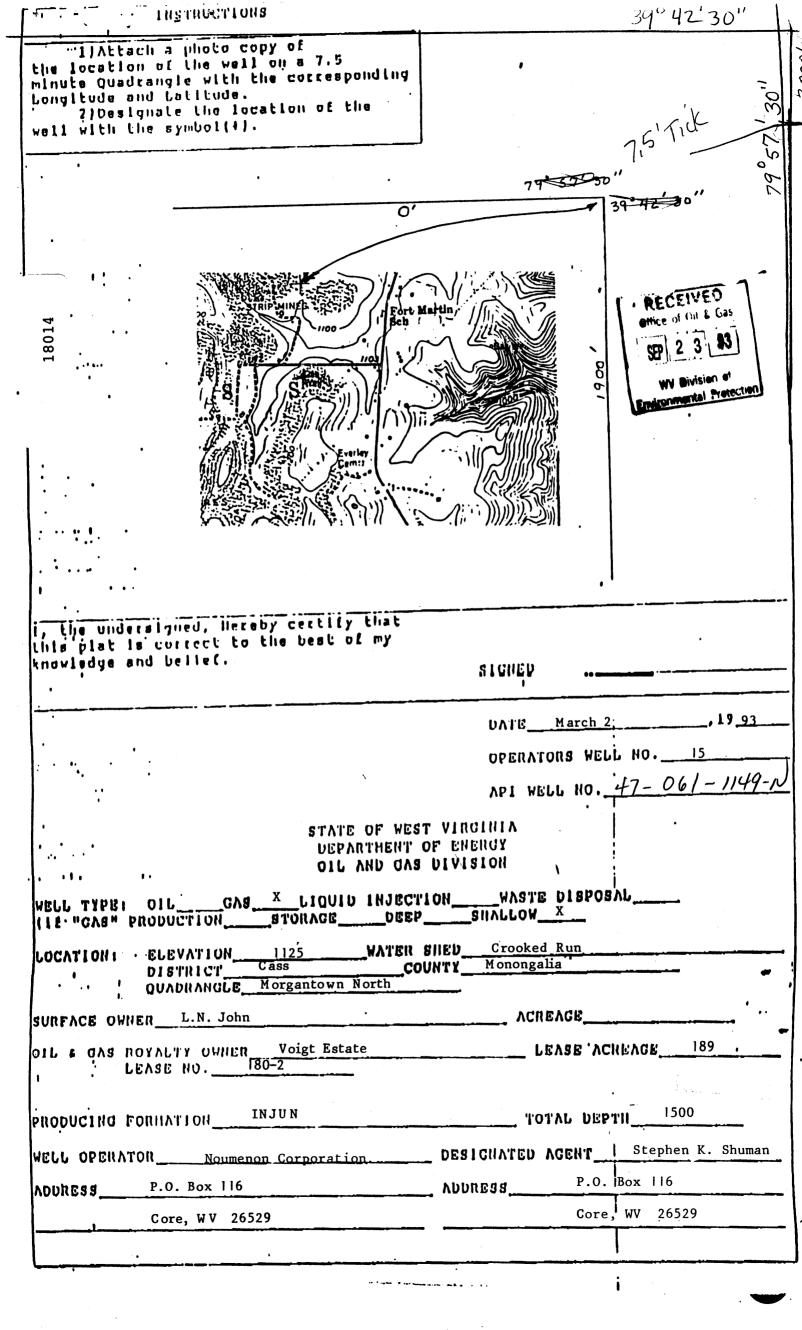

STATE OF WEST VIRGINIA DIVISION OF ENVIRONMENTAL PROTECTION SECTION OF OIL AND GAS

WELL REGISTER ASSIGNMENT

This API Number 47-61-01149, issued to NOUMENON CORPORATION, a W.VA. is evidence of permission to operate the well that is referenced at the location described on the attached plat, subject to the provisions of Chapters 22 and 22B of the West Virginia Code of 1931, as amended, and all rules and regulations promulgated thereunder. The name and telephone number of the Oil and Gas Inspector for this well is RANDAL MICK - 304-986-3324.

Spills or emergency discharges must be reported to 1-800-654-3312.

Failure to abide by all statutory and regulatory provisions governing all duties and operations hereunder may result in suspension or revocation of your permits and in addition may result in civil and/or criminal penalties.

The enclosed WR-35 must be completed by you and returned to this office. In addition annual production reports must be submitted on this well and failure to do so may require you to plug the well.

Theodore M. Streit Chief

By: TH - 66

Title:	
--------	--

Operator's Well No: 15

Farm Name: JOHN, L. N.

API Well Number: 47- 61-01149 N

Date Issued : 03/10/94