

Latitude

39° 42' 30"

79° 57' 30"

Longitude

70116

Topo Location

7.5' Loc. 1.235 15' Loc. 4.115
0.52W (calc.) 2.74W

Company Norman Corp.

Farm M. Van Voorhis #1 #87

15' Quad Morganston (NW)
(sec.)

7.5' Quad Morganston North

District Cass

WELL LOCATION PLAT

County 061 Permit 1150N

1) Attach a photo copy of the location of the well on a 7.5 minute Quadrangle with the corresponding longitude and latitude.

2) Designate the location of the well with the symbol (1).

2250'


79° 57' 30"

39° 42' 30"

79° 57' 30"

6300'

18018

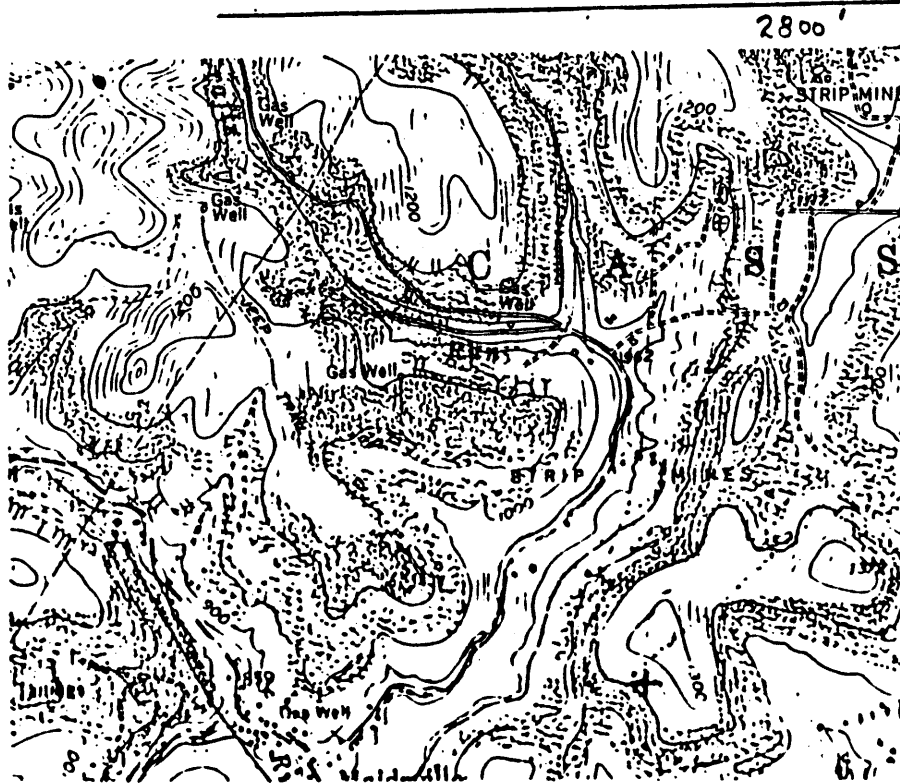

RECEIVED
Office of ... & ...
2 3 93
WV Division of
Environmental Protection

7.5' ticks

I, the undersigned, hereby certify that this plot is correct to the best of my knowledge and belief

SIGNED

DATE March 2, 1993

OPERATORS WELL NO. 1

API WELL NO. 47-061-1150-N

STATE OF WEST VIRGINIA
DEPARTMENT OF ENERGY
OIL AND GAS DIVISION

WELL TYPE: OIL _____ GAS _____ X LIQUID INJECTION _____ WASTE DISPOSAL _____
(IE "GAS" PRODUCTION) STORAGE _____ DEEP _____ SHALLOW _____

LOCATION: ELEVATION 1240 WATER SHED Monongahela River
DISTRICT Cass COUNTY Monongalia
QUADRANGLE Morgantown North

SURFACE OWNER M. Van Voorhis ACREAGE 135

OIL & GAS TOTALITY OWNER _____ LEASE ACREAGE 135
LEASE NO. _____

PRODUCING FORMATION INJUN TOTAL DEPTH _____

WELL OPERATOR Noumenon Corporation DESIGNATED AGENT Stephen K. Shuman

ADDRESS P.O. Box 116 ADDRESS P.O. Box 116
Core, WV 26529 Core, WV 26529

STATE OF WEST VIRGINIA
DIVISION OF ENVIRONMENTAL PROTECTION
SECTION OF OIL AND GAS

WELL REGISTER ASSIGNMENT

This API Number 47- 61-01150, issued to NOUMENON CORPORATION, a W.VA. is evidence of permission to operate the well that is referenced at the location described on the attached plat, subject to the provisions of Chapters 22 and 22B of the West Virginia Code of 1931, as amended, and all rules and regulations promulgated thereunder. The name and telephone number of the Oil and Gas Inspector for this well is RANDAL MICK -
304-986-3324.

Spills or emergency discharges must be reported to 1-800-654-3312.

Failure to abide by all statutory and regulatory provisions governing all duties and operations hereunder may result in suspension or revocation of your permits and in addition may result in civil and/or criminal penalties.

The enclosed WR-35 must be completed by you and returned to this office. In addition annual production reports must be submitted on this well and failure to do so may require you to plug the well.

Theodore M. Streit
Chief

By: 

Title: _____

Operator's Well No: VOORHIS #1#87

Farm Name: VOORHIS, M. VAN

API Well Number : 47- 61-01150 N

Date Issued : 03/10/94

--	--	--