

39° 45' 00"

Latitude ✓

02, 22, 08

Longitude

Topo Location

7.5' Loc. 2.055 15' Loc. 2.055
1.14W (calc.) 3.36W

Company Greenridge Oil Co.
Farm A.R. Renner #1
15' Quad Mannington (NC)
(sec.)
7.5' Quad Hundred
District Battelle

WELL LOCATION PLAT


County 061 Permit 1154N

1) Attach a photo copy of the location of the well on a 7.5 minute Quadrangle with the corresponding longitude and Latitude.

2) Designate the location of the well with the symbol (+).

6600
39°45'

80°22'30"

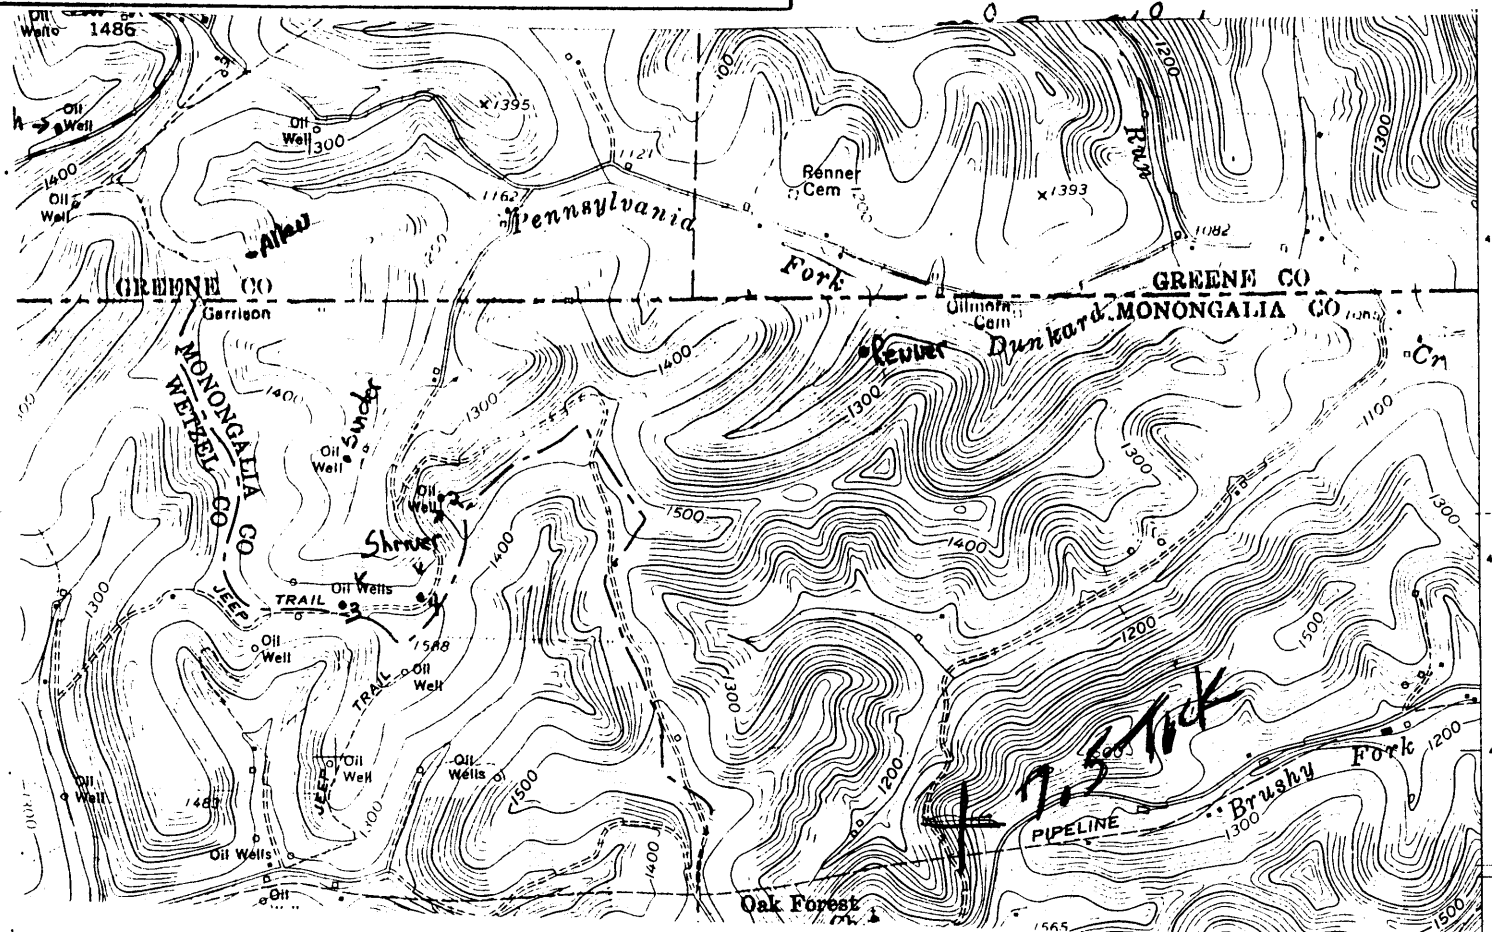

I, the undersigned, hereby certify that this plat is correct to the best of my knowledge and belief.

RECEIVED
Department of Environmental Protection

SIGNED Ralph J. Condit
TITLE President

Well NAME: A.R. Renner

JUN 26 93
Permitting
Office of Oil & Gas

DATE 1/15, 1993

OPERATORS WELL NO. 1

API WELL NO. 47-061-1154-N

18930
2894
Permitting
Office of Oil & Gas

STATE OF WEST VIRGINIA
DEPARTMENT OF ENERGY
OIL AND GAS DIVISION

TYPE: OIL GAS LIQUID INJECTION WASTE DISPOSAL
PRODUCTION STORAGE DEEP SHALLOW

LOCATION: ELEVATION 1180 est WATER SHED Dunkard Creek
DISTRICT Buttelle COUNTY Monongalia
QUADRANGLE 25X42-30

LAND SURFACE OWNER _____ ACREAGE _____
& GAS ROYALTY OWNER _____ LEASE ACREAGE 30
LEASE NO. _____

PRODUCING FORMATION 4th Sand TOTAL DEPTH 3213

LAND OPERATOR Greenridge Oil Co DESIGNATED AGENT John Lavelle
ADDRESS R.D.#1 Box 2676 ADDRESS RD 1 Box 72
New Freeport PA. 15352 Knob Fork, WV 26579

19970

STATE OF WEST VIRGINIA
DIVISION OF ENVIRONMENTAL PROTECTION
SECTION OF OIL AND GAS

WELL REGISTER ASSIGNMENT

This API Number 47- 61-01154, issued to GREENRIDGE OIL, INC. is evidence of permission to operate the well that is referenced at the location described on the attached plat, subject to the provisions of Chapters 22 and 22B of the West Virginia Code of 1931, as amended, and all rules and regulations promulgated thereunder. The name and telephone number of the Oil and Gas Inspector for this well is RANDAL MICK 304-986-3324.

Spills or emergency discharges must be reported to 1-800-654-3312.

Failure to abide by all statutory and regulatory provisions governing all duties and operations hereunder may result in suspension or revocation of your permits and in addition may result in civil and/or criminal penalties.

The enclosed WR-35 must be completed by you and returned to this office. In addition annual production reports must be submitted on this well and failure to do so may require you to plug the well.

Theodore M. Streit
Chief

By: T. Streit

Title: _____

Operator's Well No: 1

Farm Name: RENNER, A.R.

API Well Number : 47- 61-01154 N

Date Issued : 05/02/94

--	--	--