

6101154P

WW-7
8-30-06



West Virginia Department of Environmental Protection
Office of Oil and Gas
WELL LOCATION FORM: GPS

API: 47-061-01154 WELL NO.: 1

FARM NAME: Renner

RESPONSIBLE PARTY NAME: Gerald Ramsburg

COUNTY: Monongalia DISTRICT: Battelle

QUADRANGLE: Hundred

SURFACE OWNER: SHIPMAN R ALLAN

ROYALTY OWNER: _____

UTM GPS NORTHING: 4,396,895.043 METERS

UTM GPS EASTING: 551,021.441 METERS GPS ELEVATION: 376.763 METERS (236')

The Responsible Party named above has chosen to submit GPS coordinates in lieu of preparing a new well location plat for a plugging permit or assigned API number on the above well. The Office of Oil and Gas will not accept GPS coordinates that do not meet the following requirements:

- Datum: NAD 1983, Zone: 17 North, Coordinate Units: meters, Altitude: height above mean sea level (MSL) – meters.
- Accuracy to Datum – 3.05 meters
- Data Collection Method:
Survey grade GPS x : Post Processed Differential X
Real-Time Differential _____

RECEIVED
Office of Oil and Gas
JUL 13 2017
WV Department of
Environmental Protection

Mapping Grade GPS _____ : Post Processed Differential _____
Real-Time Differential _____

4. **Letter size copy of the topography map showing the well location.**


I the undersigned, hereby certify this data is correct to the best of my knowledge and belief and shows all the information required by law and the regulations issued and prescribed by the Office of Oil and Gas.

Gerald W. Ramsburg
Signature

General Manager
Title

6/13/17
Date

08/04/2017

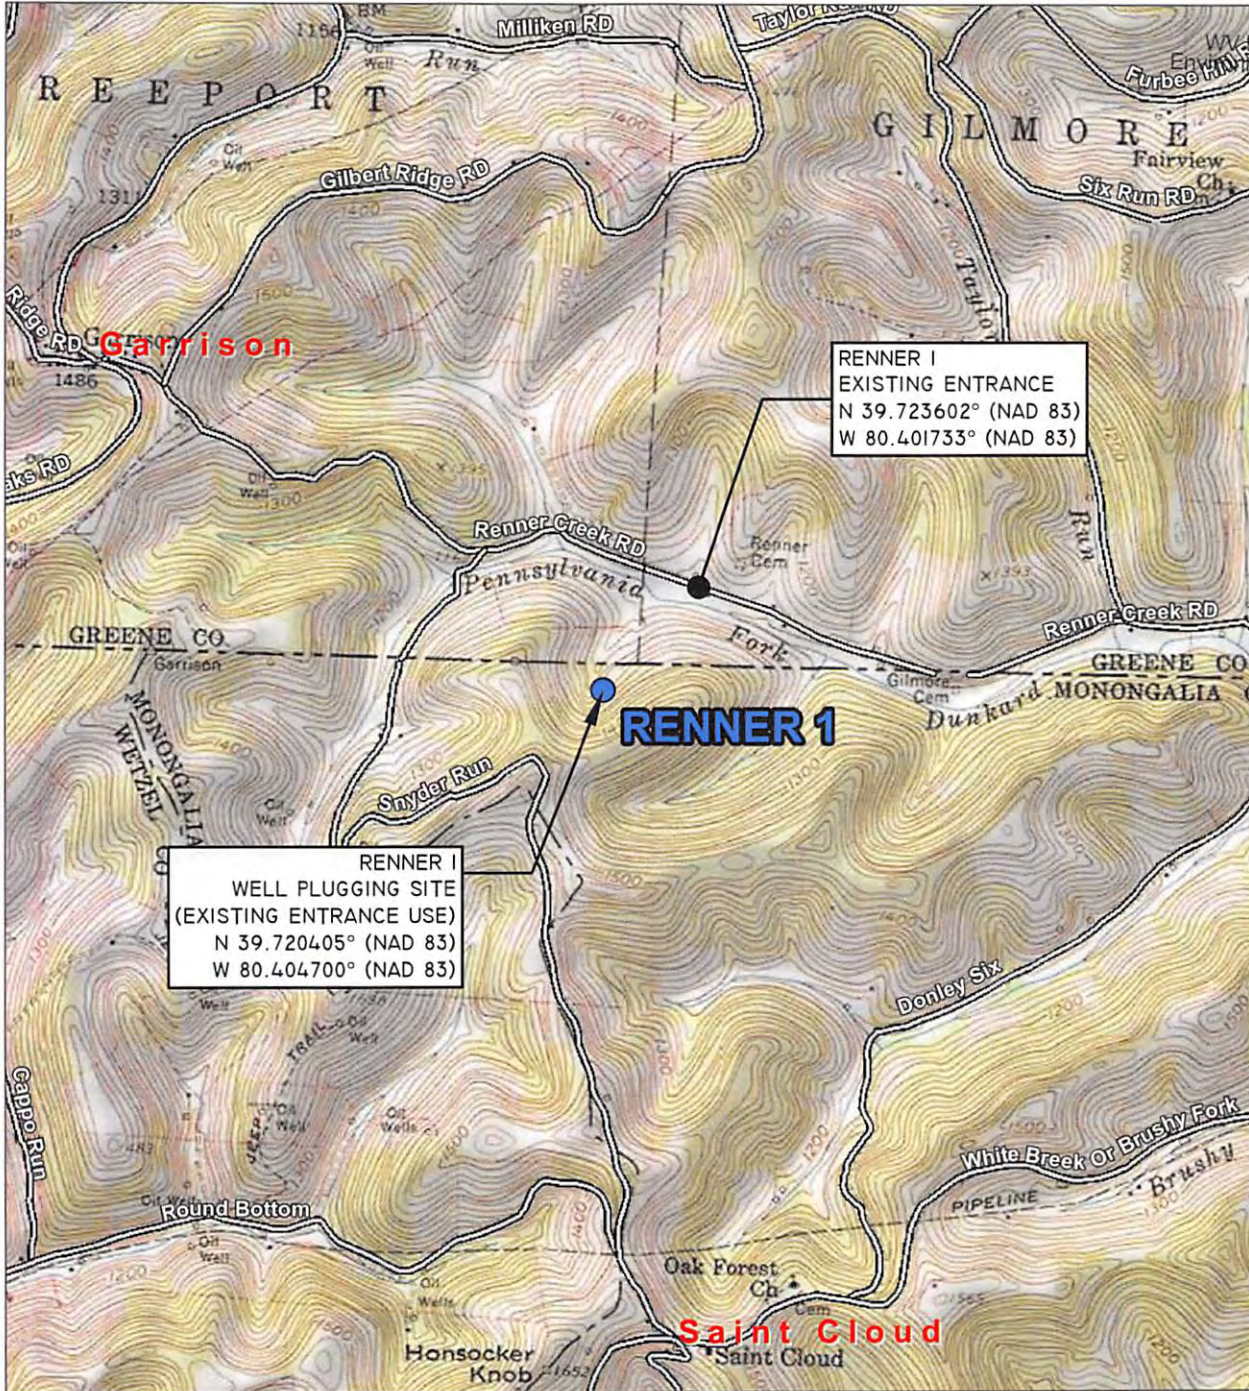

LOCATION MAP
HUNDRED, WV 7.5M USGS QUADRANGLE
SCALE: 1"=2000'



Blue Mountain Inc.
Engineers and Land Surveyors
Woman Owned Small Business
11023 Mason Dixon Hwy.
Burton, WV 26562-9656
(304) 662-6486

LOCATION MAP
GAS WELL PLUGGING
RENNER I GAS WELL
BATTELLE DISTRICT
MONONGALIA COUNTY, WV
LEATHERWOOD, INC.
200 HALLAM ROAD
WASHINGTON, PA 15301

DRAWN BY: LLF
CHECKED BY: WPF
DATE: 06/02/2017
SCALE: 1"=2000'
WATERSHED: PENNSYLVANIA FORK-DUNKARD CREEK
PAGE 4 OF 4